


SECTION 19 T36S. R2W. W.M.
JACKSON COUNTY

1" = 400'

THIS MAP WAS PREPARED FOR
ASSESSMENT PURPOSE ONLY

Reference
Corner

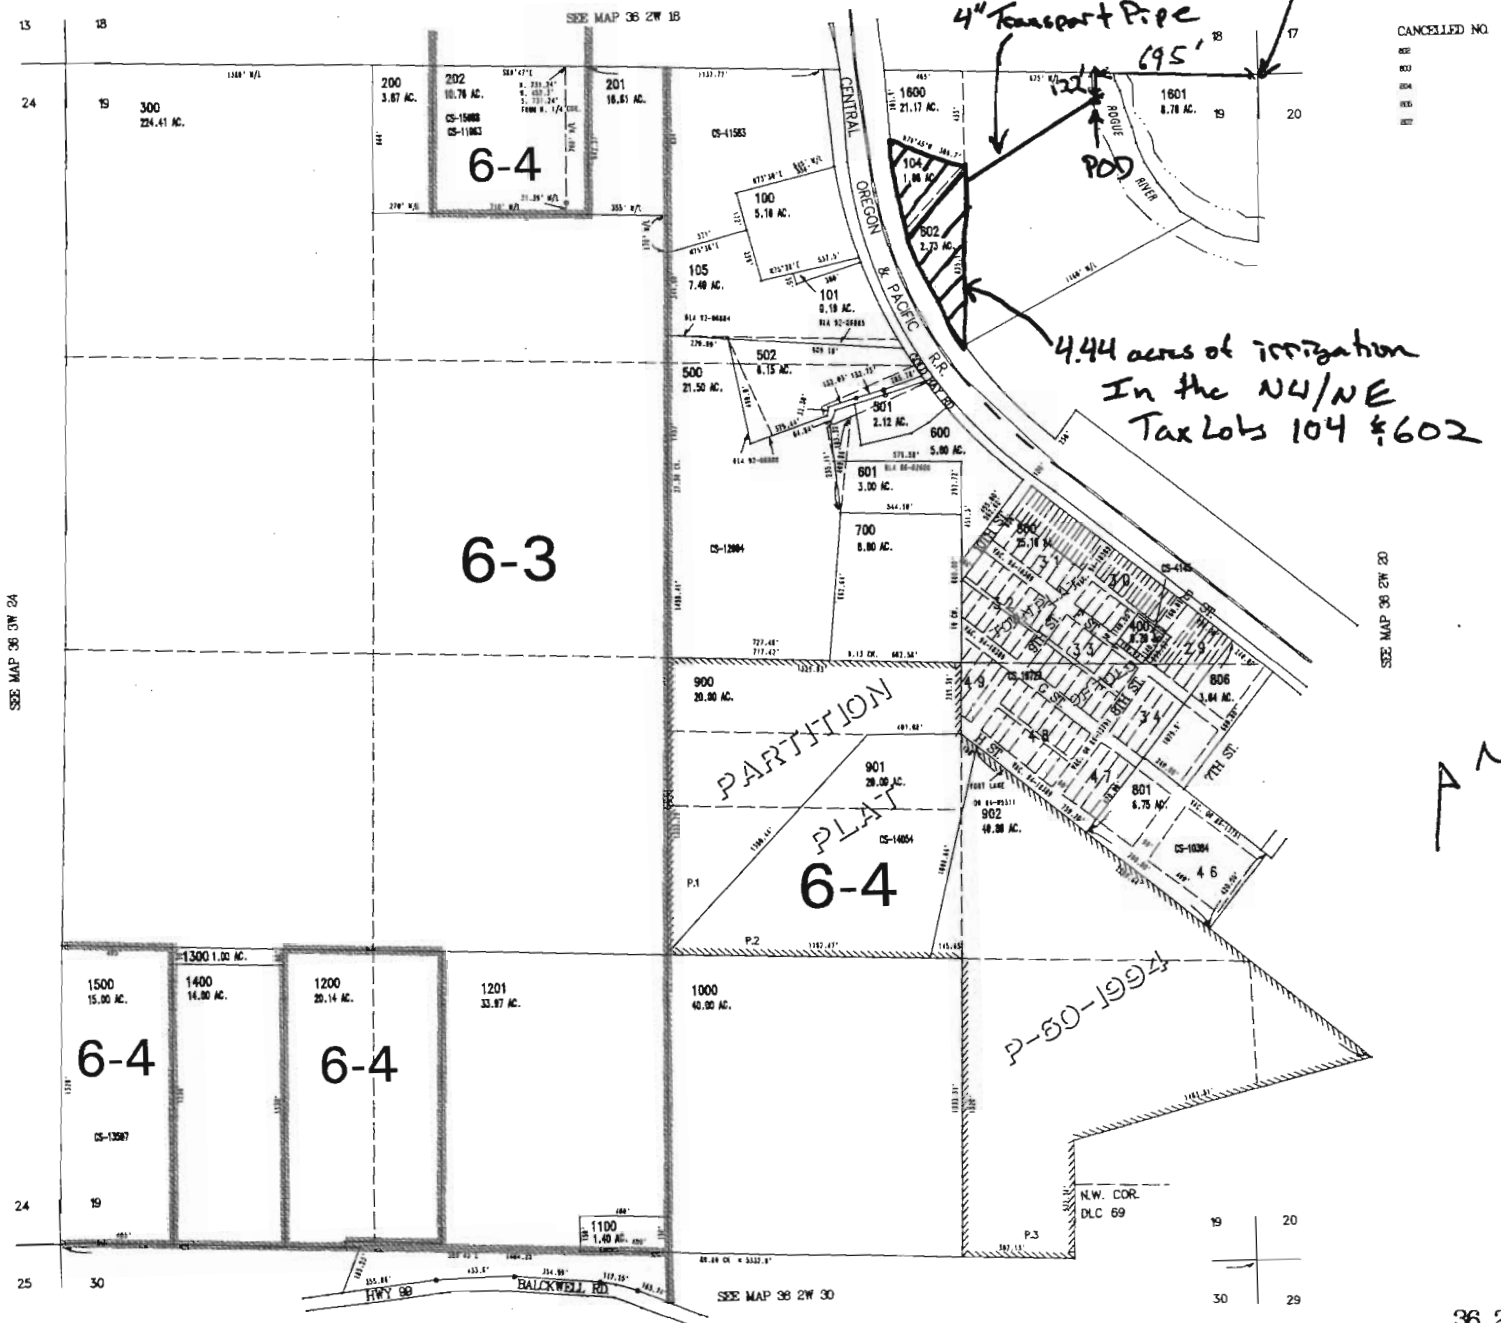

CANCELLED NO.

20707

METAFILE K:\MAP\362W\19\0\00 PLAT.ORA
CREATED WEDNESDAY AUGUST 08, 2007 11:32 AM By CRAWFORD


RECEIVED
MAR 21 2011
WATER RESOURCES DEPT
SALEM, OREGON

THIS MAP WAS PREPARED FOR ASSESSMENT PURPOSE ONLY

SECTION 19 T36S. R2W. WM JACKSON COUNTY

Revised Corrected Approx SCALE 1" = 600 FEET

Reference Corner

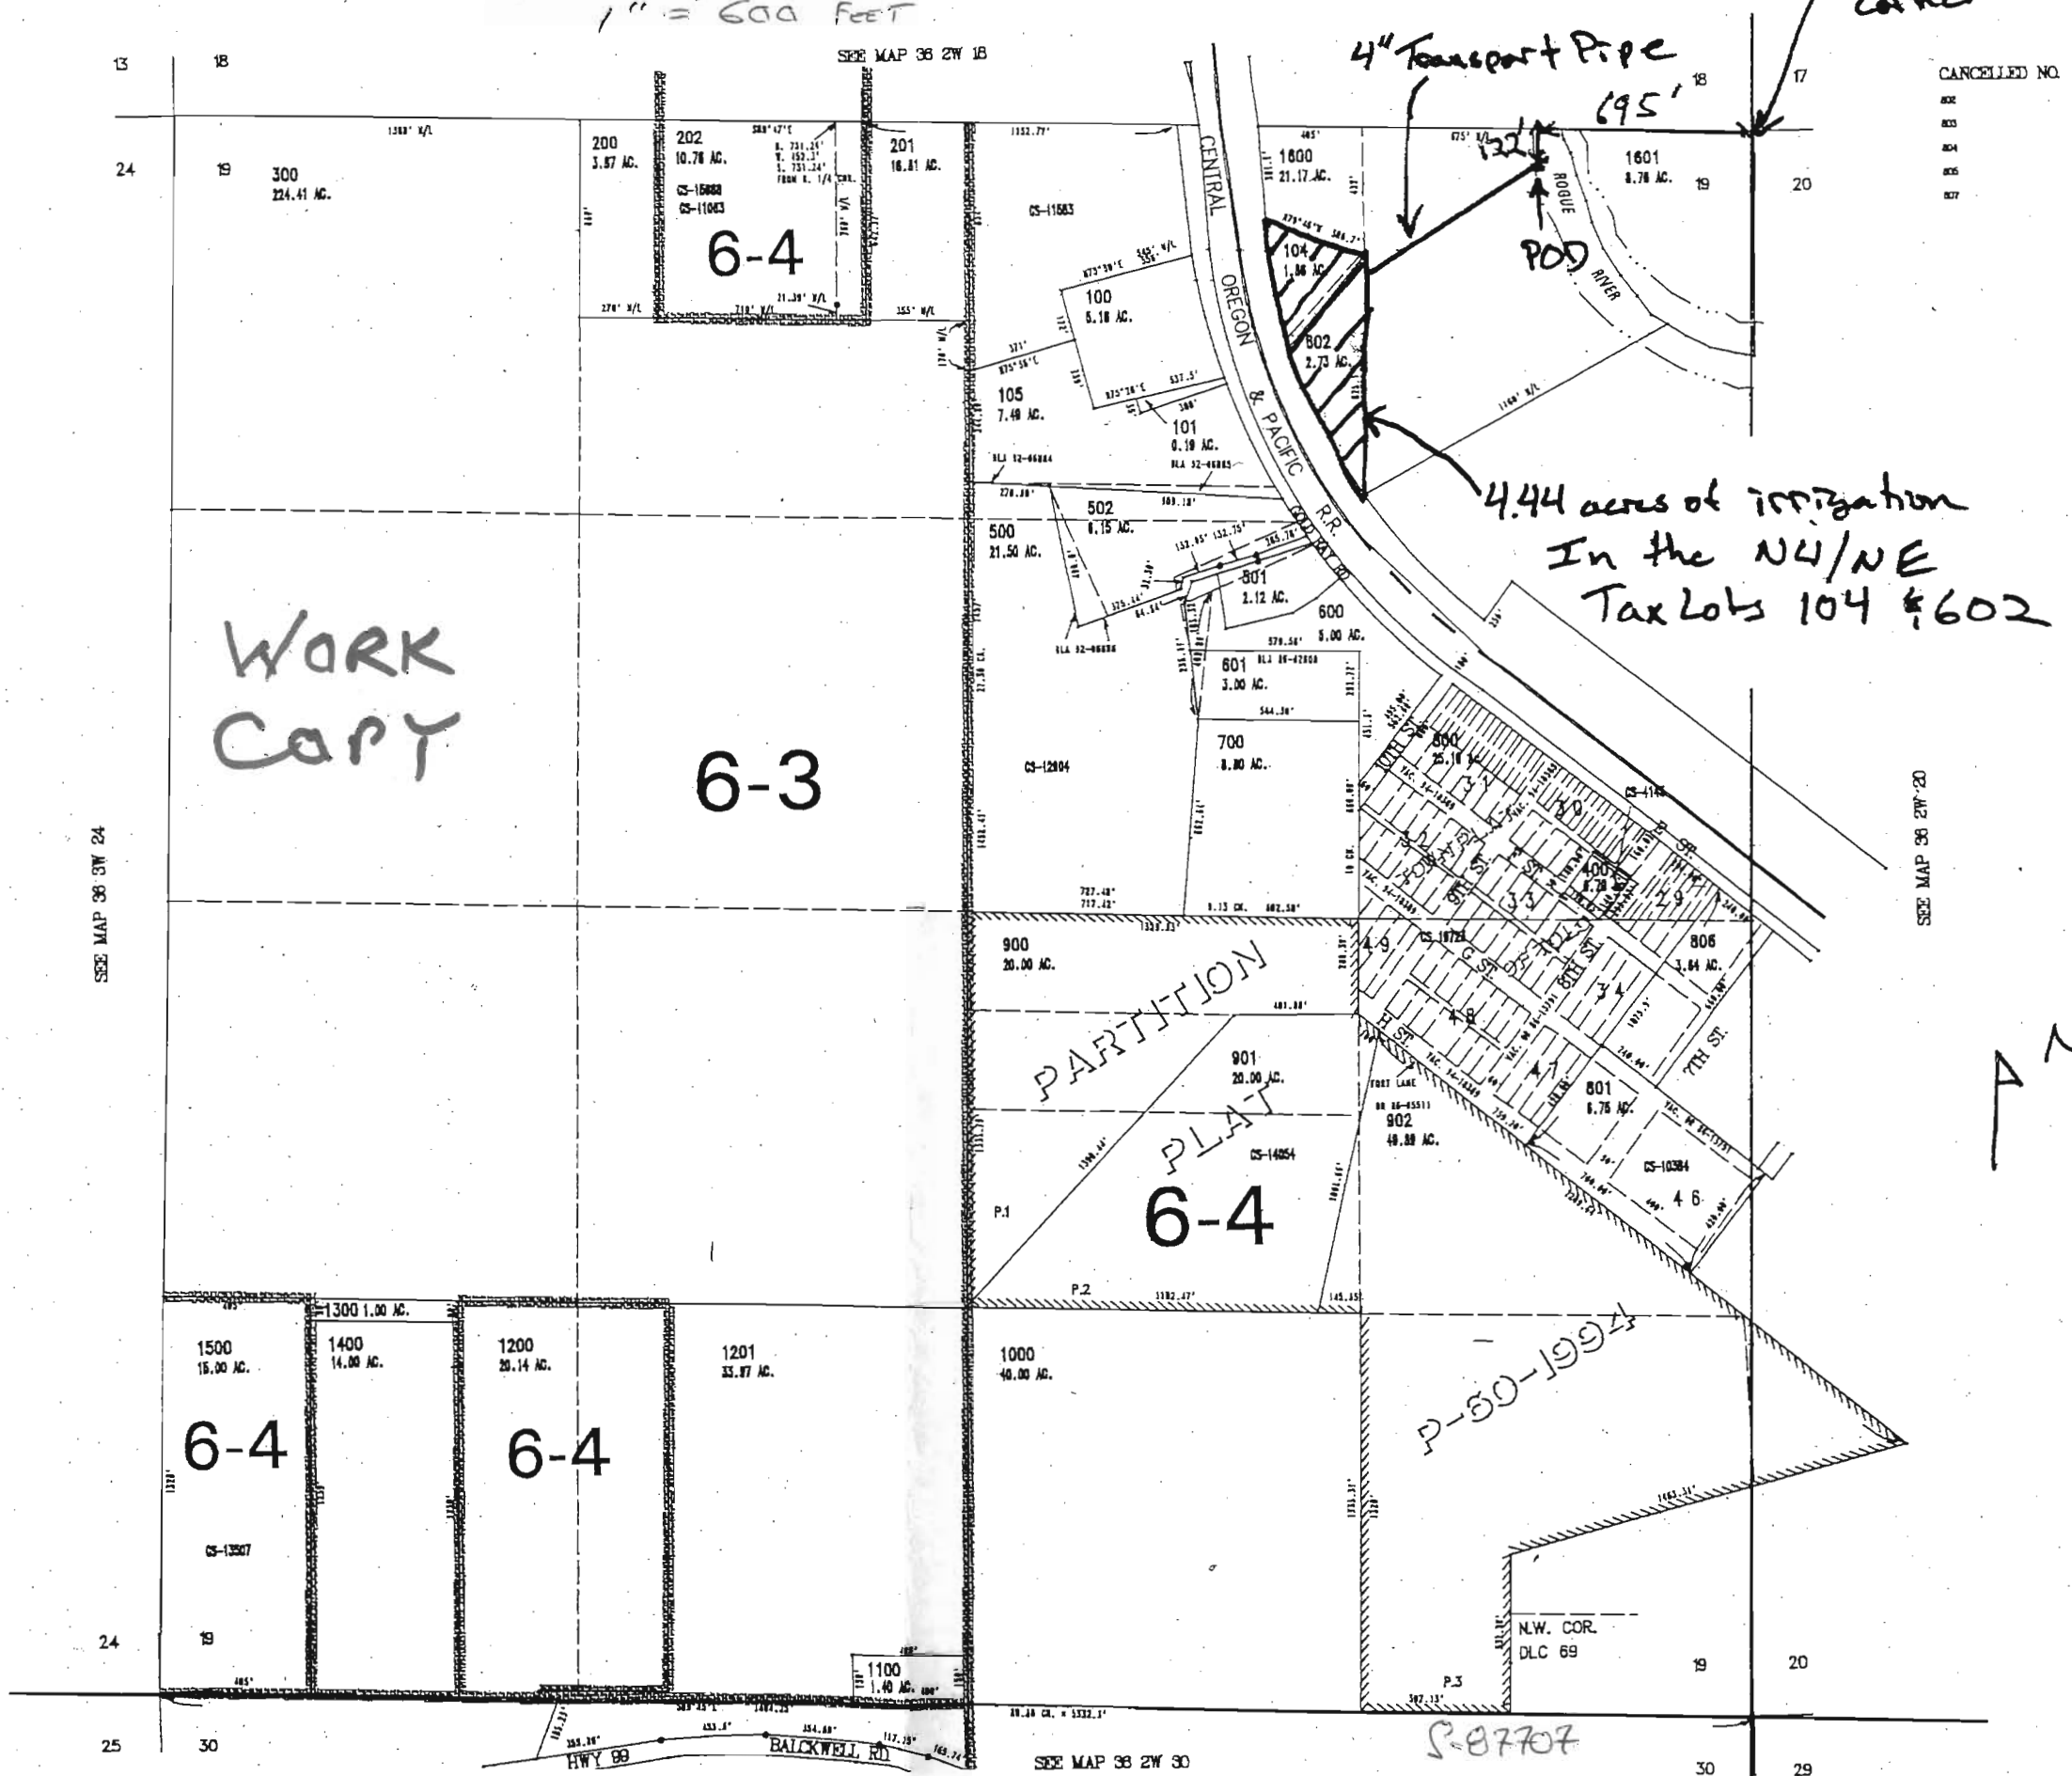

CANCELLED NO. 802 803 804 805 807

WORK COPY

4.44 acres of irrigation In the NW/NE Tax Lots 104 & 602

4" Transport Pipe 195'

P-80-1992

P-87707

A 2.

RECEIVED
MAR 21 2011
WATER RESOURCES I
SALEM, OREGON