



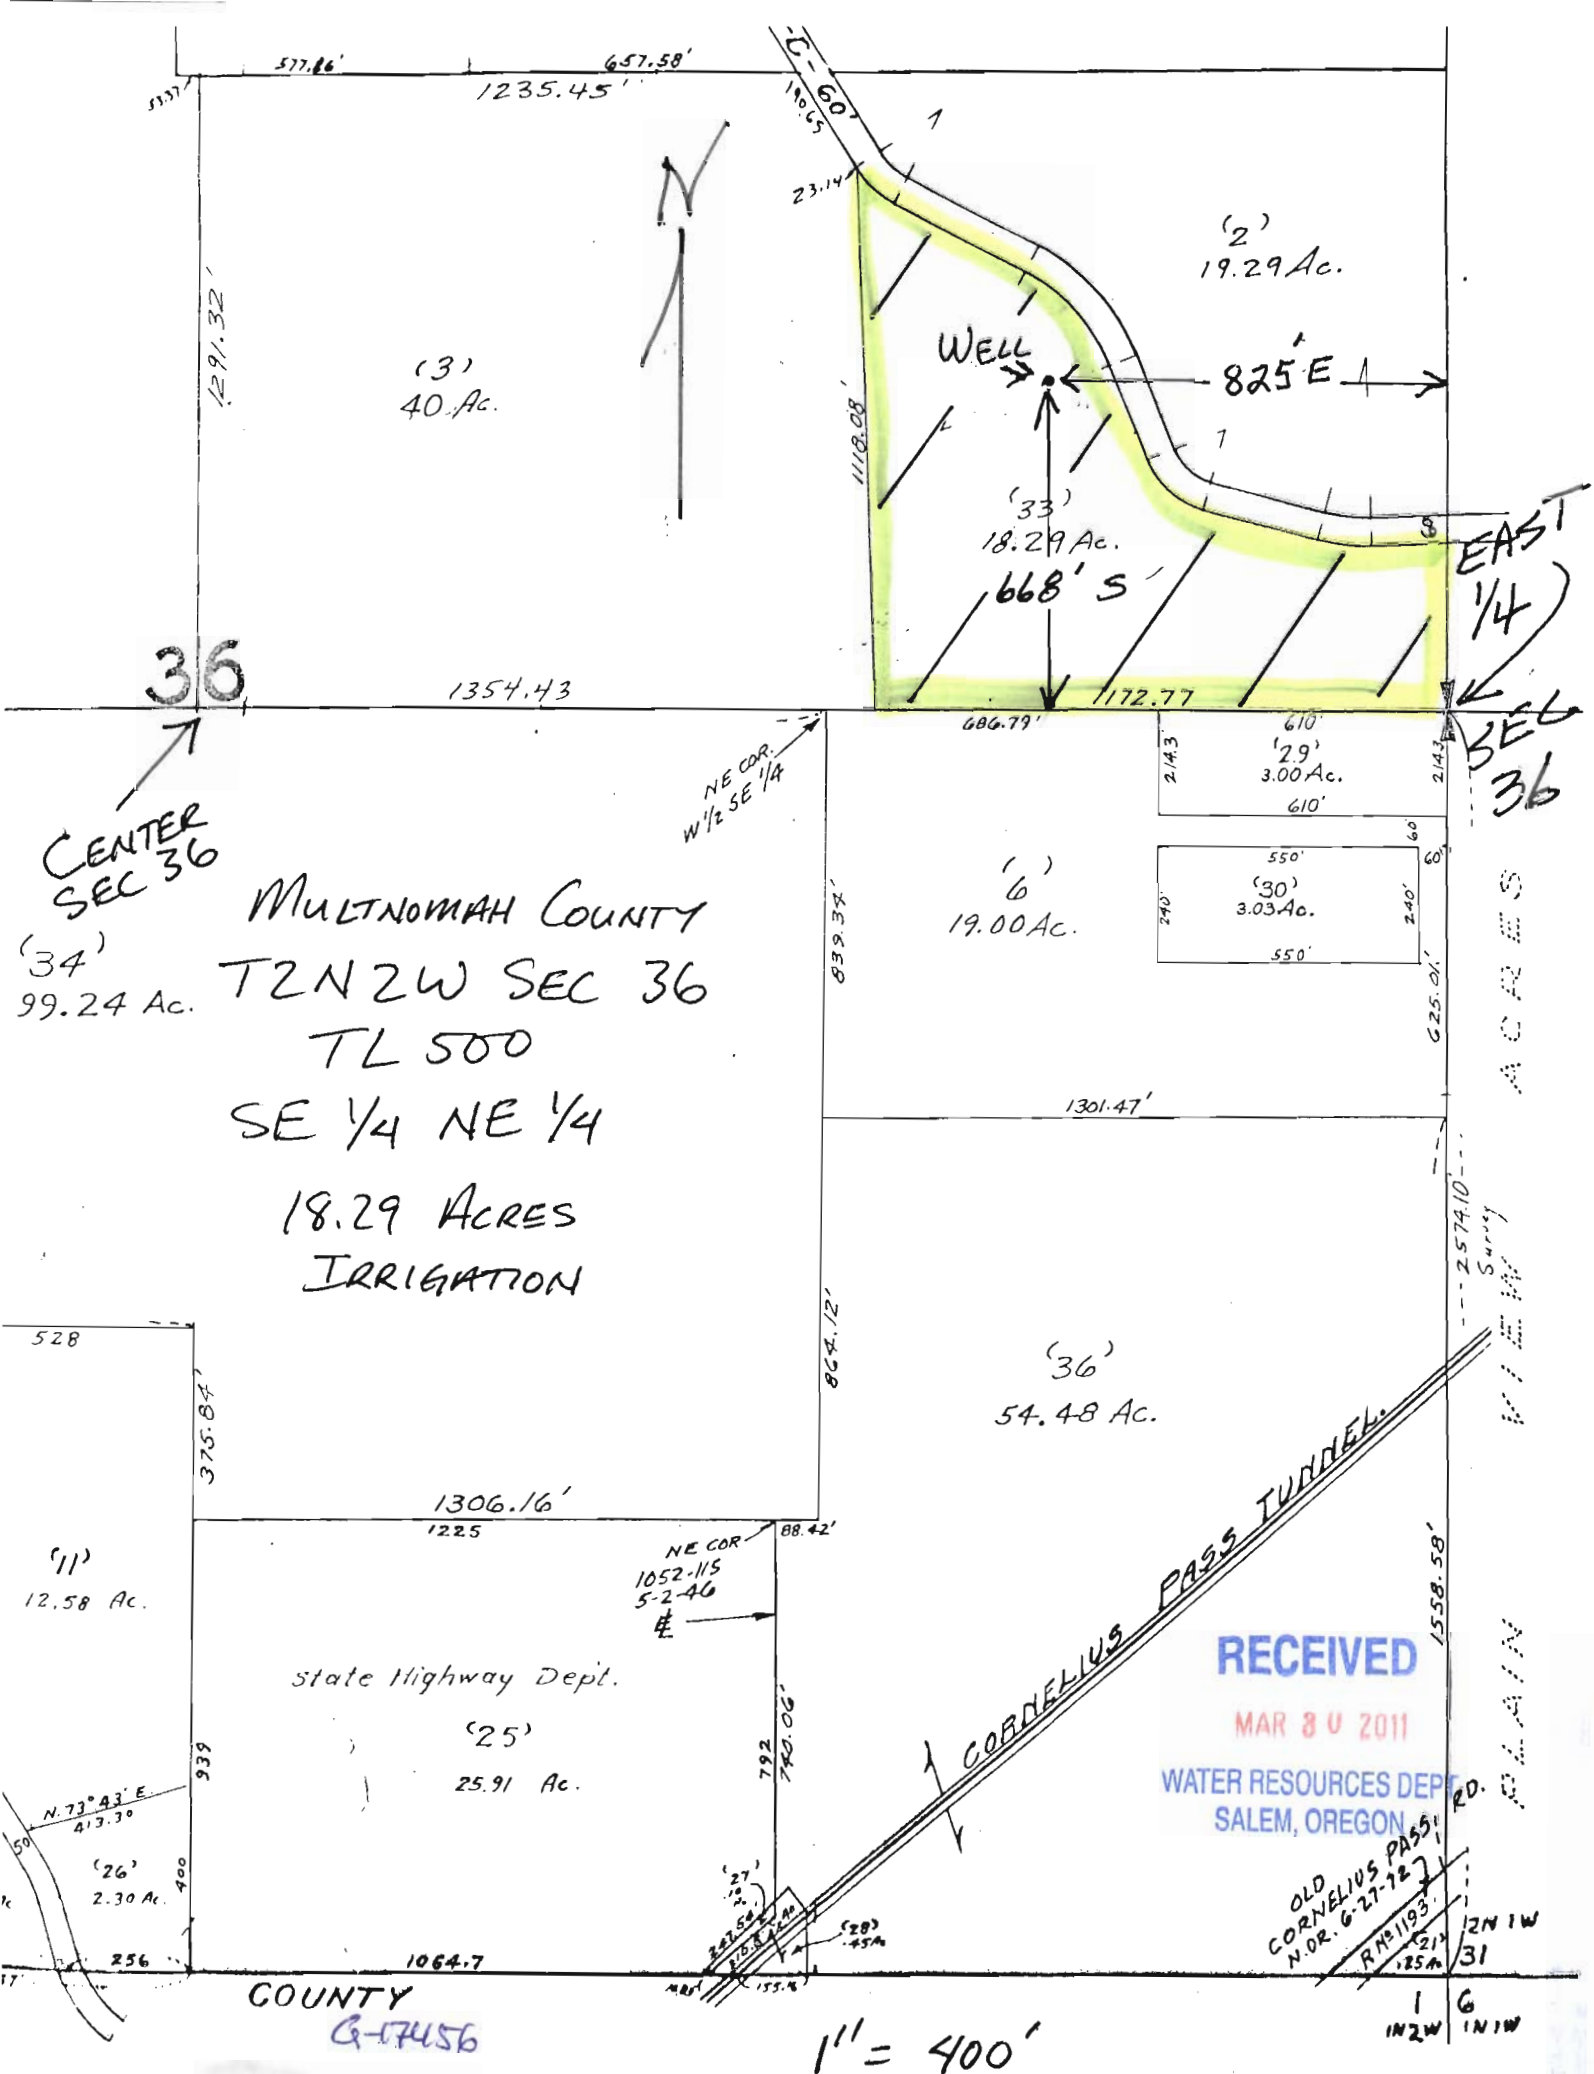

MULTNOMAH COUNTY
T2N 2W SECTION 36
TL 500
SE 1/4 NE 1/4

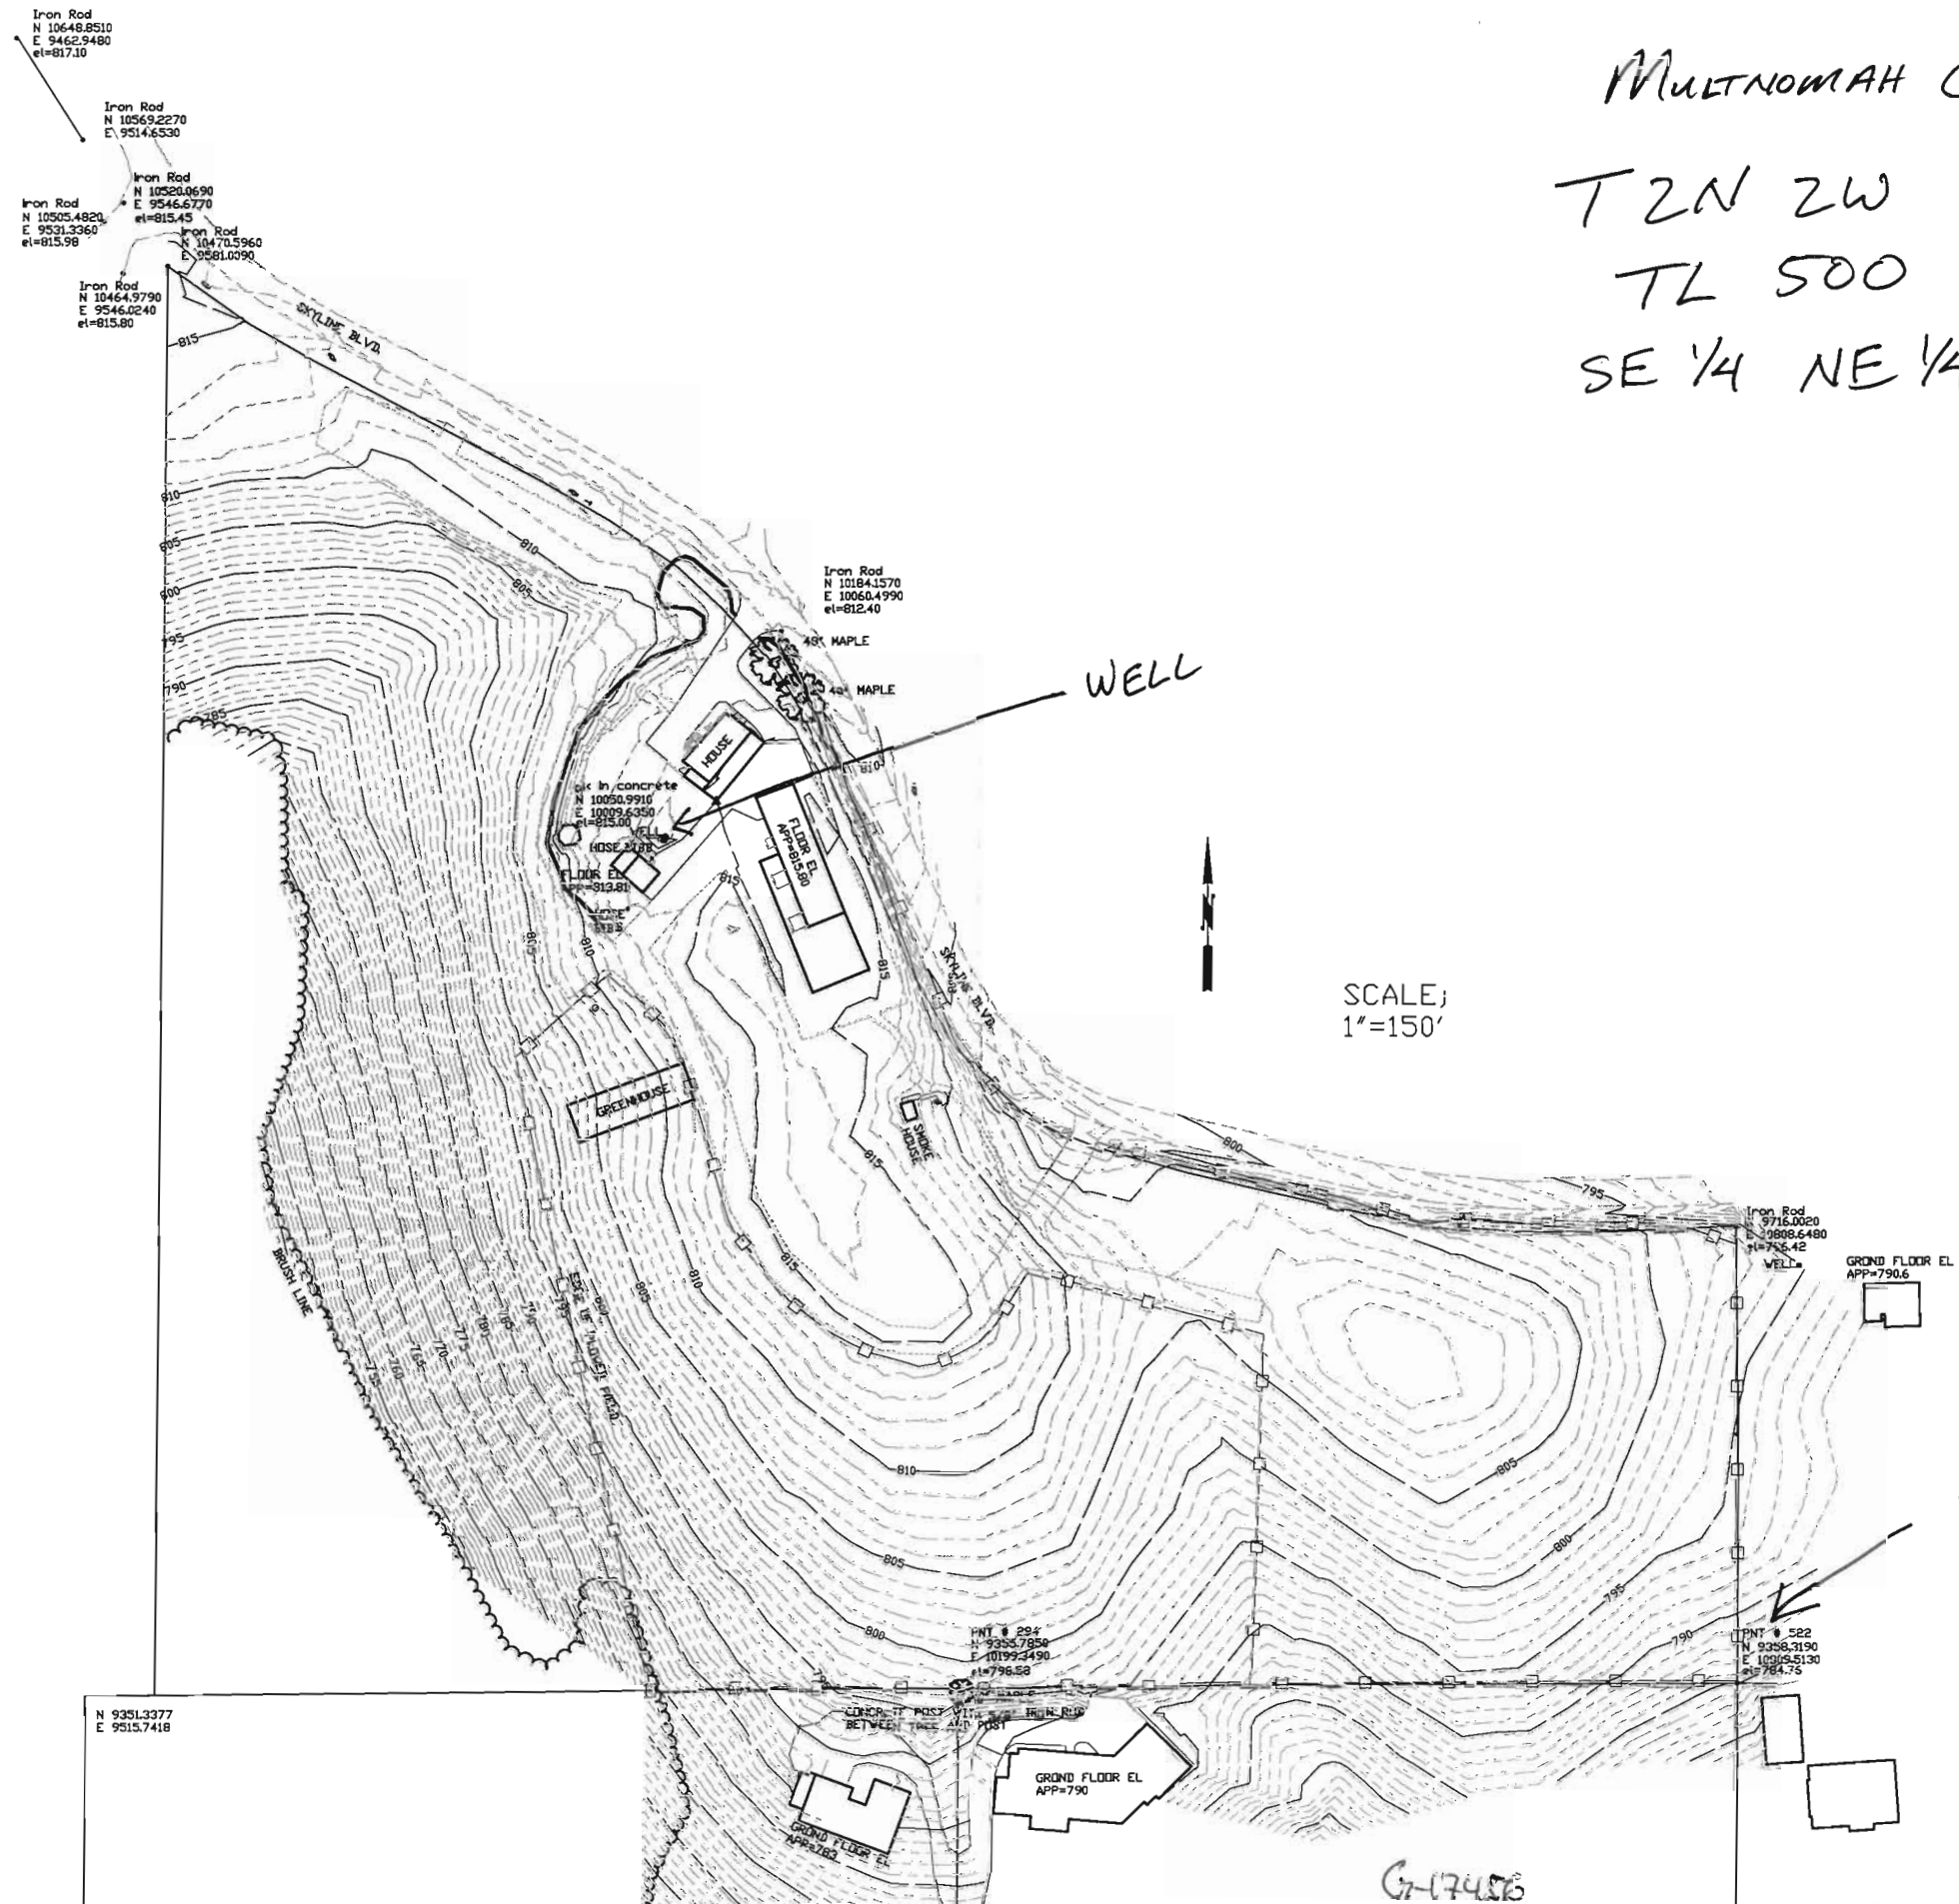

EAST 1/4 SECTION 36

RECEIVED
MAR 8 0 2011
WATER RESOURCES DEPT
SALEM, OREGON

67-17456