


1178-S

LAND COUNTY  
1" = 200' 400'

T17S, R5W, SEC 20  
SW 1/4, SW 1/4  
Scale 1" = 400'  
0.6 acre on tax lot 302

GIS DATA:  
3/11/2008 9:47:49 AM - State

CANCELLED:  
300  
312  
313  
201

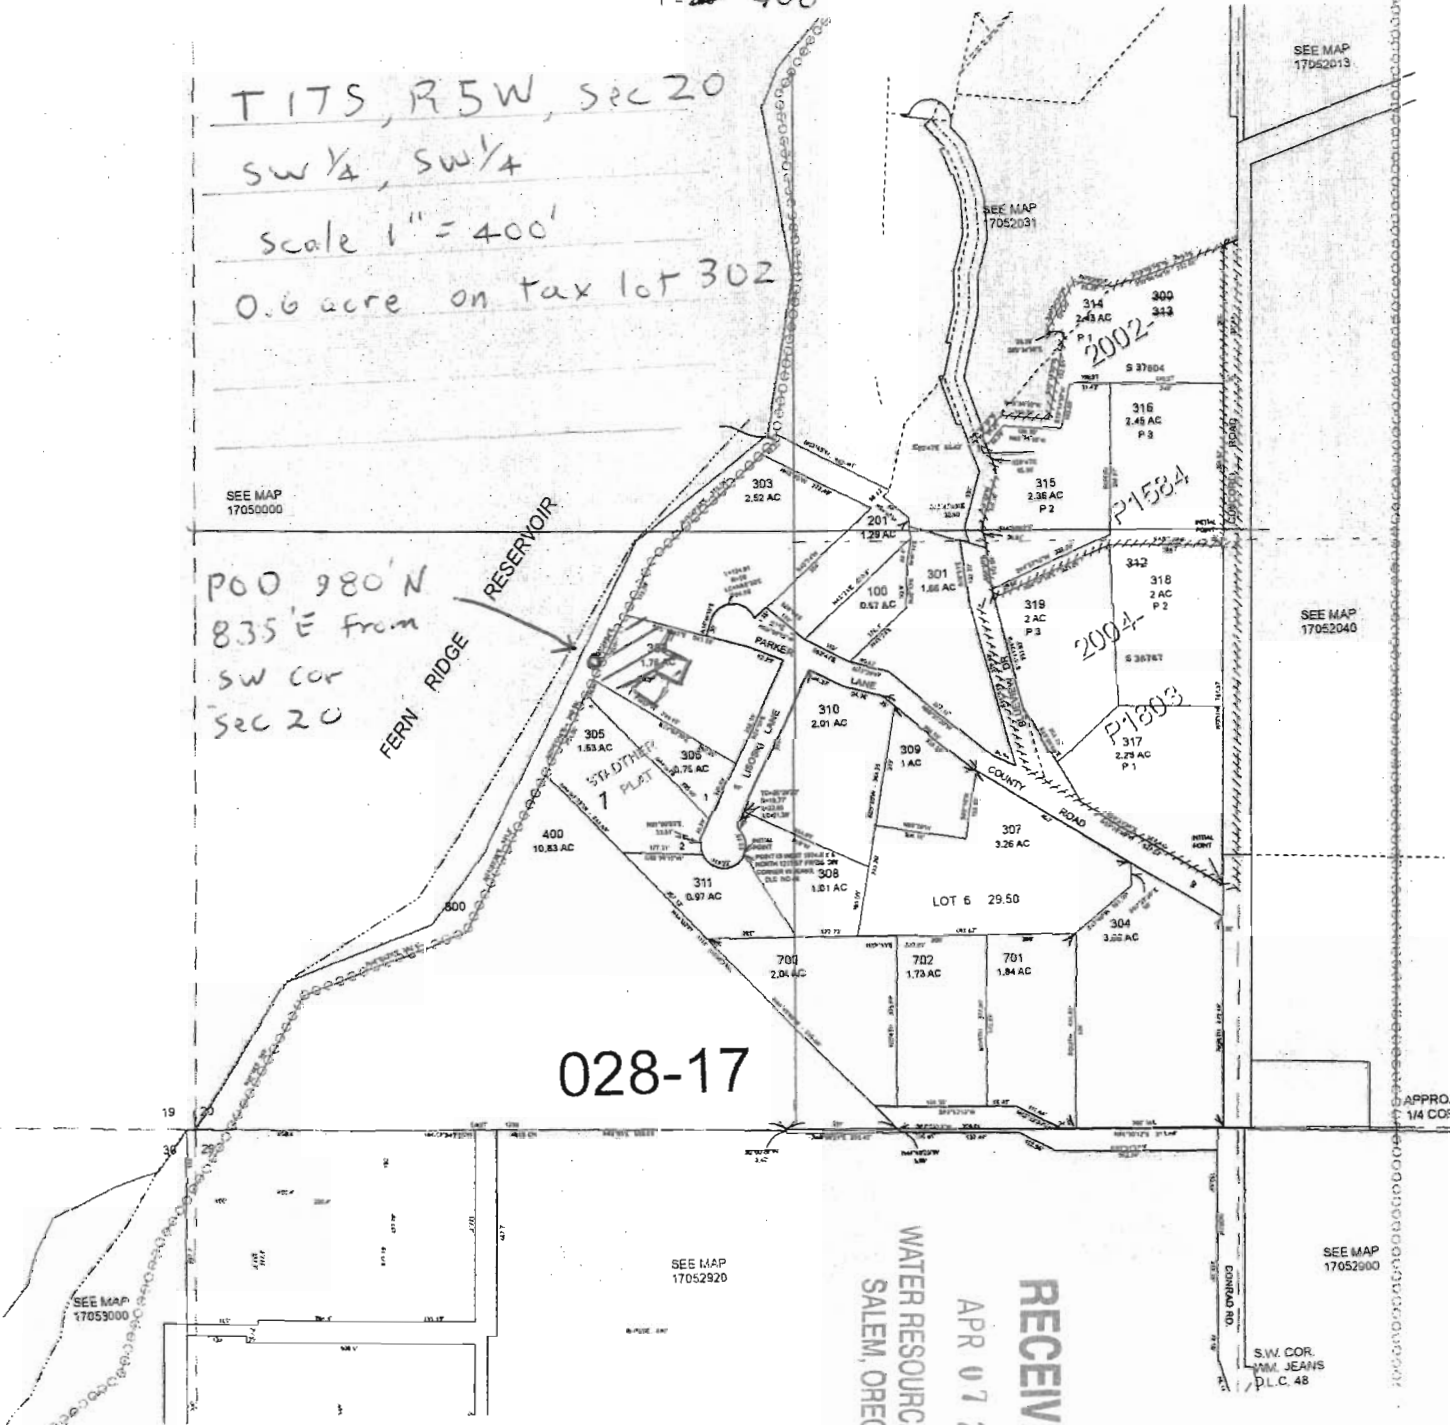

P00 980' N  
835' E From  
SW COR  
SEC 20

028-17

RECEIVED  
APR 07 2011  
WATER RESOURCES DEPT  
SALEM, OREGON



17052030