


T.7S. R.20E. W.M.
WHEELER COUNTY
BROWN PONDS



RECEIVED

APR 22 2011

WATER RESOURCES DEPT
SALEM, OREGON

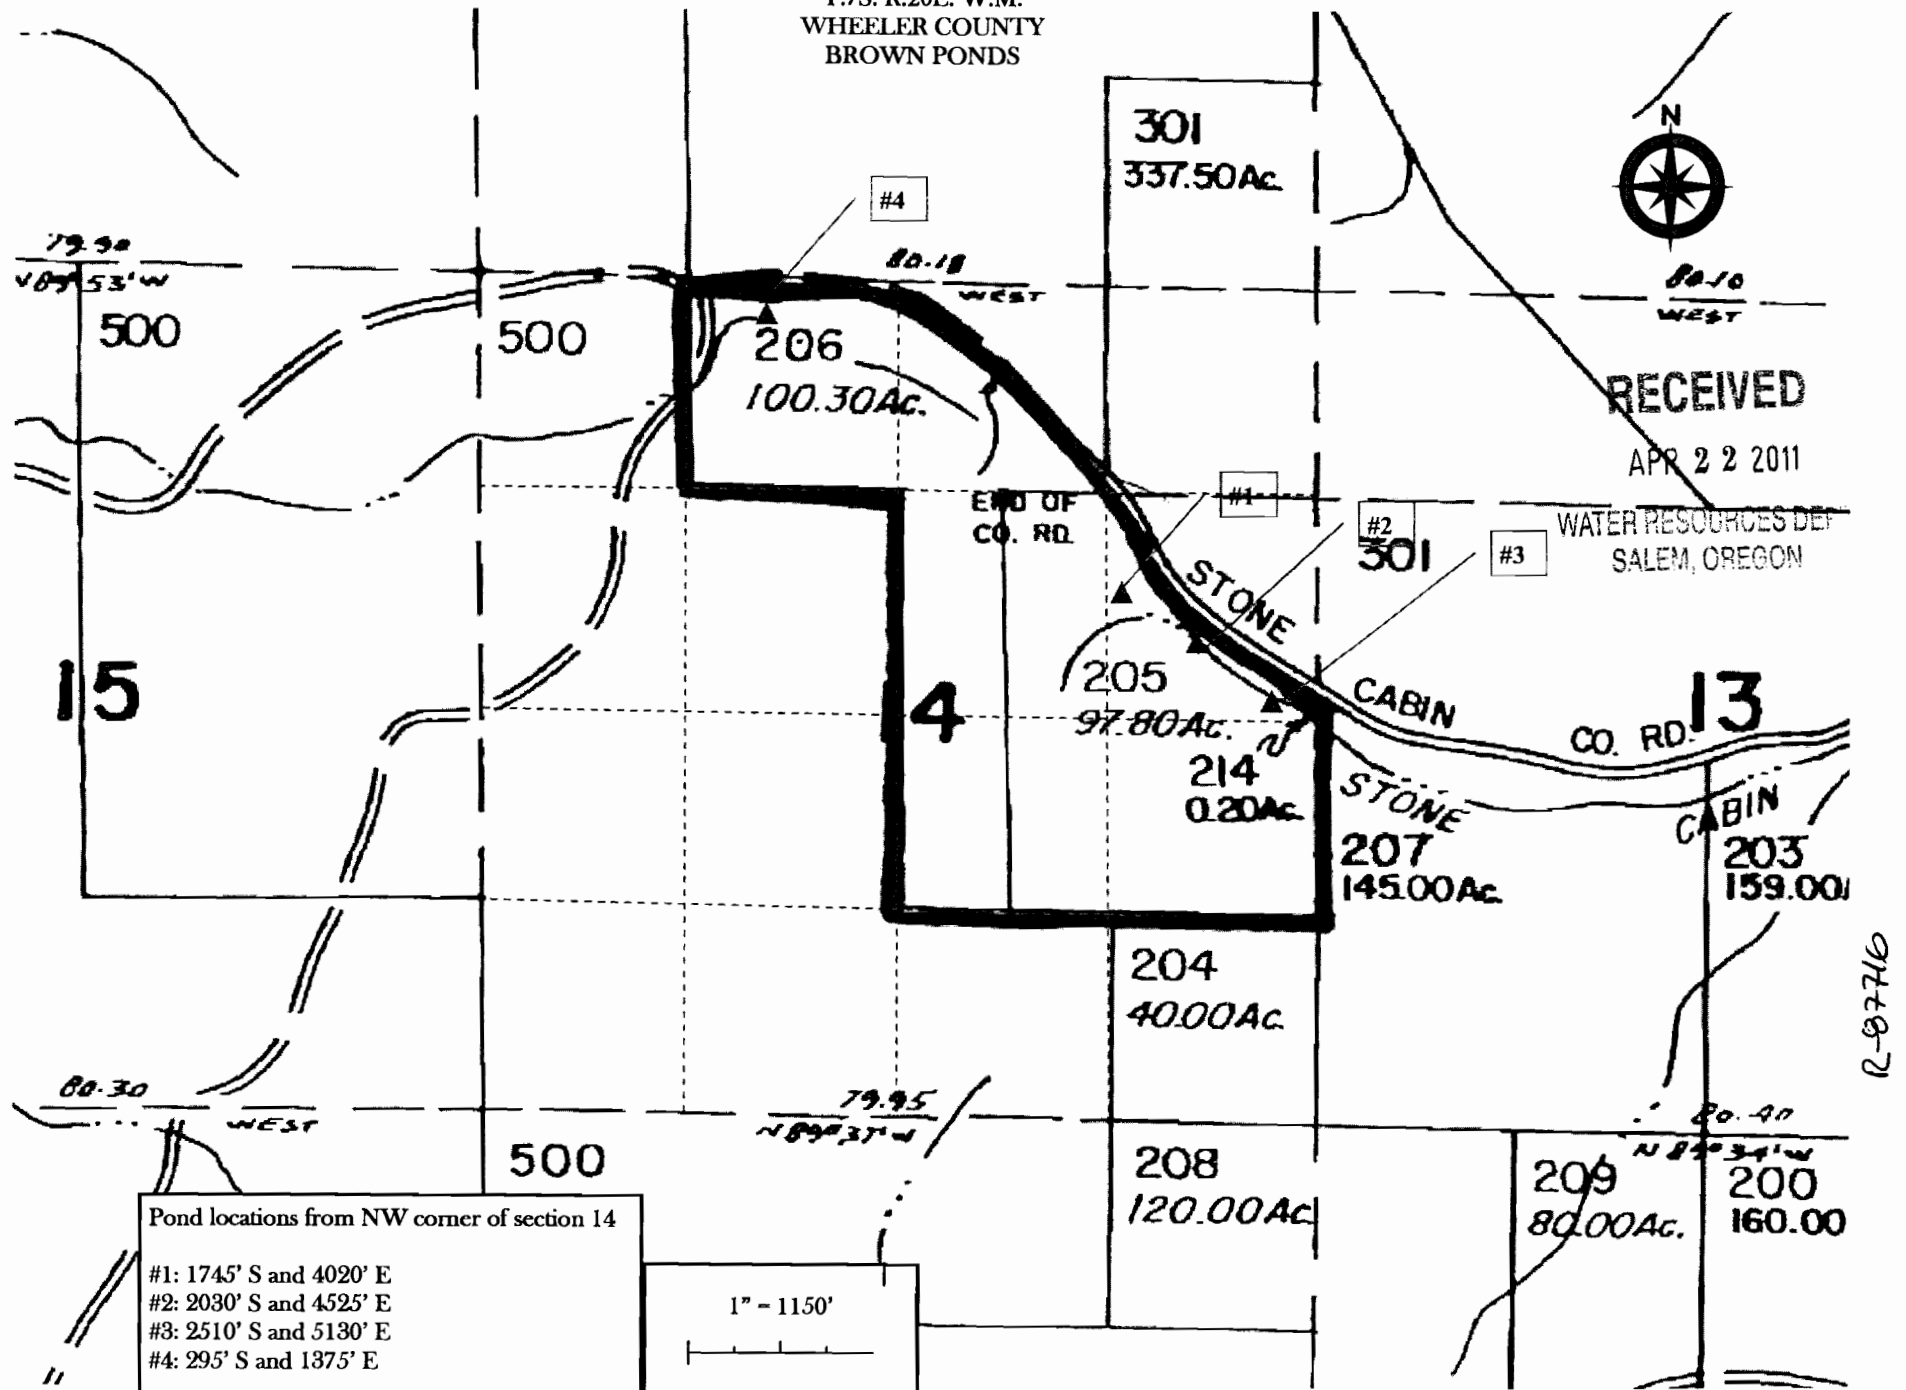

2-87746