


T.7S. R.20E. W.M.
WHEELER COUNTY
BROWN PONDS



RECEIVED

APR 22 2011

WATER RESOURCES DEPT
SALEM, OREGON

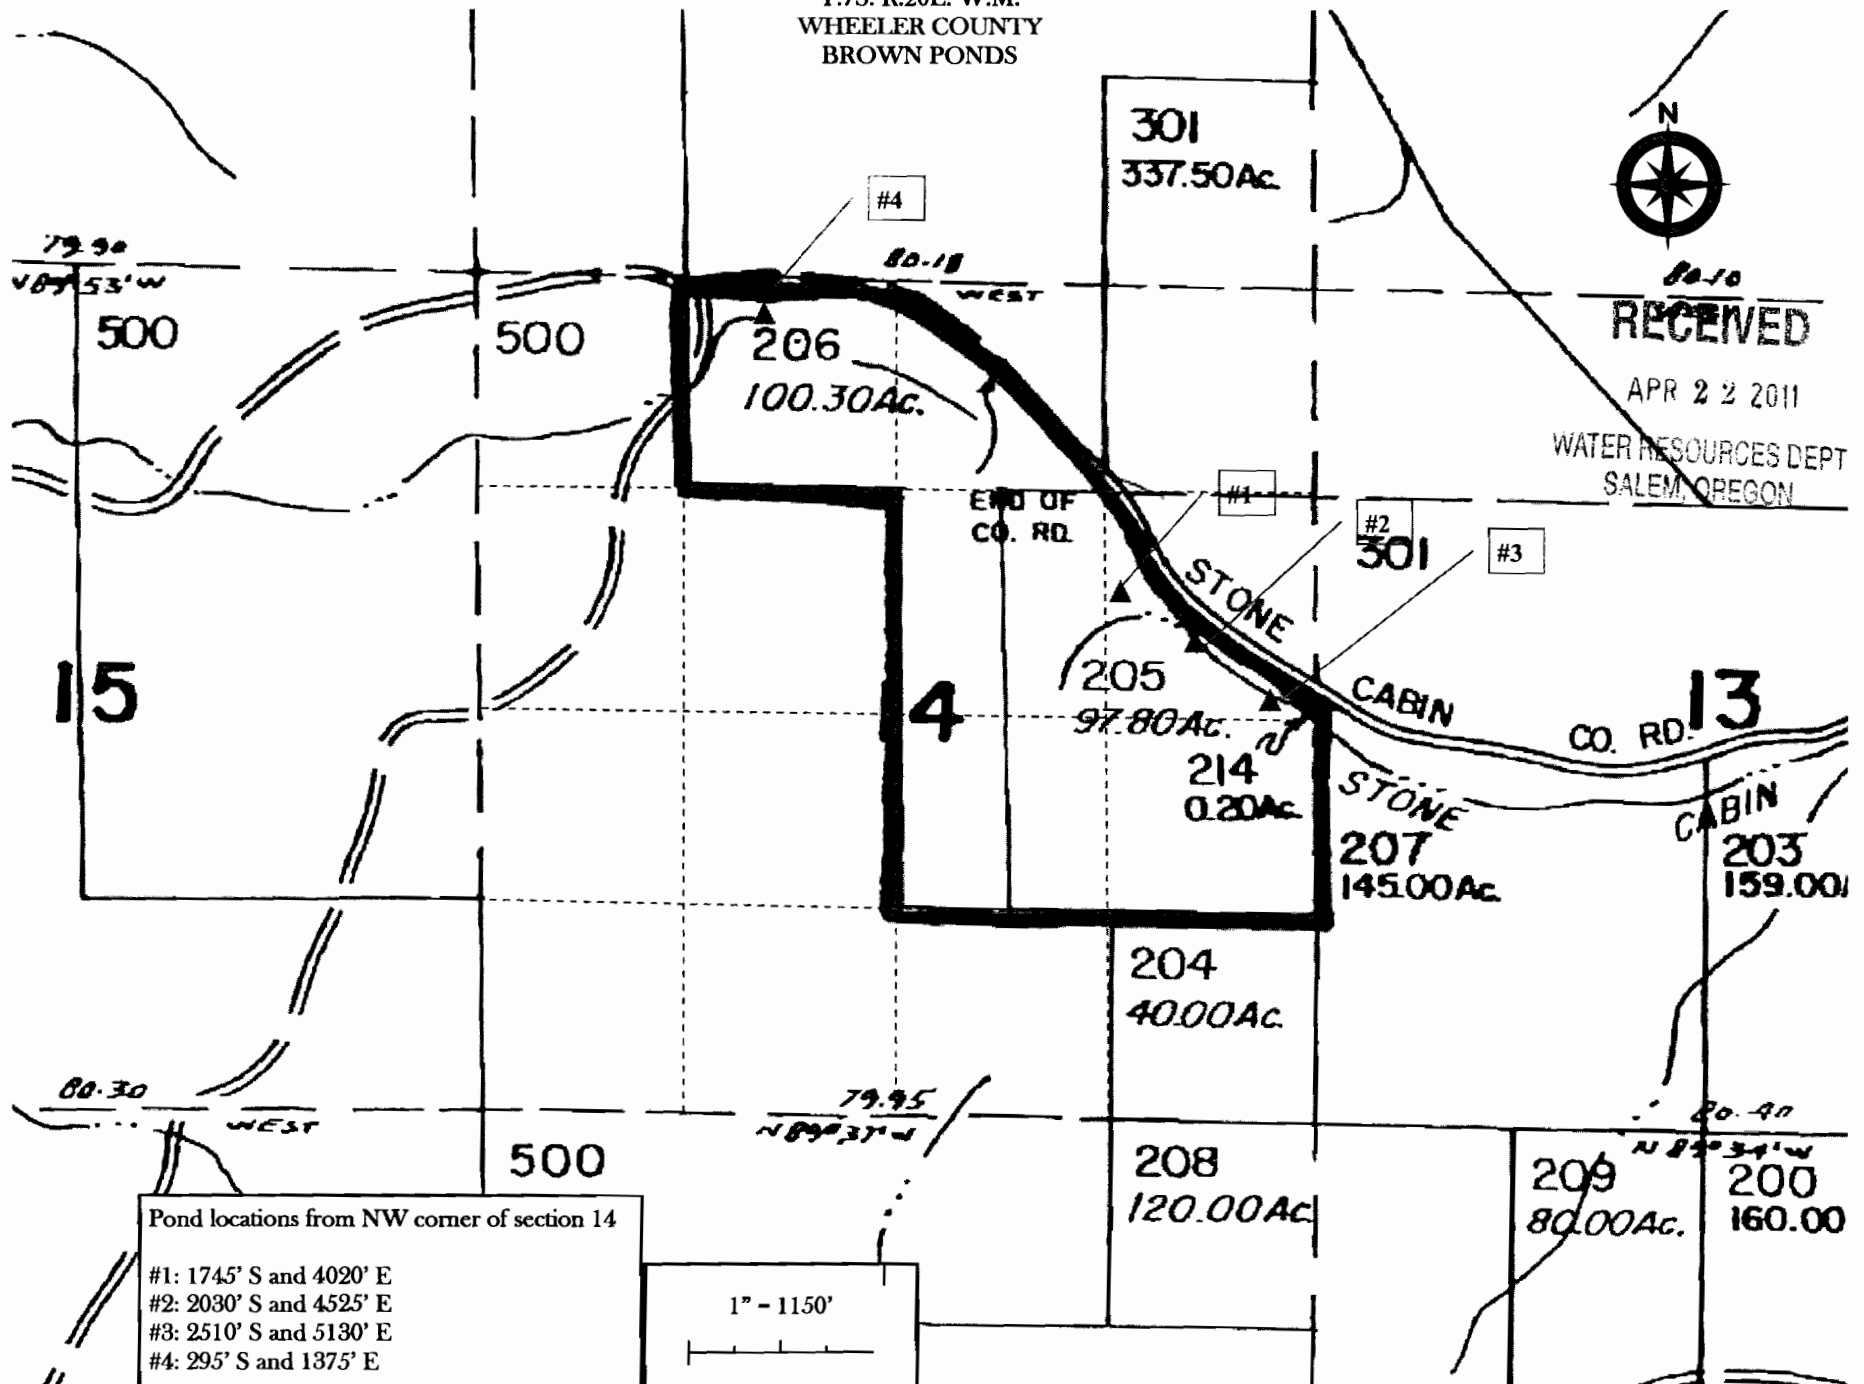

Pond locations from NW corner of section 14

- #1: 1745' S and 4020' E
- #2: 2030' S and 4525' E
- #3: 2510' S and 5130' E
- #4: 295' S and 1375' E

1" = 1150'

74-7-8-7