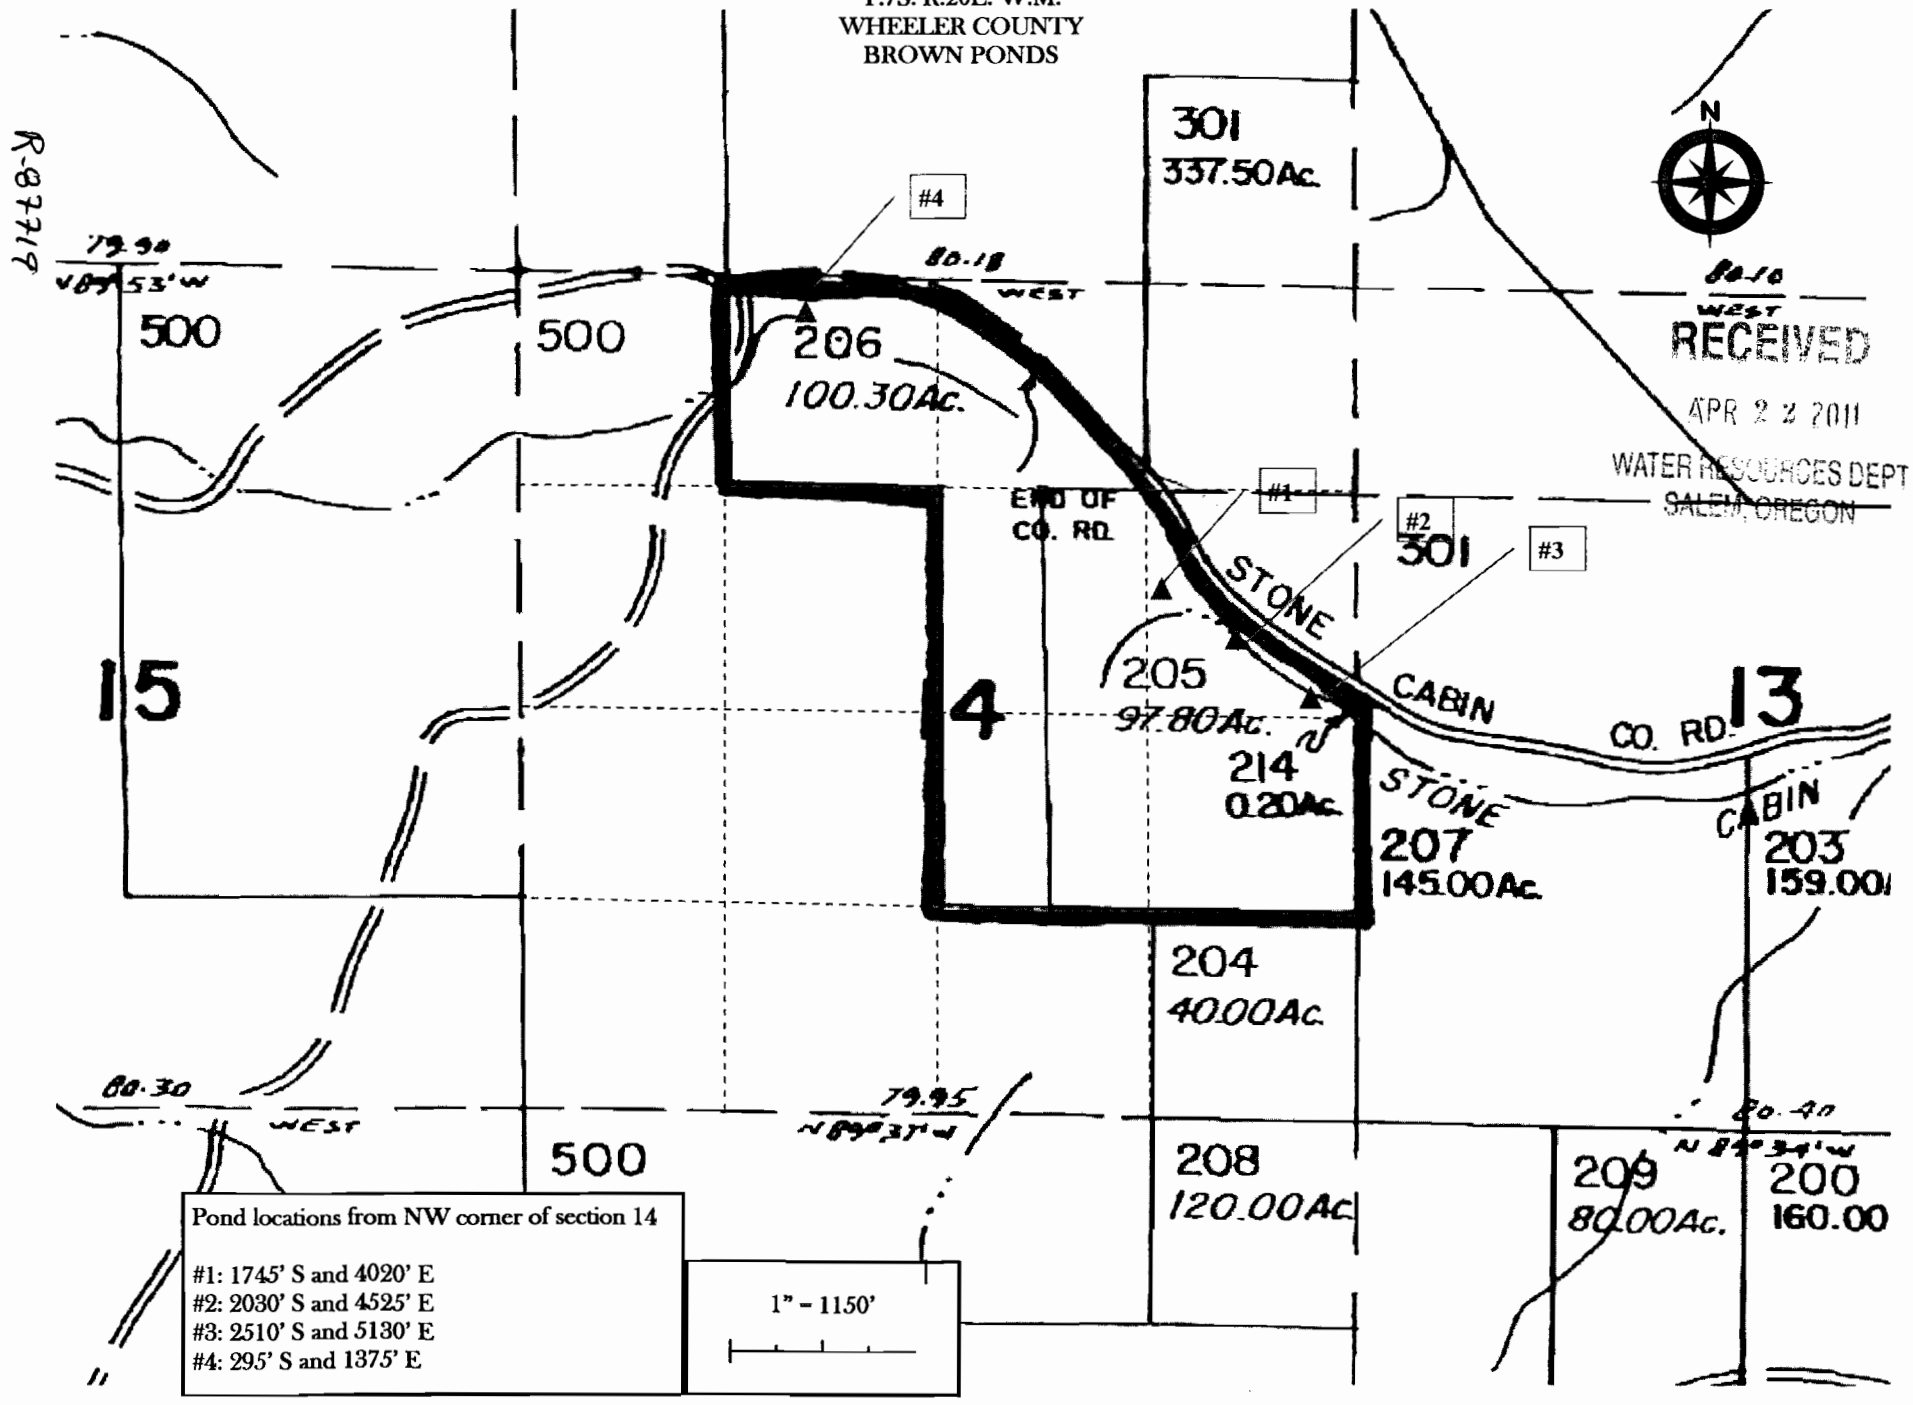

T.7S. R.20E. W.M.
WHEELER COUNTY
BROWN PONDS
R-8219
301
337.50Ac.
#4
80.18
WEST
79.90
N89°53'W
500
500
206
100.30Ac.
END OF
CO. RD.
#1
#2
301
#3
STONE
205
97.80Ac.
15
4
214
0.20Ac.
CABIN
CO. RD.
13
STONE
207
145.00Ac.
CABIN
203
159.00
204
40.00Ac.
80.30
WEST
79.95
N89°37'W
500
208
120.00Ac.
209
80.00Ac.
200
160.00
80.40
N89°34'W
11
N
RECEIVED
APR 22 2011
WATER RESOURCES DEPT
SALEM, OREGON
Pond locations from NW corner of section 14
#1: 1745' S and 4020' E
#2: 2030' S and 4525' E
#3: 2510' S and 5130' E
#4: 295' S and 1375' E
1" = 1150'