


# 40S-3W-19-NE/SW-Tax Lot700

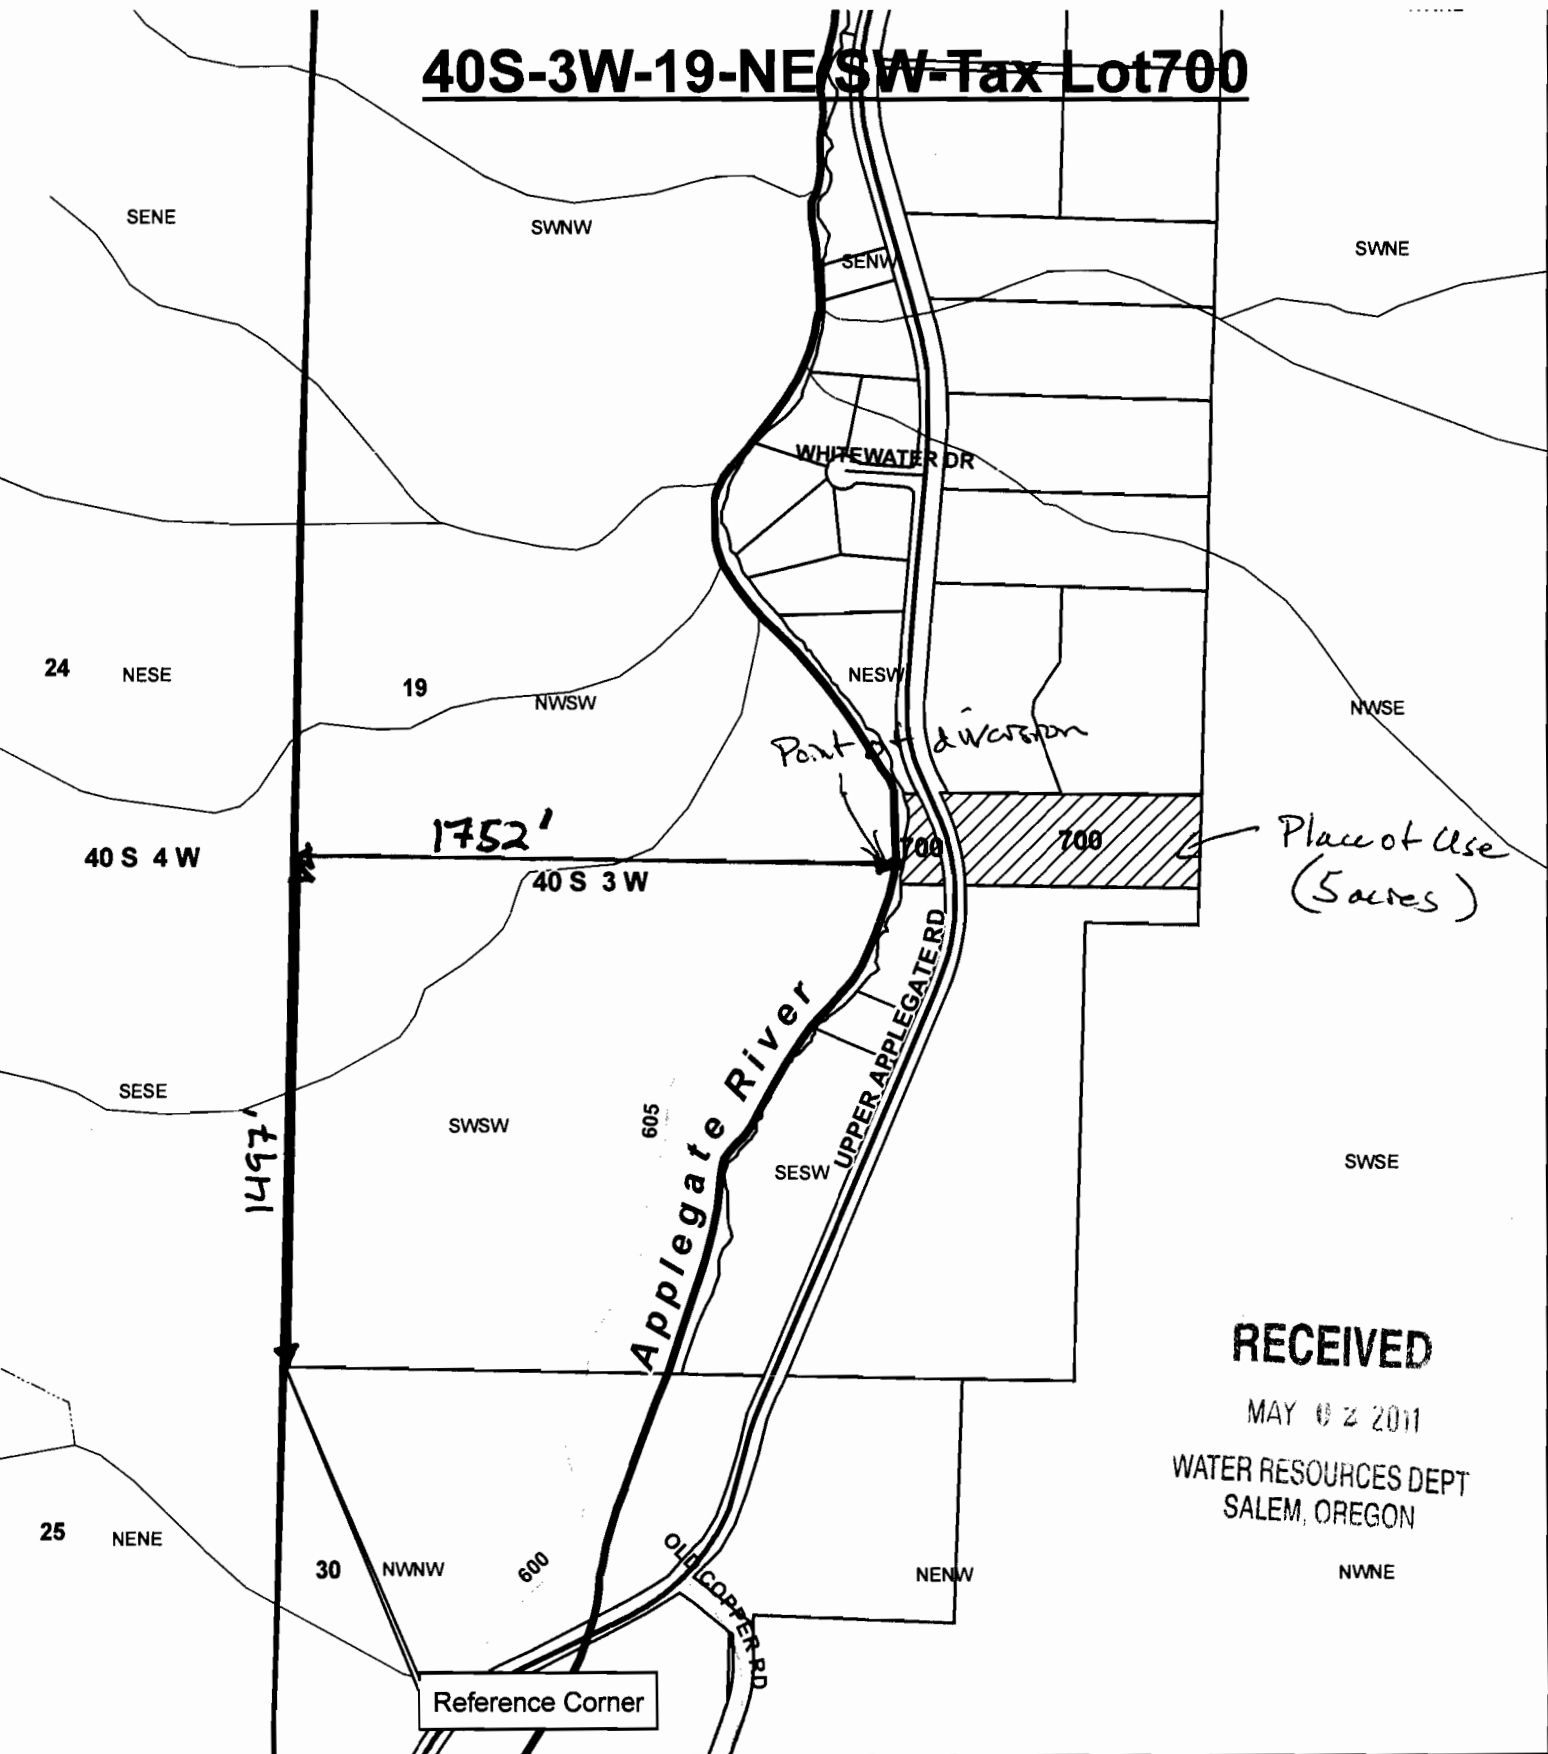


**RECEIVED**

MAY 02 2011





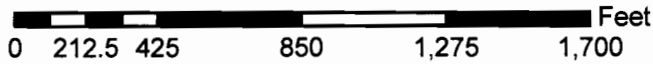

WATER RESOURCES DEPT  
SALEM, OREGON



1 inch = 565 feet



## Legend

-  POU
-  Tax Lots
-  Townships
-  Sections
-  Quarter quarters
-  • POD