


RECEIVED

MAY 19 2011

WATER RESOURCES DEPT
SALEM, OREGON

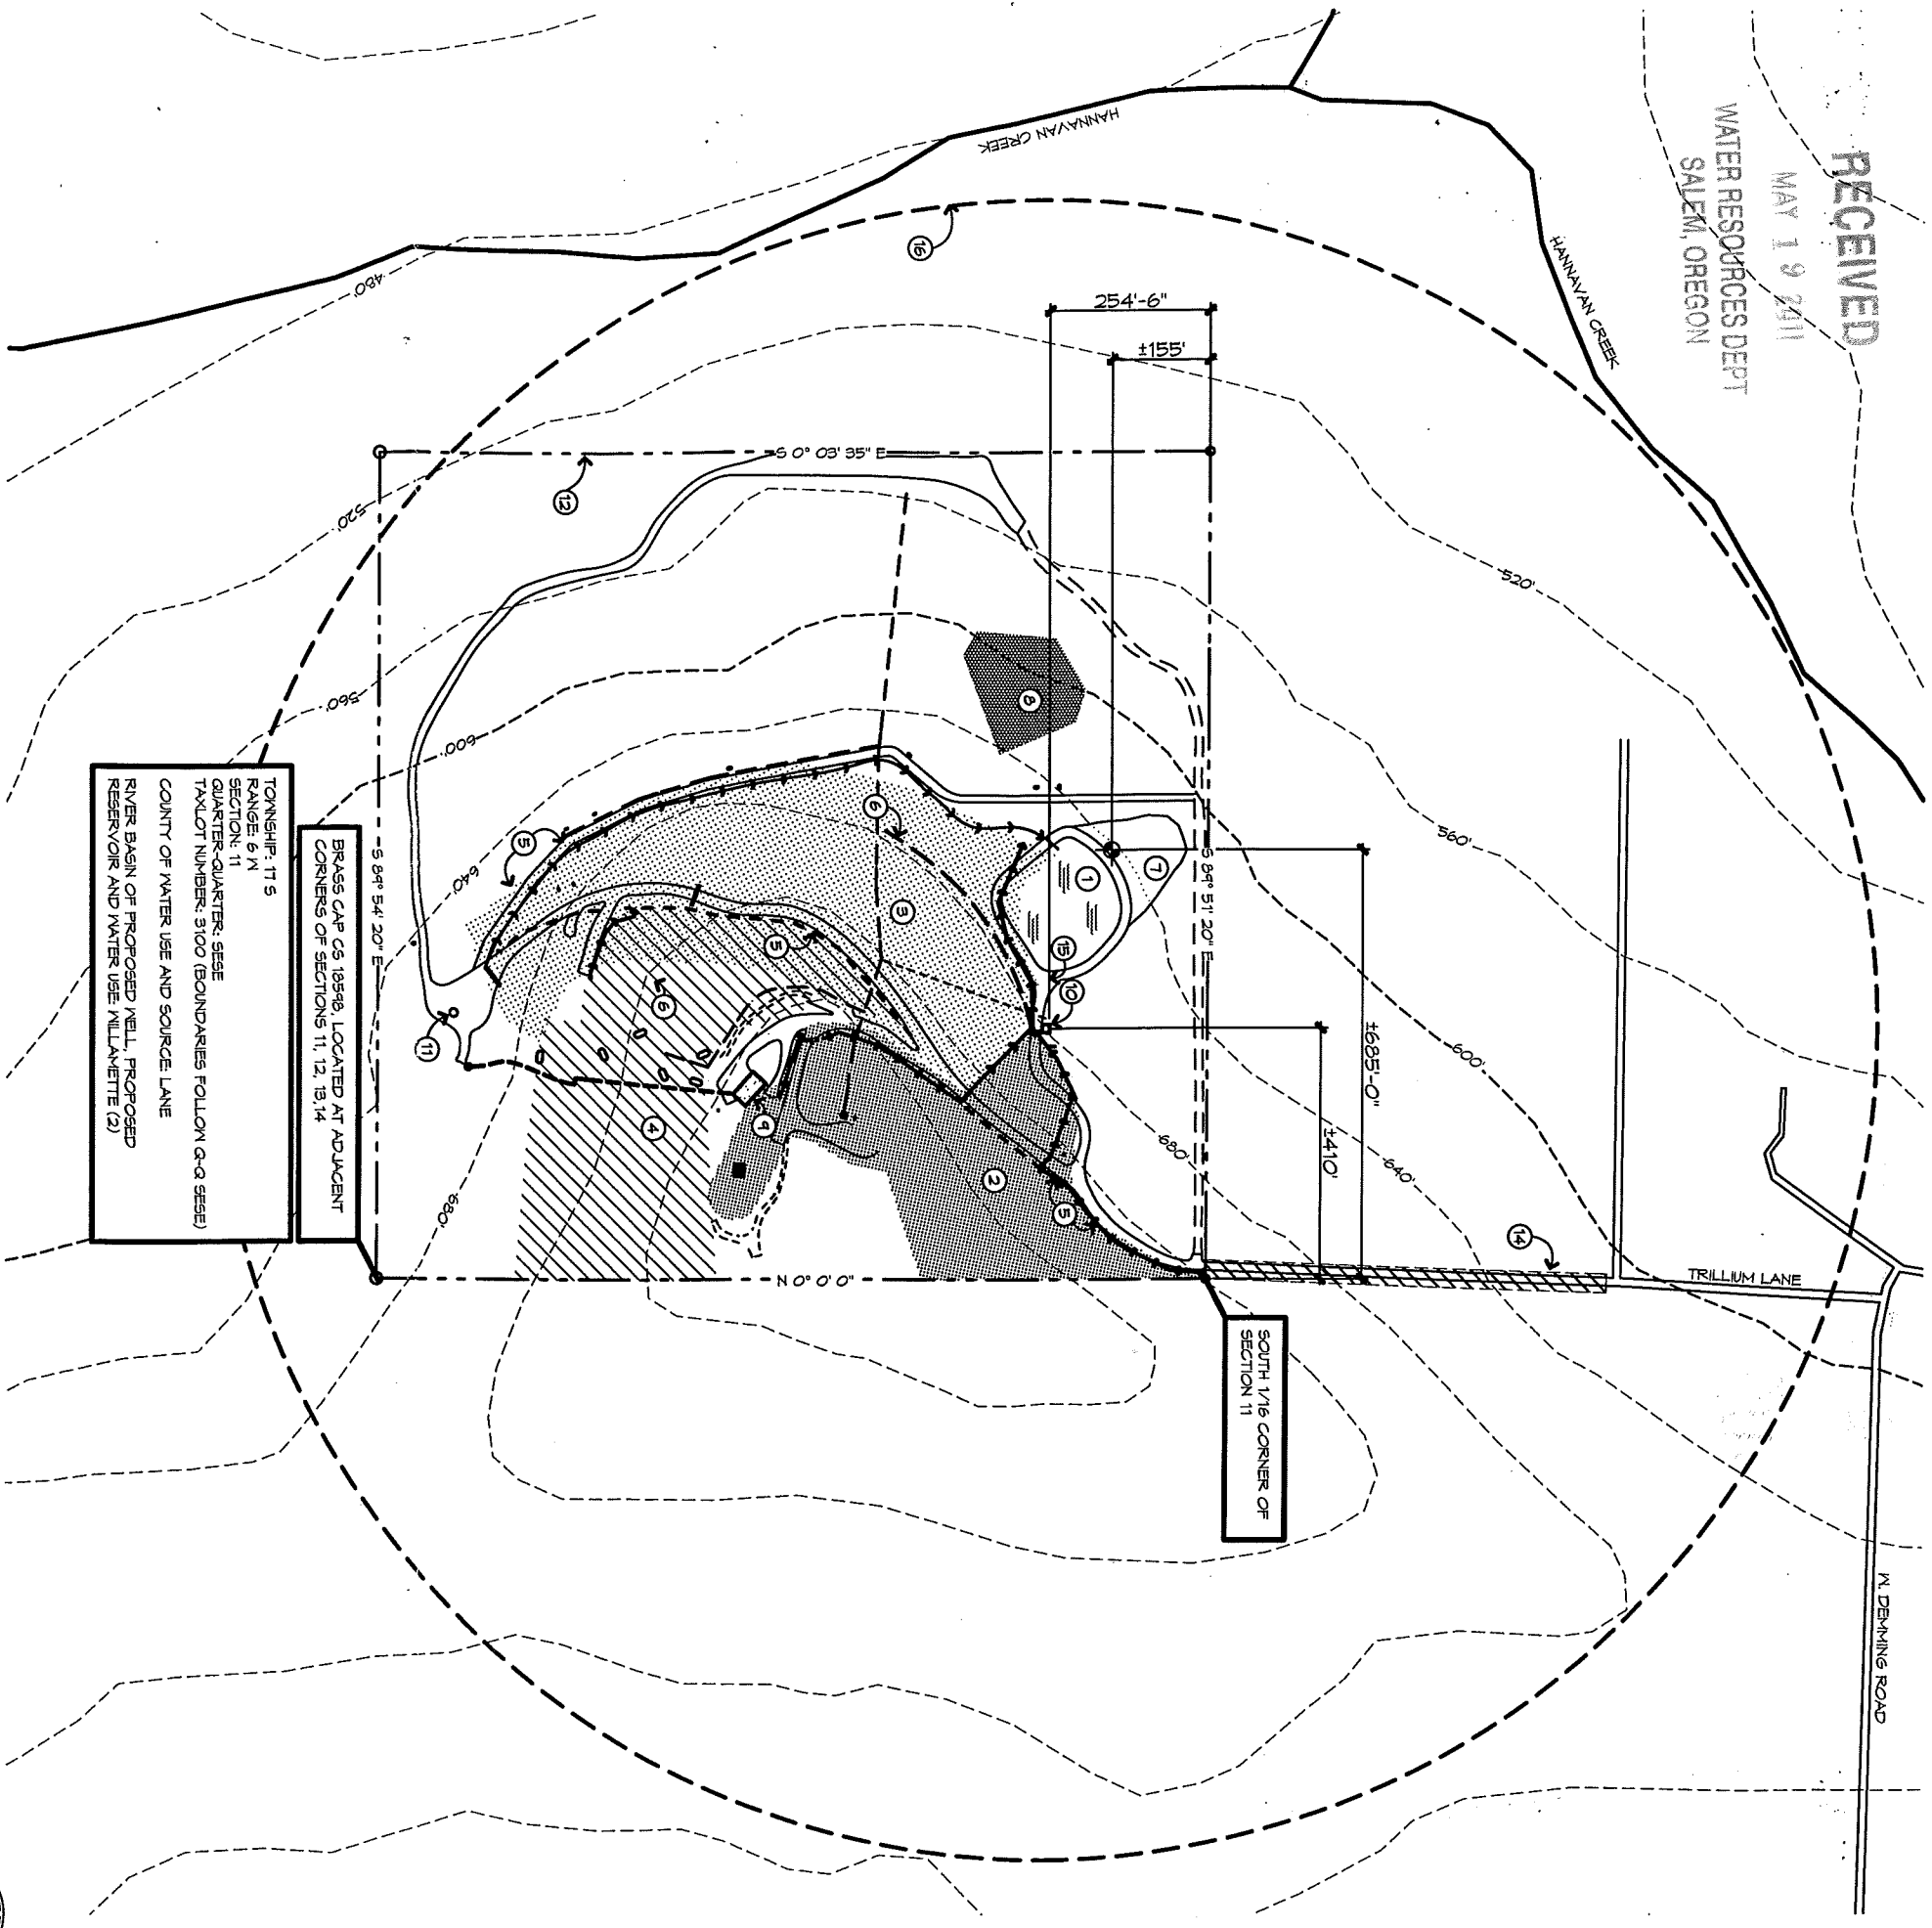


LOCATION AND SOURCE NOTES


- 1 RESERVOIR: TO HOLD RUNOFF AND SUPPLEMENTED BY PROPOSED WELL
- 2 DRAINAGE BASIN #1 - 3.5 ACRES (SOURCE OF RUNOFF)
- 3 DRAINAGE BASIN #2 - 6.5 ACRES (SOURCE OF RUNOFF)
- 4 PASTURE - 4.3 ACRES. STORED WATER WILL BE USED TO IRRIGATE
- 5 LINED DITCH TO CONVEY RUNOFF TO POND
- 6 PIPE TO CONVEY WATER FROM POND TO IRRIGATION SYSTEM IN PASTURE
- 7 EMBANKMENT DAM
- 8 EMERGENCY OVERFLOW DELTA

LOCATION & SOURCE MAP

1" = 300'-0"

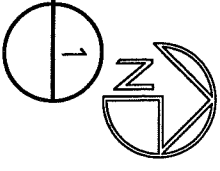

- 9 RESIDENCE
- 10 PROPOSED WELL IN PUMP HOUSE
- 11 EXISTING DOMESTIC WELL
- 12 BOUNDARY OF BOTH TAXLOT 3100 AND QUARTER-QUARTER SESE
- 13 RUNOFF BYPASS CHANNEL FOR EXCESS RUNOFF TO FLOW PAST POND IF REQUIRED
- 14 30' ACCESS EASEMENT
- 15 PREVIOUS LOCATION OF PROPOSED WELL - ±104' WEST & ±3' NORTH OF CURRENT PROPOSED LOCATION
- 16 1,320' RADIUS FROM CENTER OF PROPOSED WELL TO NEAREST WATER COURSE

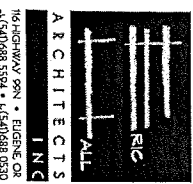

REGISTERED ARCHITECTS
ERIC & PAULA HALL
ARCHITECTS, INC.
ELUGNE OREGON
STATE OF OREGON

LONG HAUL TIMBER & CATTLE, L.L.C.
ERIC & PAULA HALL
TRILLIUM LANE - ELMIRA, OR 94610

App G-17166

DOCUMENT TYPE
Application
PUBLISHED: NOV 8, 2009
REVISED: DATE
PAGE # 1 5.14.11

PROJECT
0900.5