


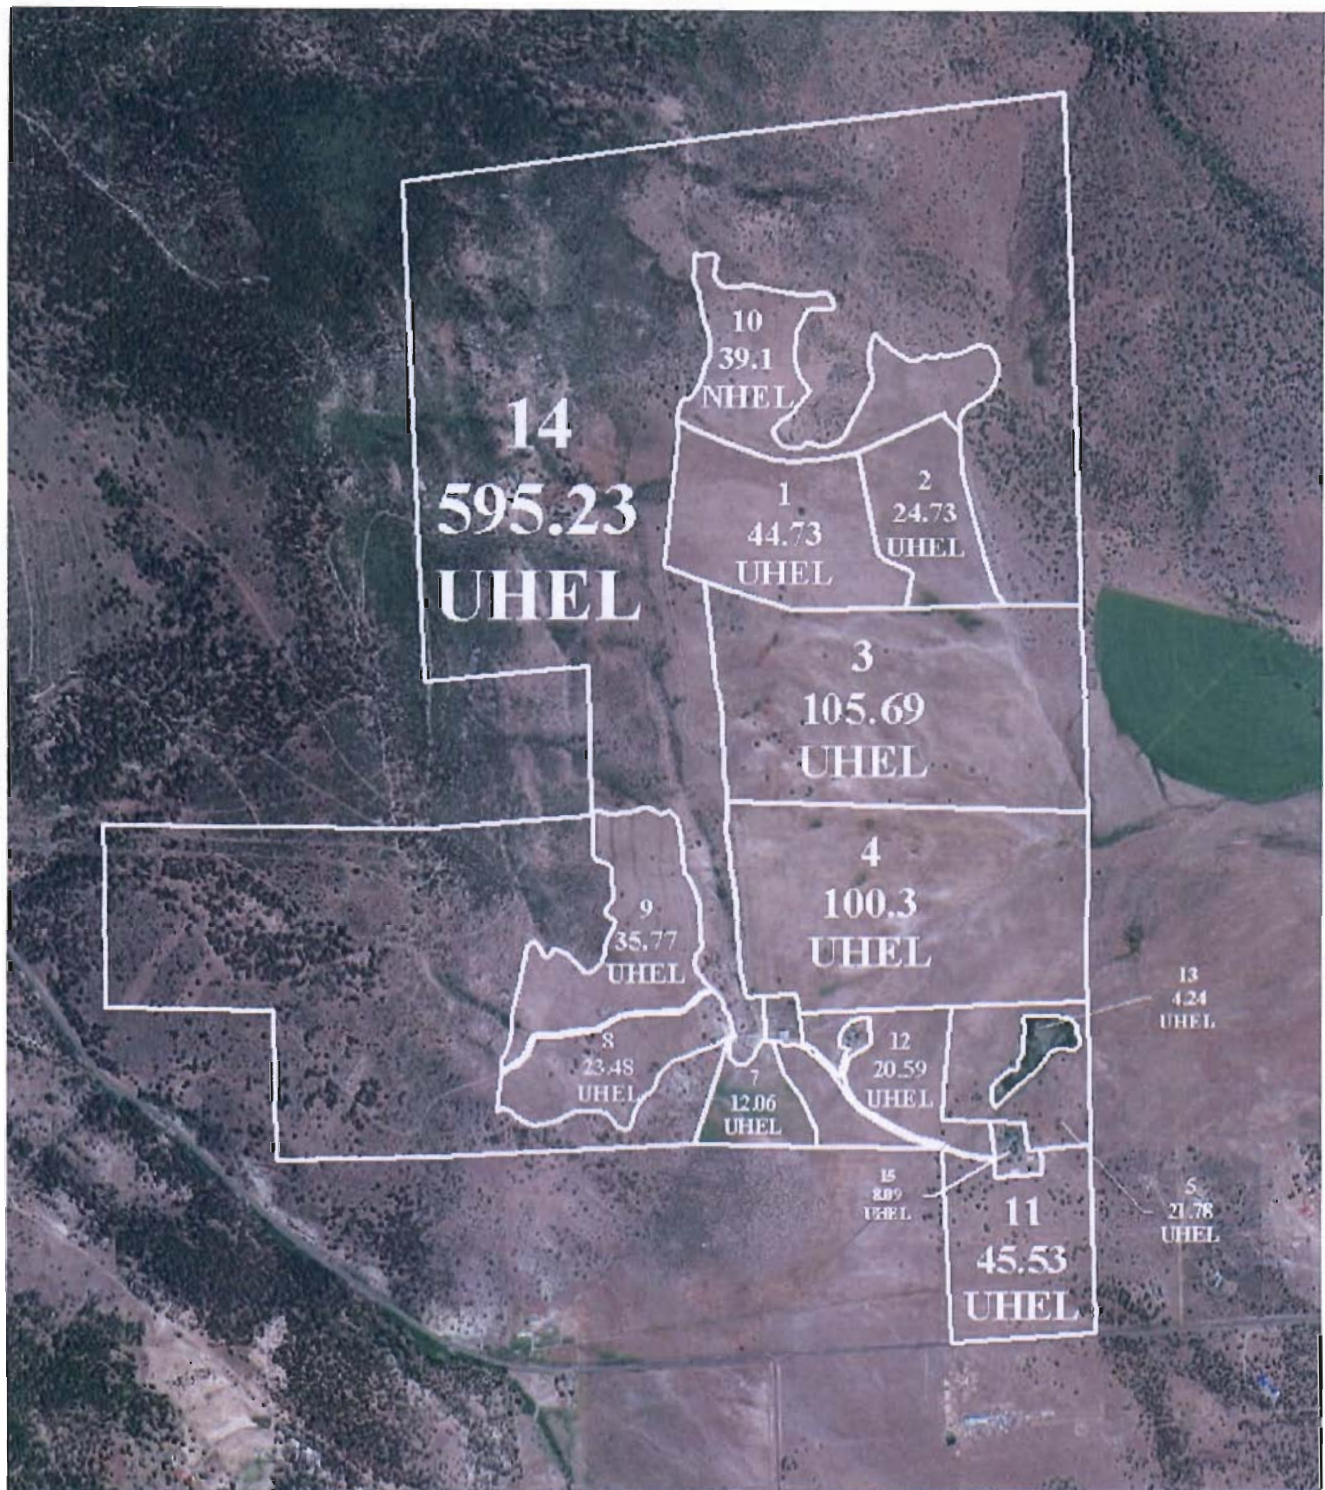

USDA / Farm Service Agency
Lake County
FARM 984
TRACT 268

Wetland Determination Identifiers

- Restricted Use
- ▼ Limited Restrictions
- Exempt from Conservation Compliance Provisions



RECEIVED

MAY 19 2011

WATER RESOURCES DEPT
SALEM, OREGON

Disclaimers:


* Wetland identifiers do not represent the size, shape or specific determination of the area. Refer to your original determination (CPA-026 and attached maps) for exact wetland boundaries and determinations, or contact NRCS.

* This acreage is for FSA program purposes only. No warranty is made for any other use.

S-87725

R-1062
58889

T.39 S., R.18 E., W.M.

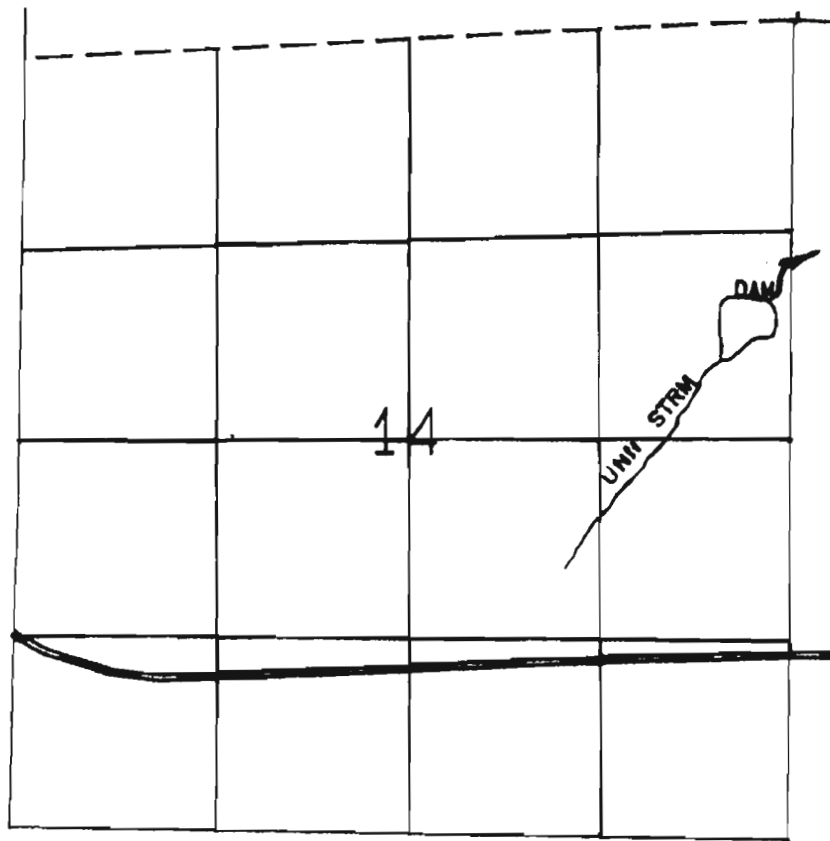

DAM LOCATED 950 FT. N. AND 150 FT. W. FROM E. 1/4 COR. SEC 14

SCALE: 1" = 1320'

FINAL PROOF SURVEY

UNDER

Application No. R-68643 Permit No. R-10623

IN NAME OF

PERRY PARMELEE

Surveyed Oct. 19, 1987 By M. J. MATTICK

RECEIVED

MAY 19 2011

WATER RESOURCES DEPT
SALEM, OREGON


Photo: 41037 378-810 DLM

S-87725

SEE MAP 38S 18E

39S18E
& INDEX

CANCELLED.
101 THRU
105
1400 THRU
1800
2700 THRU
2801
2803
2805 THRU
2817
3800 THRU
4005
7002
7100

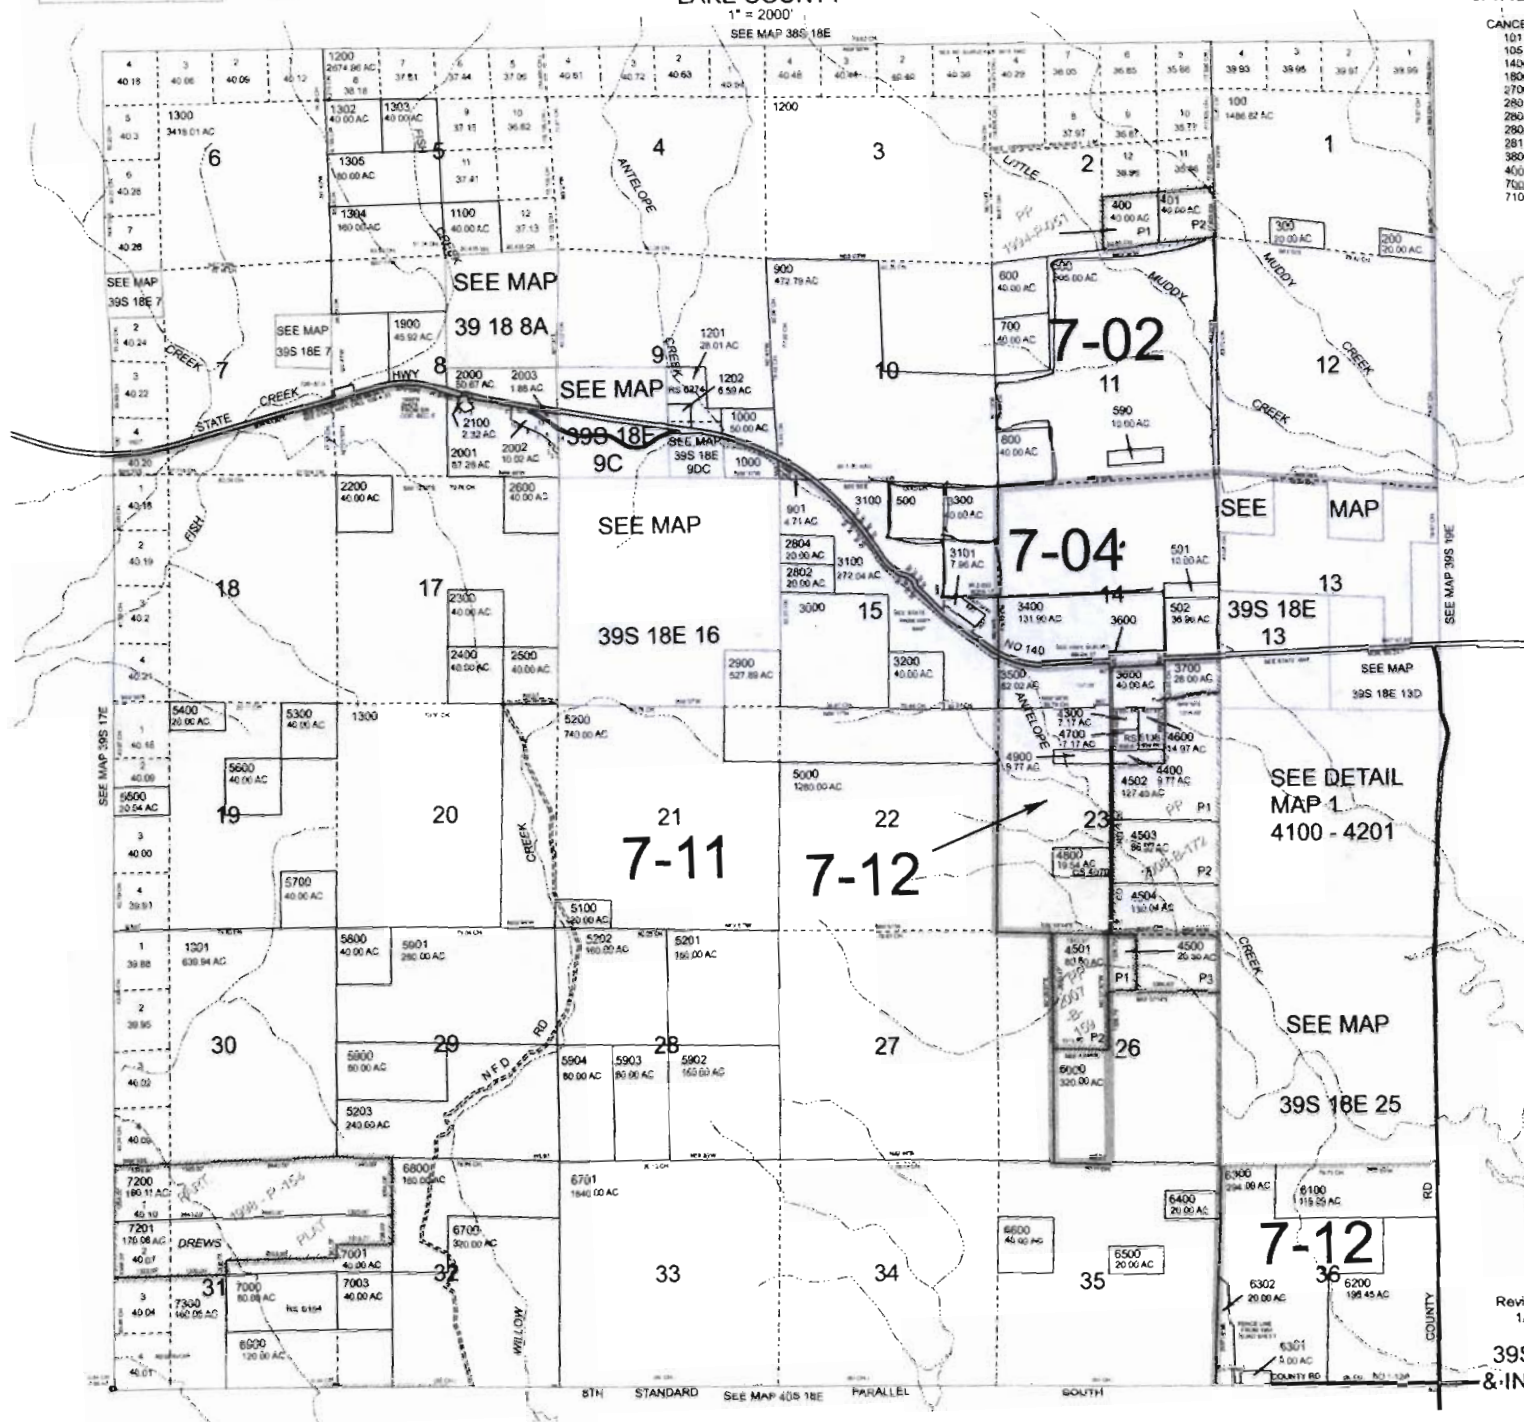

Revised: MA
1/24/2011

39S18E
- & INDEX

RECEIVED

MAY 19 2011

WATER RESOURCES DEPT
SALEM, OREGON

5-8725

