

COBU MAP #

0532

CLAIM OF BENEFICIAL USE MAP


SECTION 29, T2N, R2W, WM
LOT 1001 OF TAX MAP 2N 2 29 AND
LOTS 400 AND 500 OF TAX MAP 2N 2 29C
WASHINGTON COUNTY, OREGON
WILLAMETTE RIVER BASIN
APPLICATION FILE S-74277; PERMIT S-53452

RECEIVED


APR 27 2011

WATER RESOURCES DEPT
SALEM, OREGON


PREPARED FOR:
KENNETH L. AND ESTHER L. CONKLIN
15150 NW JACKSON SCHOOL ROAD
HILLSBORO, OREGON 97124

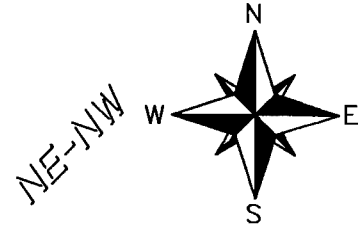

GRAPHIC SCALE

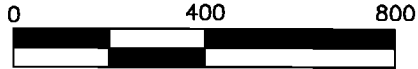

1 inch = 400ft.

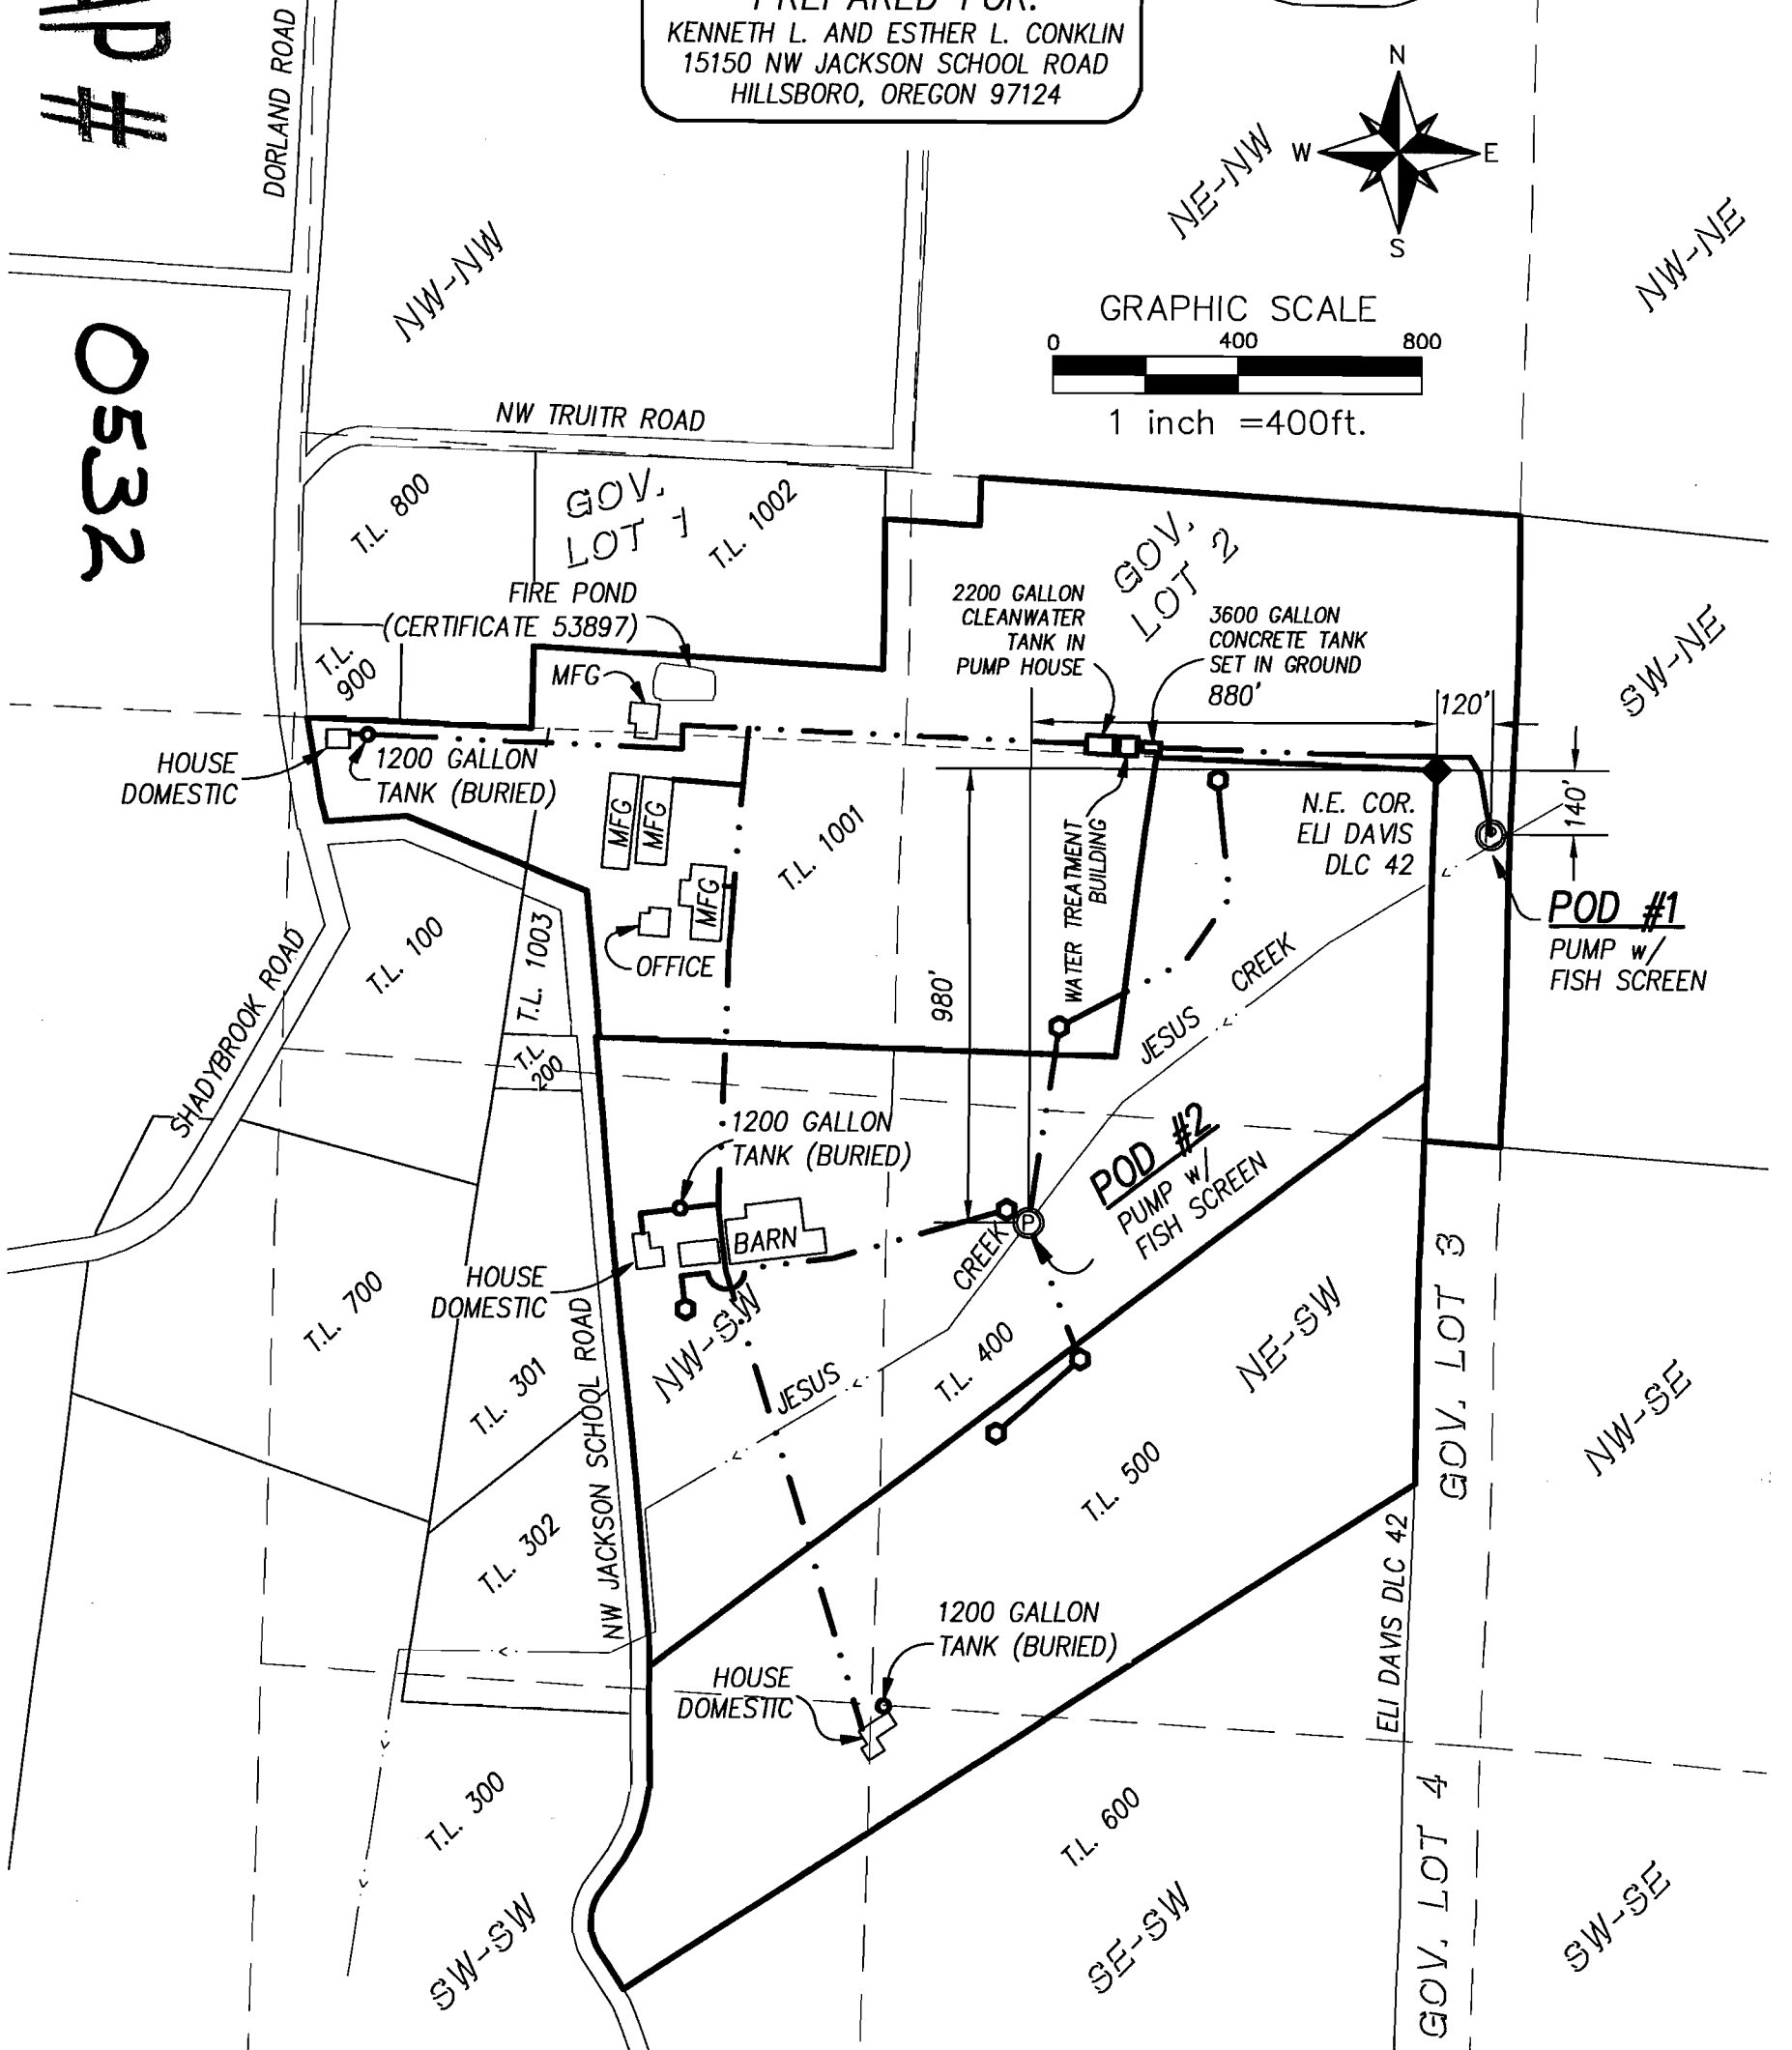

- ⊙ POINT OF DIVERSION (POD)
- STOCK WATER
- MFG MANUFACTURING / COMMERCIAL USE
- EXISTING WATER MAIN PIPES
- PROPERTY BOUNDARY LINE
- TAX LOT LINE
- - - 1/16TH SECTION
- - - DLC LINE

MAP BASES: WASHINGTON COUNTY TAX MAP 2N 2 29
2008 AERIAL PHOTO



THIS MAP WAS PREPARED FOR THE PURPOSE OF IDENTIFYING THE LOCATION OF A WATER RIGHT ONLY AND IS NOT INTENDED TO PROVIDE LEGAL DIMENSIONS OR LOCATION OF PROPERTY OWNERSHIP LINES.

EXPIRES : 12-31-2012

Project: 310-2-018
By: Kaid E. McKay
Checked by: EAU
Date: April 18, 2011