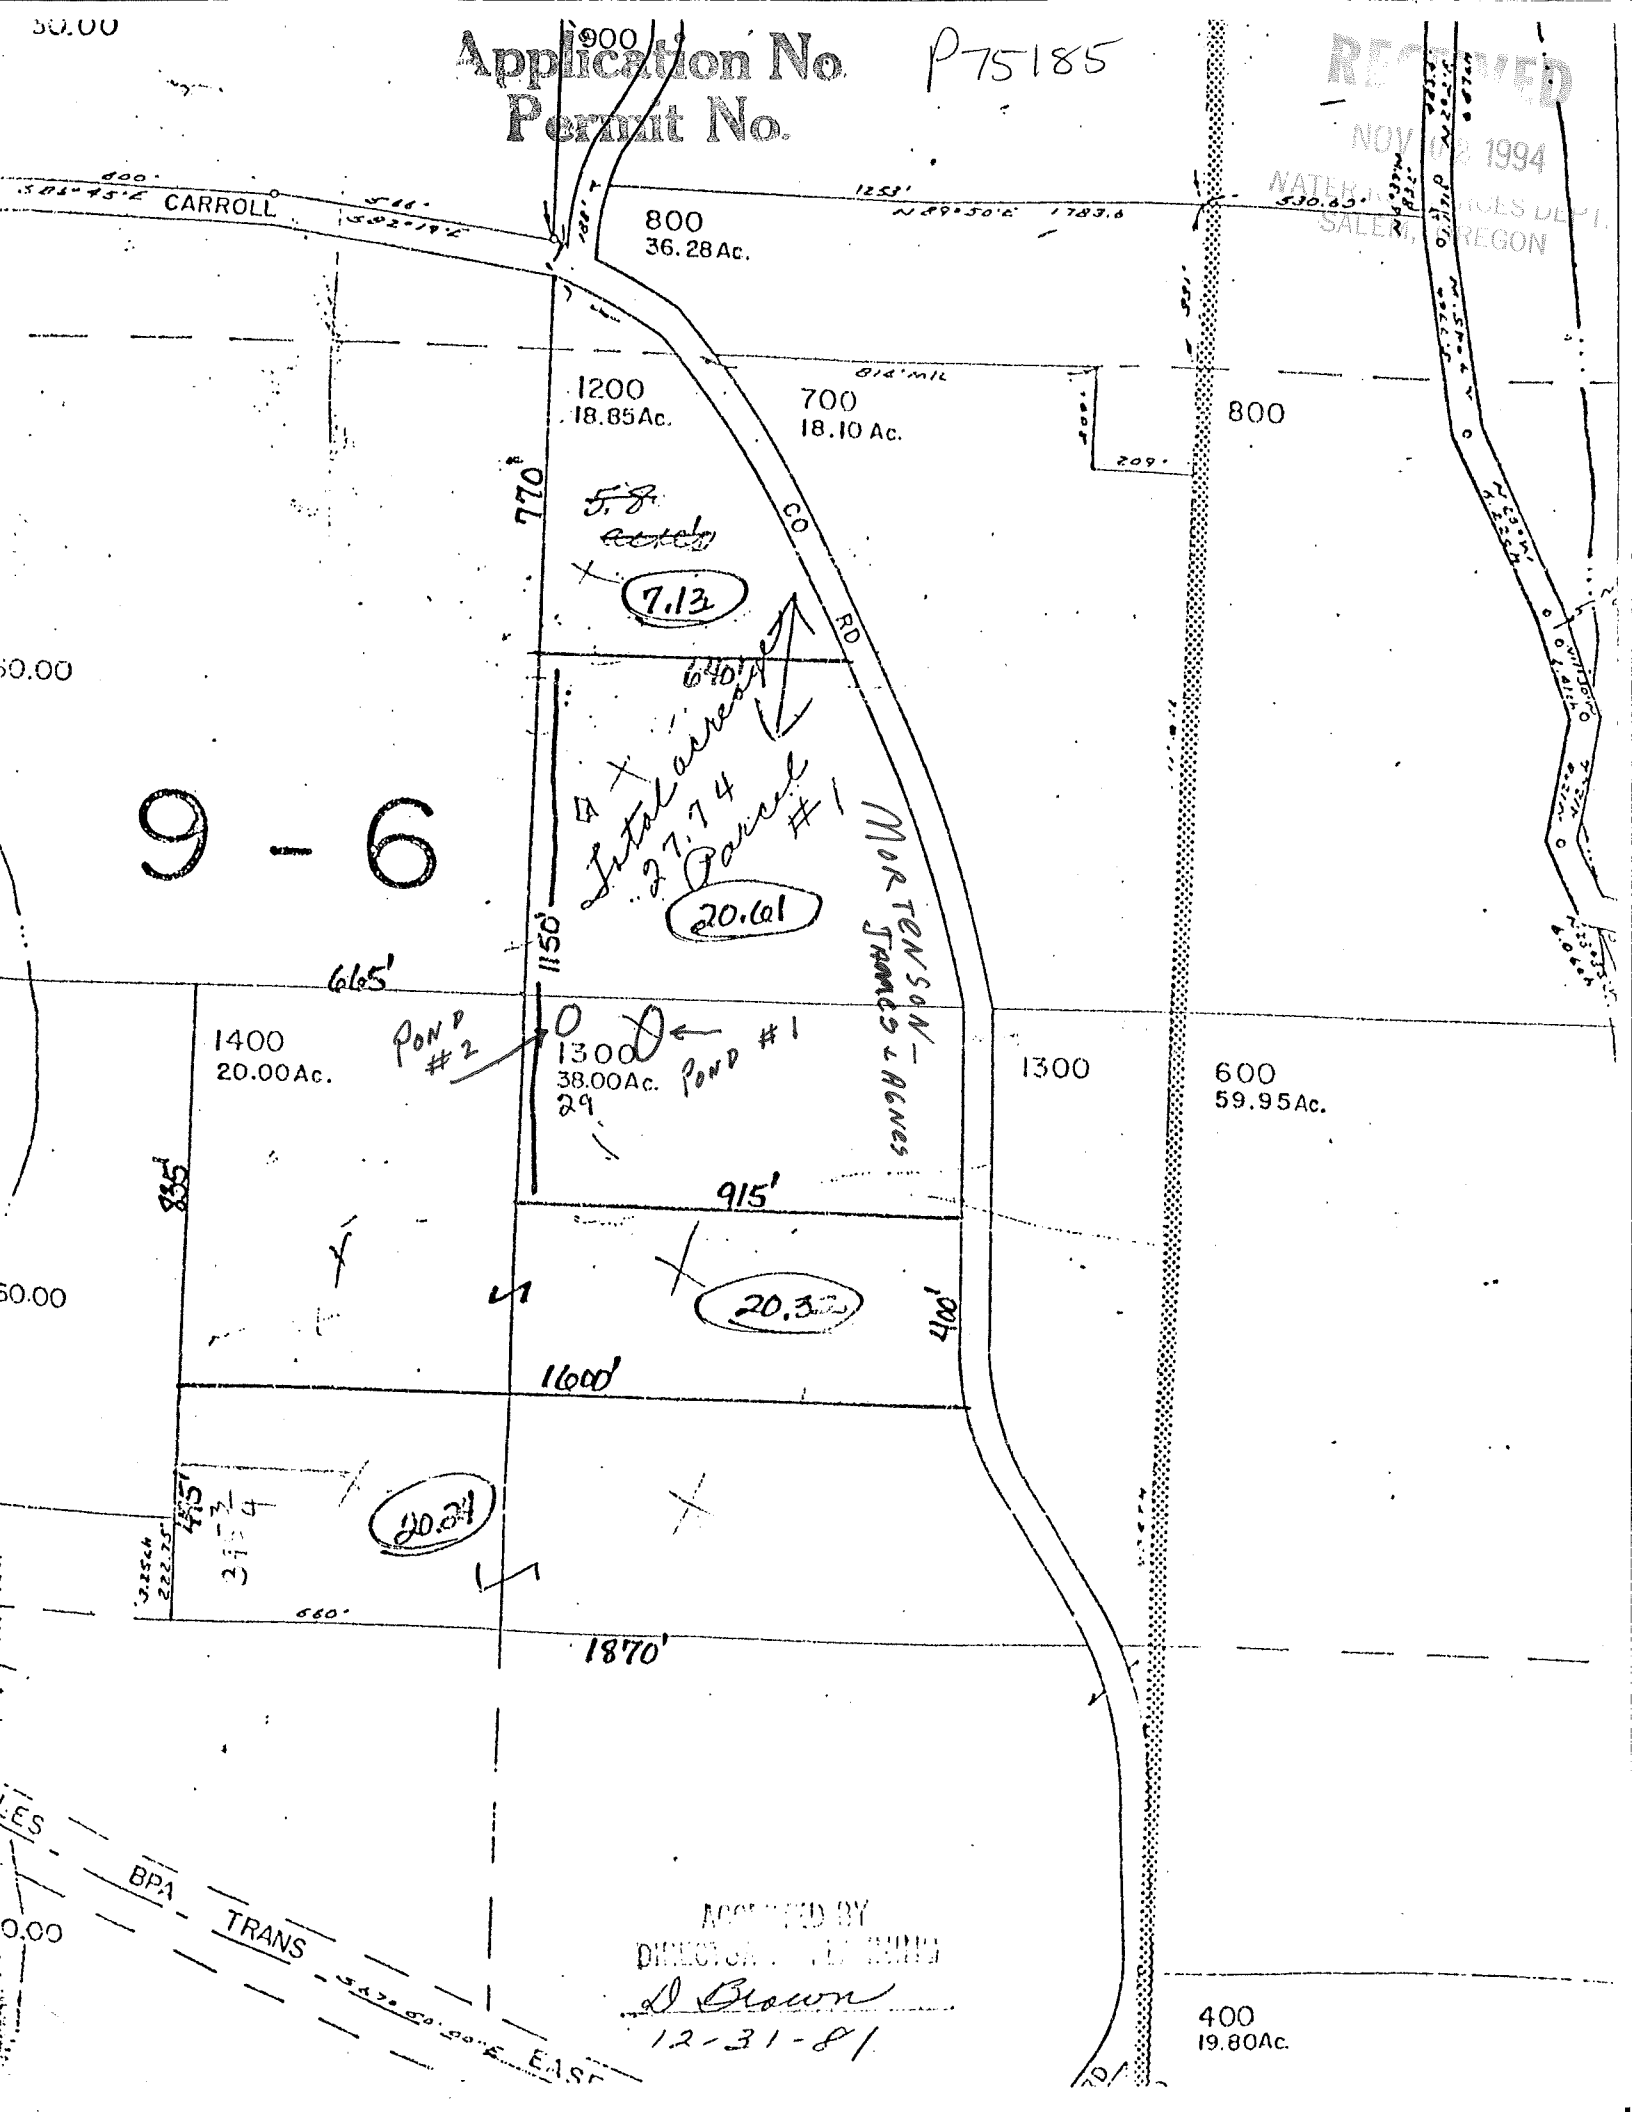
Application No. P75185
Permit No.
RECEIVED
NOV 02 1994
WATER RESOURCES DEPT.
SALEM, OREGON
CARROLL
800
36.28 Ac.
1200
18.85 Ac.
700
18.10 Ac.
800
CO RD
MORTENSON - JONES
9 - 6
7.13
20.61
20.34
1400
20.00 Ac.
1300
38.00 Ac.
POND #1
POND #2
1300
600
59.95 Ac.
400
19.80 Ac.
665'
1150'
915'
1600'
1870'
835'
400'
660'
BPA - TRANS
EAST
ACCEPTED BY
DIRECTOR
