


SEC.4 T.29S. R.7W. W.M.
DOUGLAS COUNTY
Scale 1" = 1000'

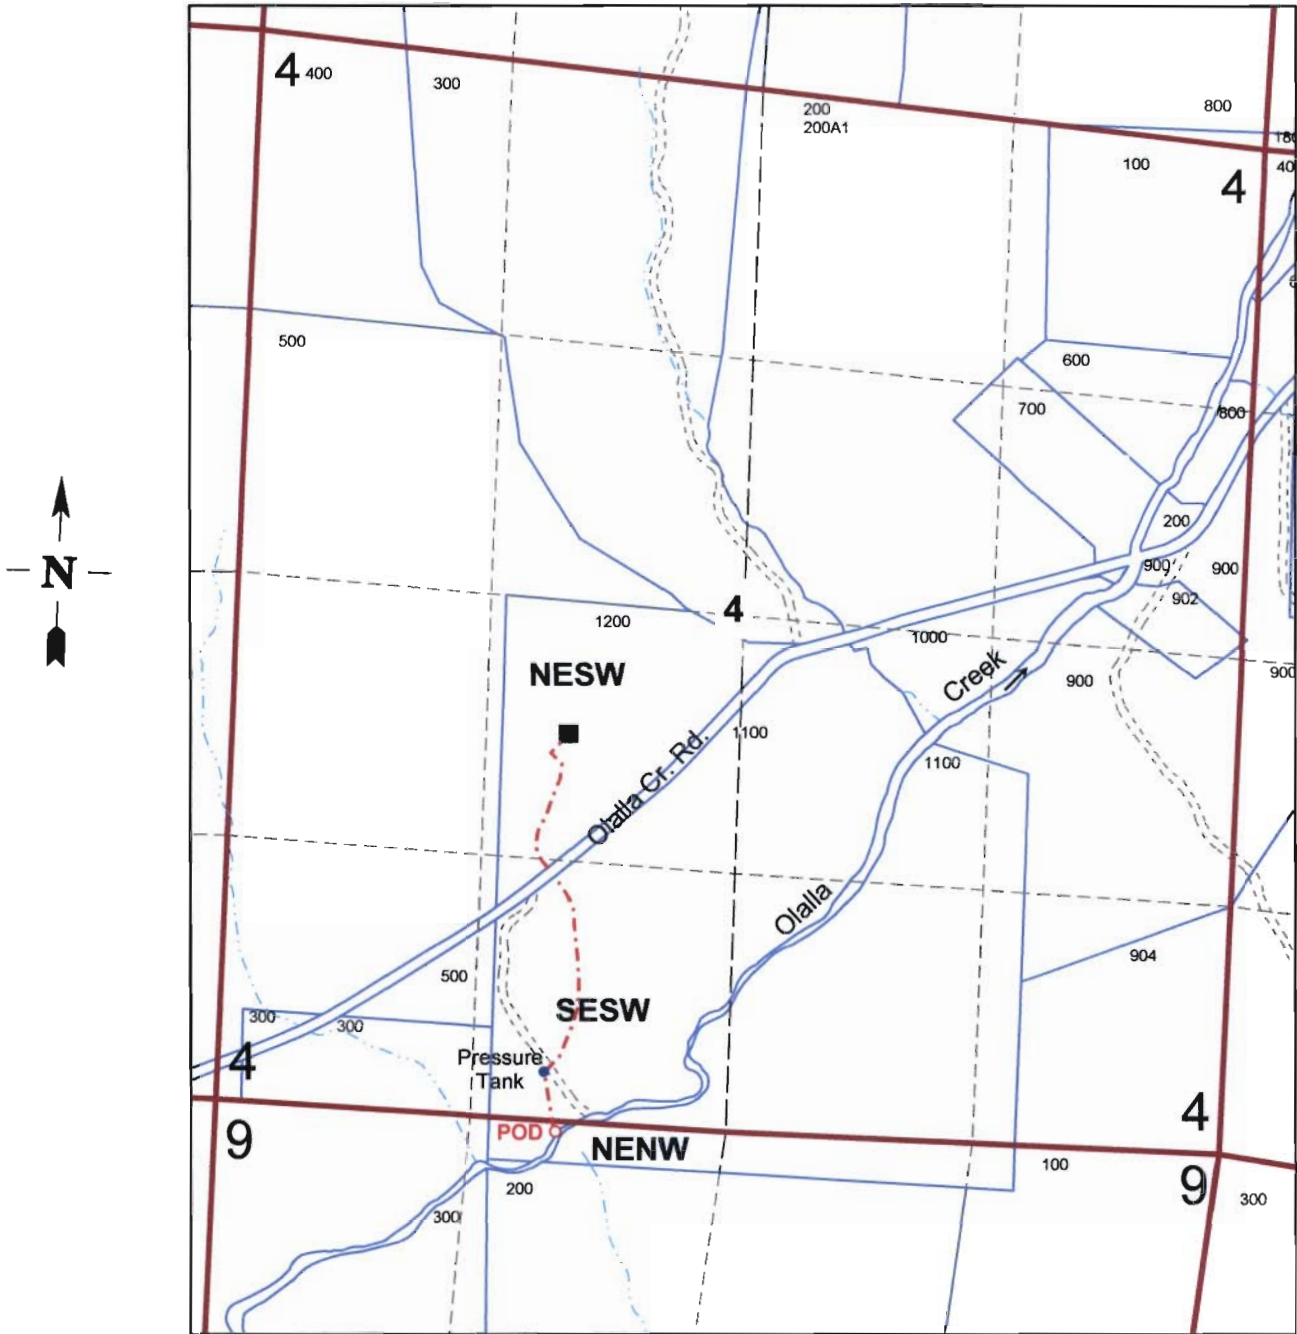

POD: 75 ft. S. and 1750 ft. E. from the NW corner of Section 9

RECEIVED

JUN 21 2011

WATER RESOURCES DEPT
SALEM, OREGON

S-87730