

Assignment Map # 1


SETTLEMENT MAP FOR KLAMATH CLAIM 144



NOTE ON SECTIONS 26, 28, & 29

- POD 1 [shaded box] land assoc. with POD 1
- POD 2 [shaded box] land assoc. with POD 2
- POD 3 [shaded box] land assoc. with POD 3

TOWNSHIP 37 SOUTH, RANGE 7 EAST, W.M.

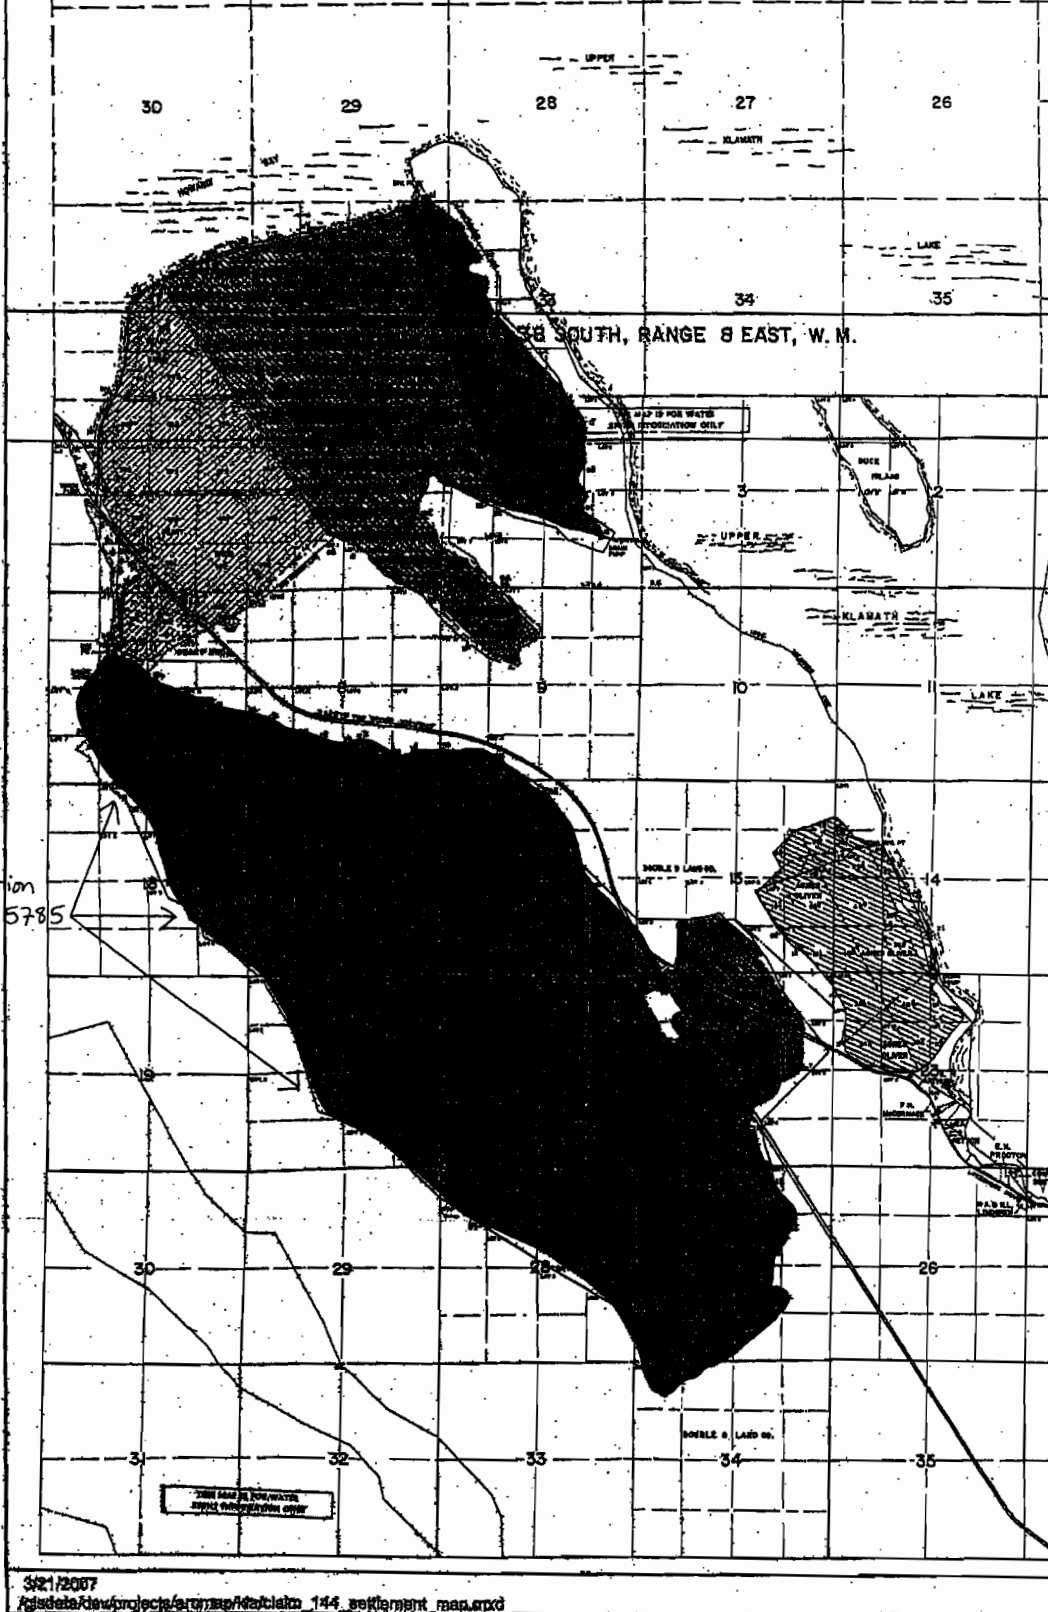

Assigned portion of Permit G-15785

RECEIVED

JUN 10 2011

WATER RESOURCES DEP
SALEM, OREGON

FINAL PROOF SURVEY MAP

RECEIVED

FEB 24 2008


WATER RESOURCES DEPT
SALEM, OREGON

Appl.# G-16175 Permit # G-15785
JELD-WEN TIMBER AND RANCHES

A Division of Jeld-Wen

T 38 S R 8 W, W.M. Section 27 & 34

Assignment Map #2

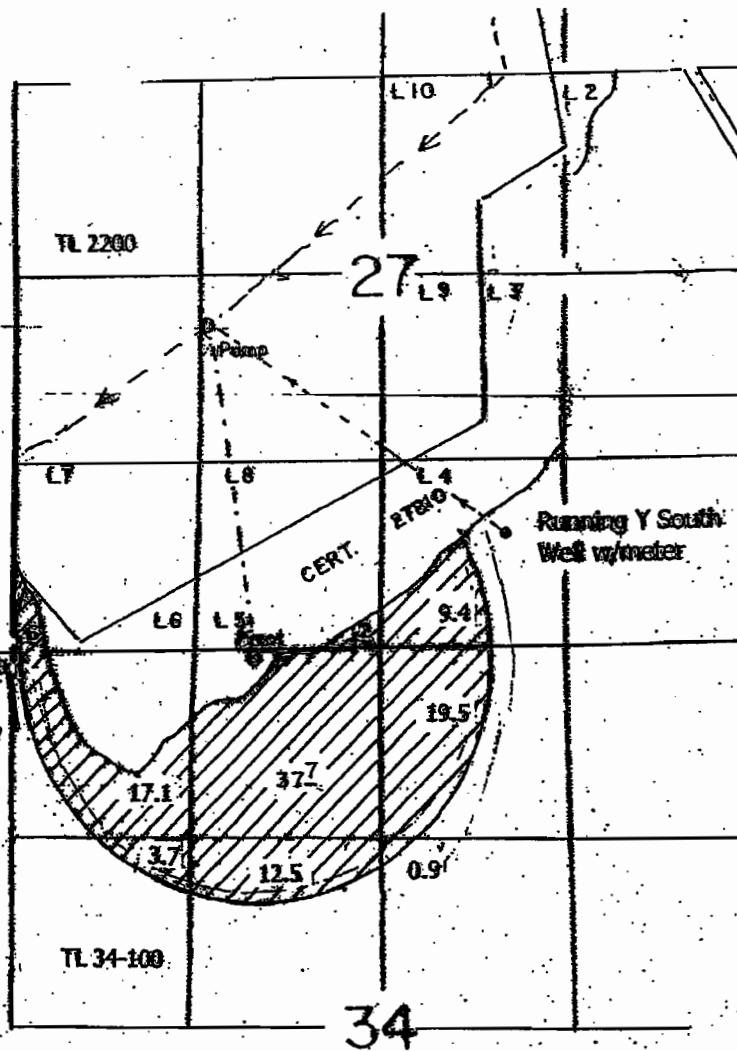

NORTH

Entire place of use assigned →

RECEIVED

JUN 10 2011

WATER RESOURCES DEPT
SALEM, OREGON

Running Y South Well: 800' N & 920' E
From the S 1/4 corner Section 27

Scale 1" = 1320'



This map is for water right purposes only.

RENEWAL DATE: 6/30/2009