

Assignment Map # 1


SETTLEMENT MAP FOR KLAMATH CLAIM 144




- POD 1  land assoc. with POD 1
- POD 2  land assoc. with POD 2
- POD 3  land assoc. with POD 3

TOWNSHIP 37 SOUTH, RANGE 7 EAST, W.M.

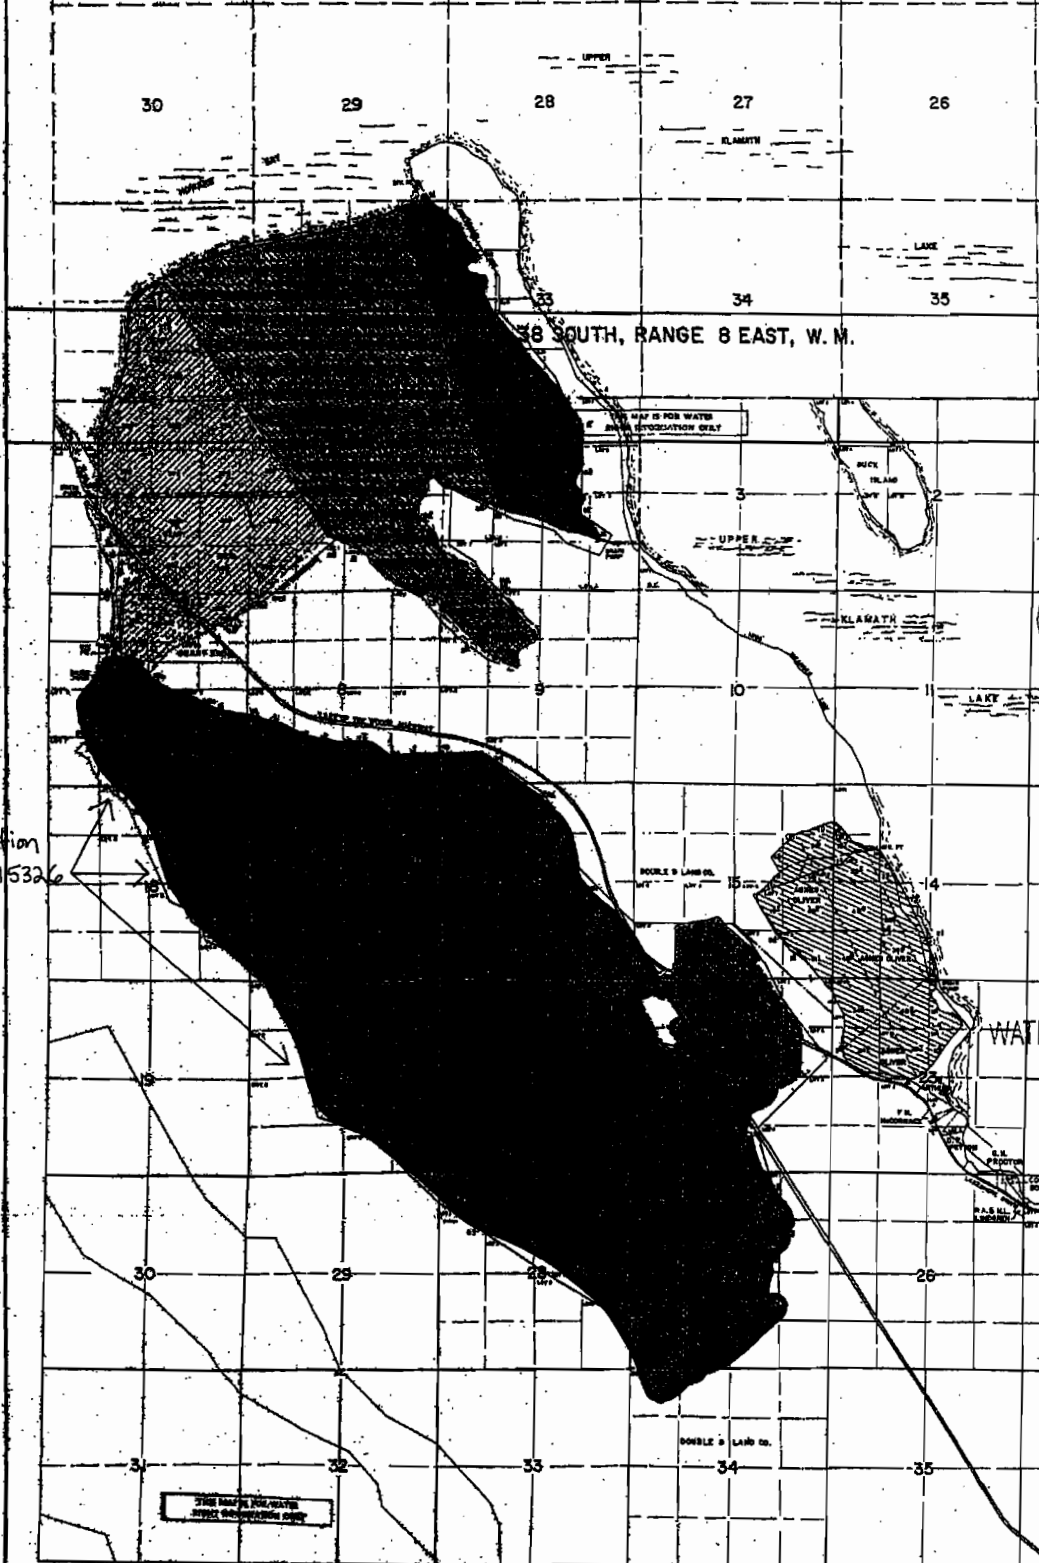

Assigned portion  
 of Permit G-15326

RECEIVED


JUN 1 11 2011

WATER RESOURCES DEPT  
 SALEM, OREGON

# FINAL PROOF SURVEY MAP

Appl.# G-15511 Permit # G-15326  
JELD-WEN TIMBER AND RANCHES  
A Division of Jeld-Wen  
T 38 S R 8 W, W.M. Section 27 & 34

Assignment Map #2

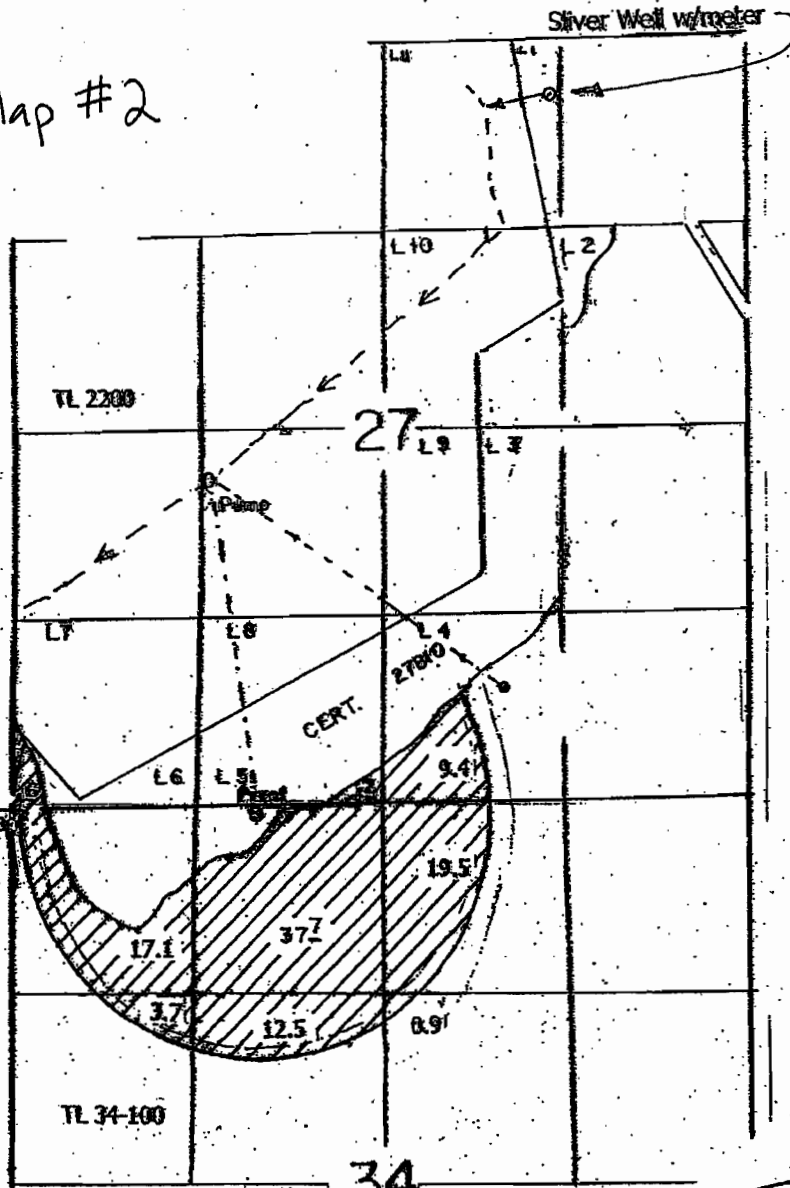

Entire place of use assigned →


RECEIVED

JUN 10 2009

WATER RESOURCES DEPT  
SALEM, OREGON

Silver Well: 4950' N & 1270' E  
From the S 1/4 corner Section 27

Scale 1" = 1320'

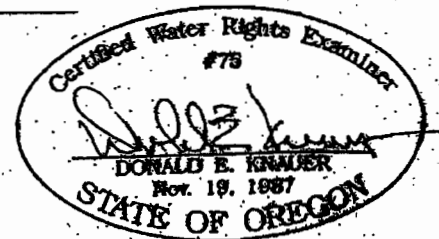

This map is for water right purposes only.

Received 6/10/2009