


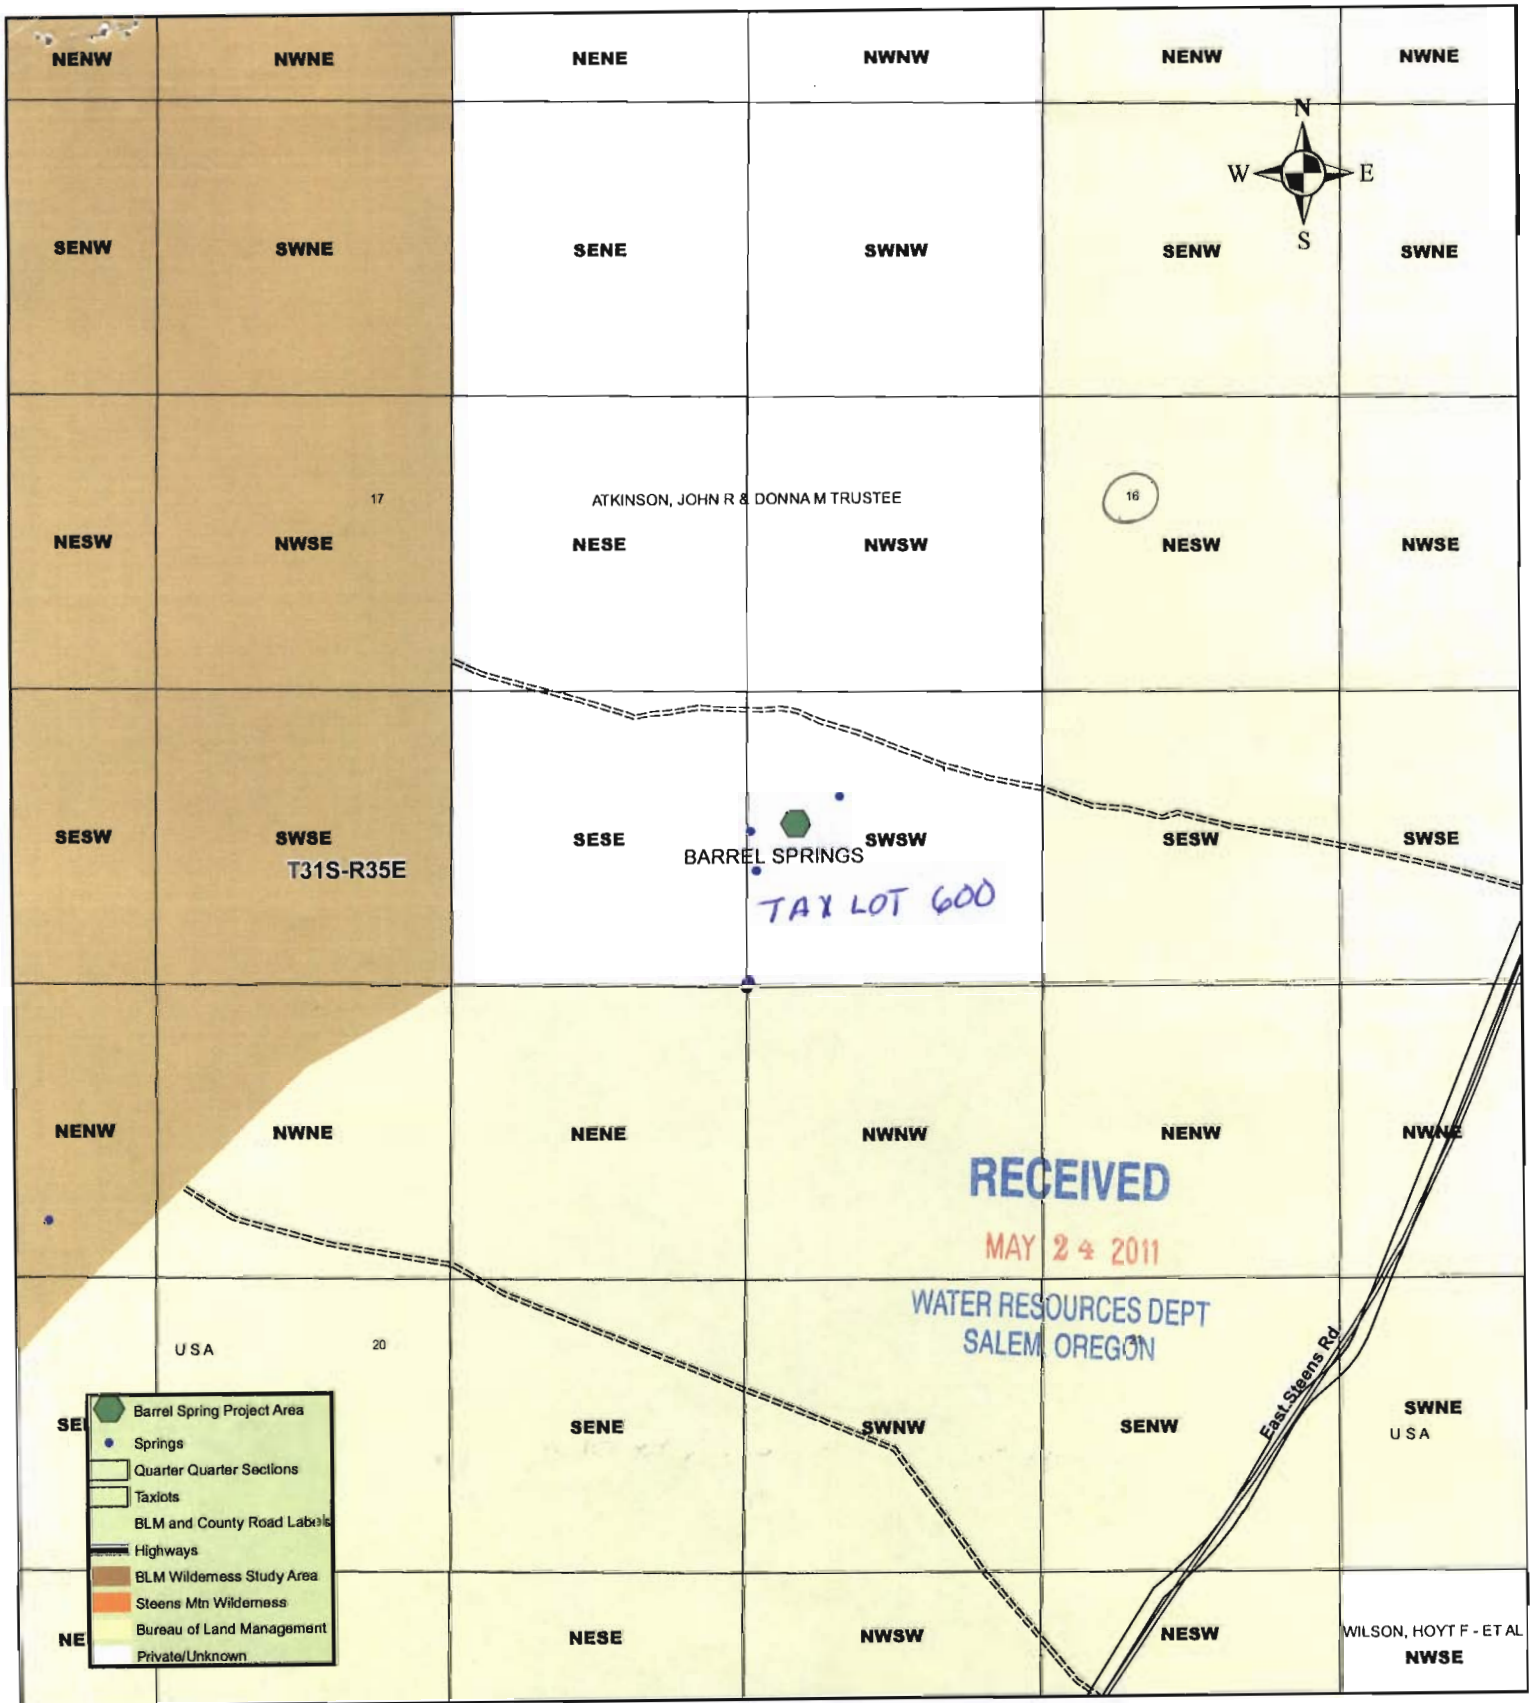

Barrel Springs

Source #1

RECEIVED

JUL 07 2011

0 0.0375 0.075 0.15 Miles

WATER RESOURCES DEPT
SALEM, OREGON



Note: No warranty is made by this Bureau of Land Management as to the accuracy, reliability or completeness of these data for individual or aggregate use with other data. Original data was compiled from various sources and may be updated without notification.



US DEPARTMENT OF THE INTERIOR
Bureau of Land Management
Burns District, Oregon

/workarea/yourname/nameofmxd.mxd
date

S-87736

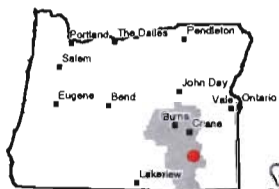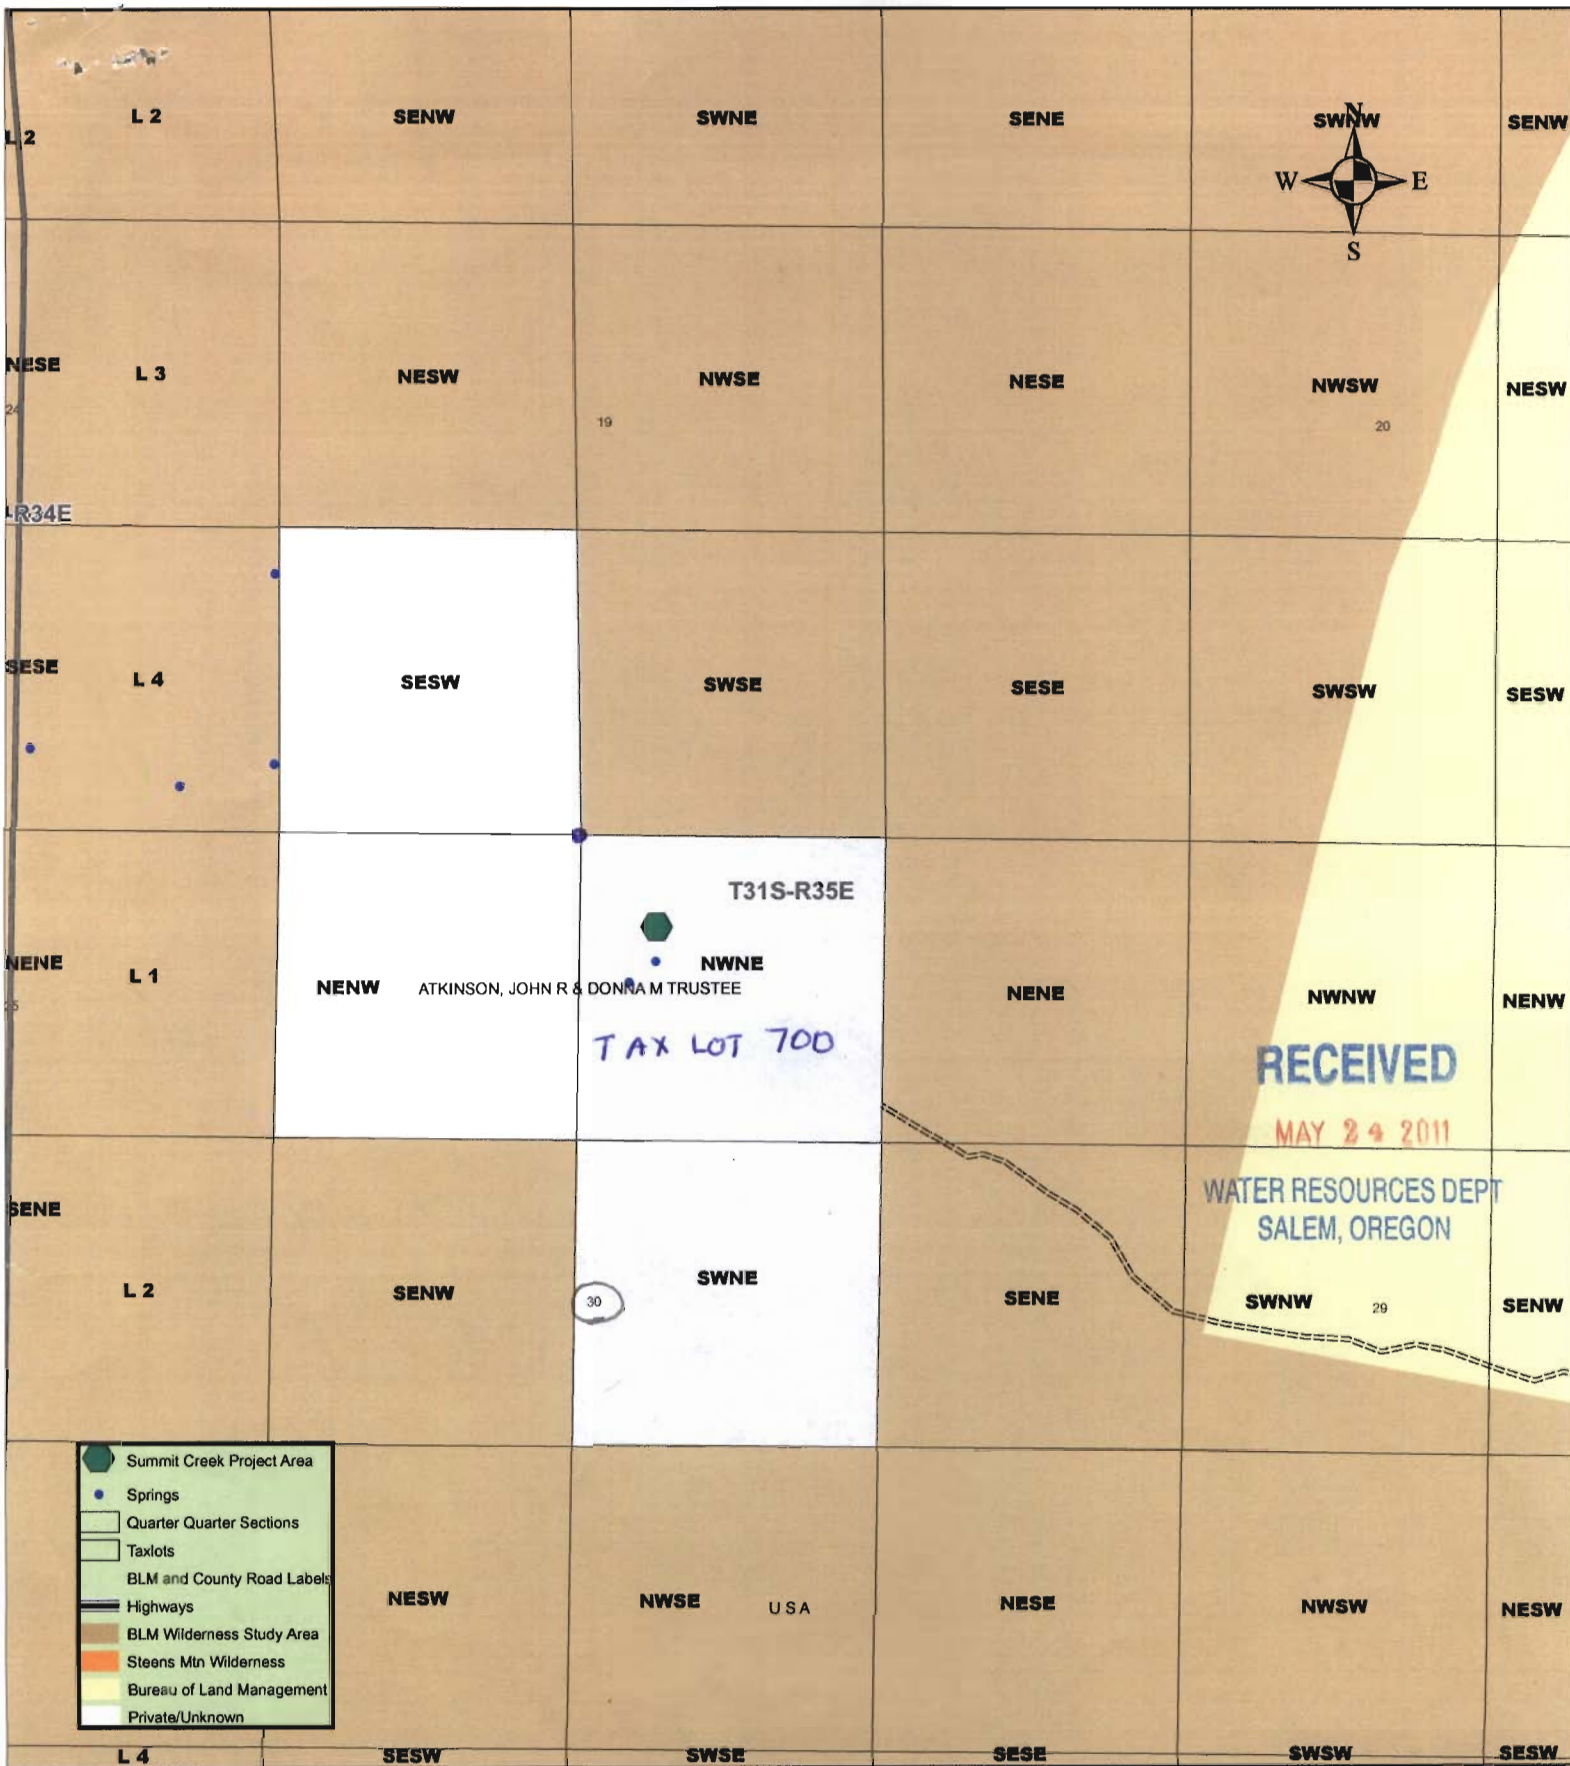

S-87736

Summit Creek **RECEIVED**

Source #2

JUL 07 2011

WATER RESOURCES DEPT
SALEM, OREGON

0 0.0375 0.075 0.15 Miles

Note: No warranty is made by the Bureau of Land Management as to the accuracy, reliability or completeness of these data for individual or aggregate use with other data. Original data was compiled from various sources and may be updated without notification.




US DEPARTMENT OF THE INTERIOR
Bureau of Land Management
Burns District, Oregon



Alternative B - Proposed Action

Installation of 3 troughs, 2 pipelines, and construction of a riparian fence along Stonehouse Creek using an adaptive management approach (including determination criteria for burying pipeline and fence construction)

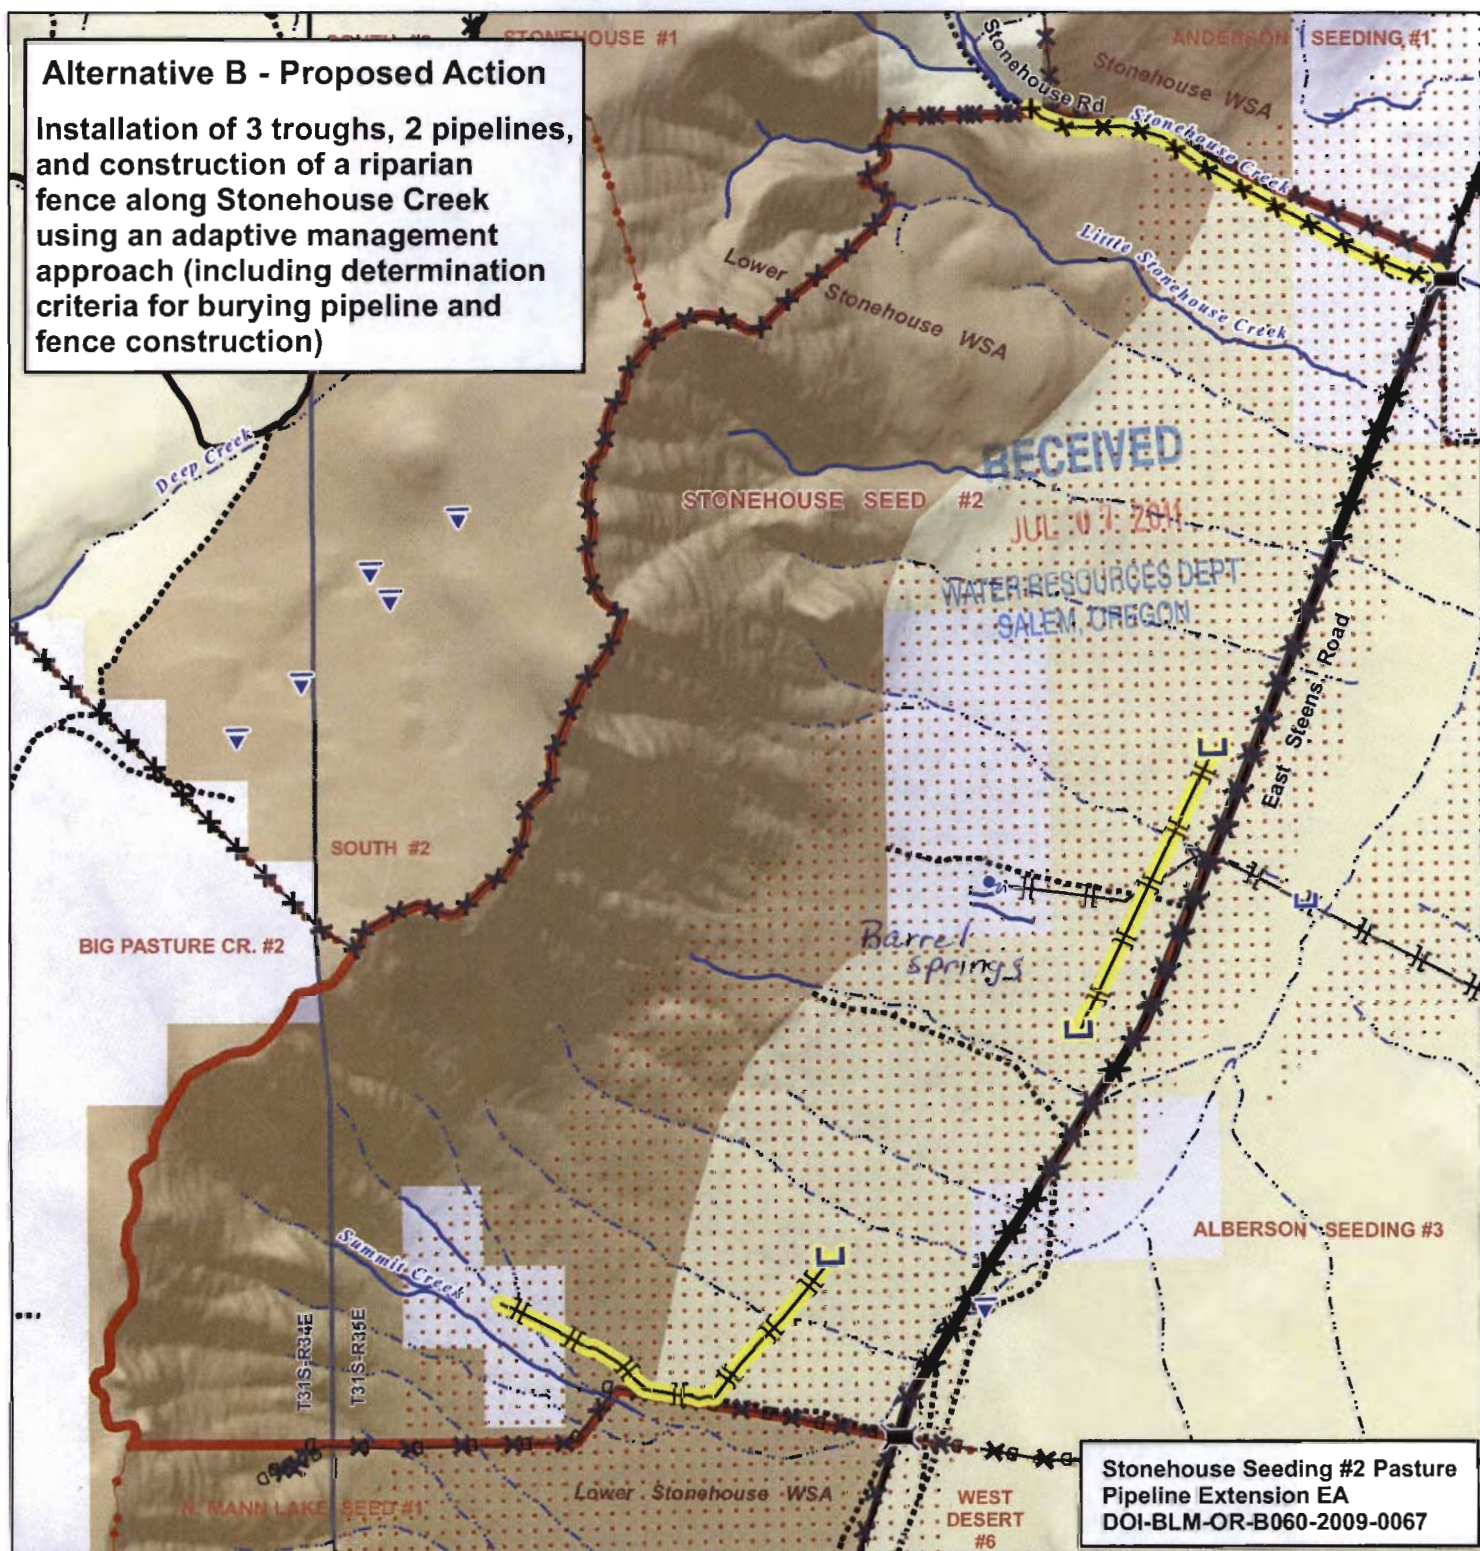

- | | | |
|-------------------------|---------------------|---------------------------|
| Stonehouse Seeding #2 | DRIFT FENCE | Cattle Guard |
| Adjacent Pastures | FENCE | Reservoir |
| Proposed Trough (3) | PIPELINE | Spring Development |
| Proposed Fence | Perennial Stream | Trough |
| Proposed Pipeline | Intermittent Stream | Bureau of Land Management |
| Non-Paved Improved Road | Range Seeding | Private |
| Primitive Road Surface | | BLM Wilderness Study Area |

US DEPARTMENT OF THE INTERIOR
Bureau of Land Management
Burns District, Oregon
Andrews Resource Area

Note: No warranty is made by the Bureau of Land Management as to the accuracy, reliability or completeness of these data for individual or aggregate use with other data. Original data was compiled from various sources and may be updated without notification.

StonehousePipelineEA/AltB.mxd
By K. Hazen, For D. Bingham, Nov. 2010


0.5 0.25 0 0.5 Miles

MAP SHOWING BOTH SITES & PIPELINE & PROPOSED PIPELINES
S-8776

31 S 35 E NW 1/4 NE 1/4
See 2 TAX LT 700

Location of each
Diversion Point
Brimley Springs
754 feet N, 0 ft E,
of the SW corner
of Section 16.

Summit Creek
2302 feet W,
545 feet S,
of the NE corner
of Section 30.

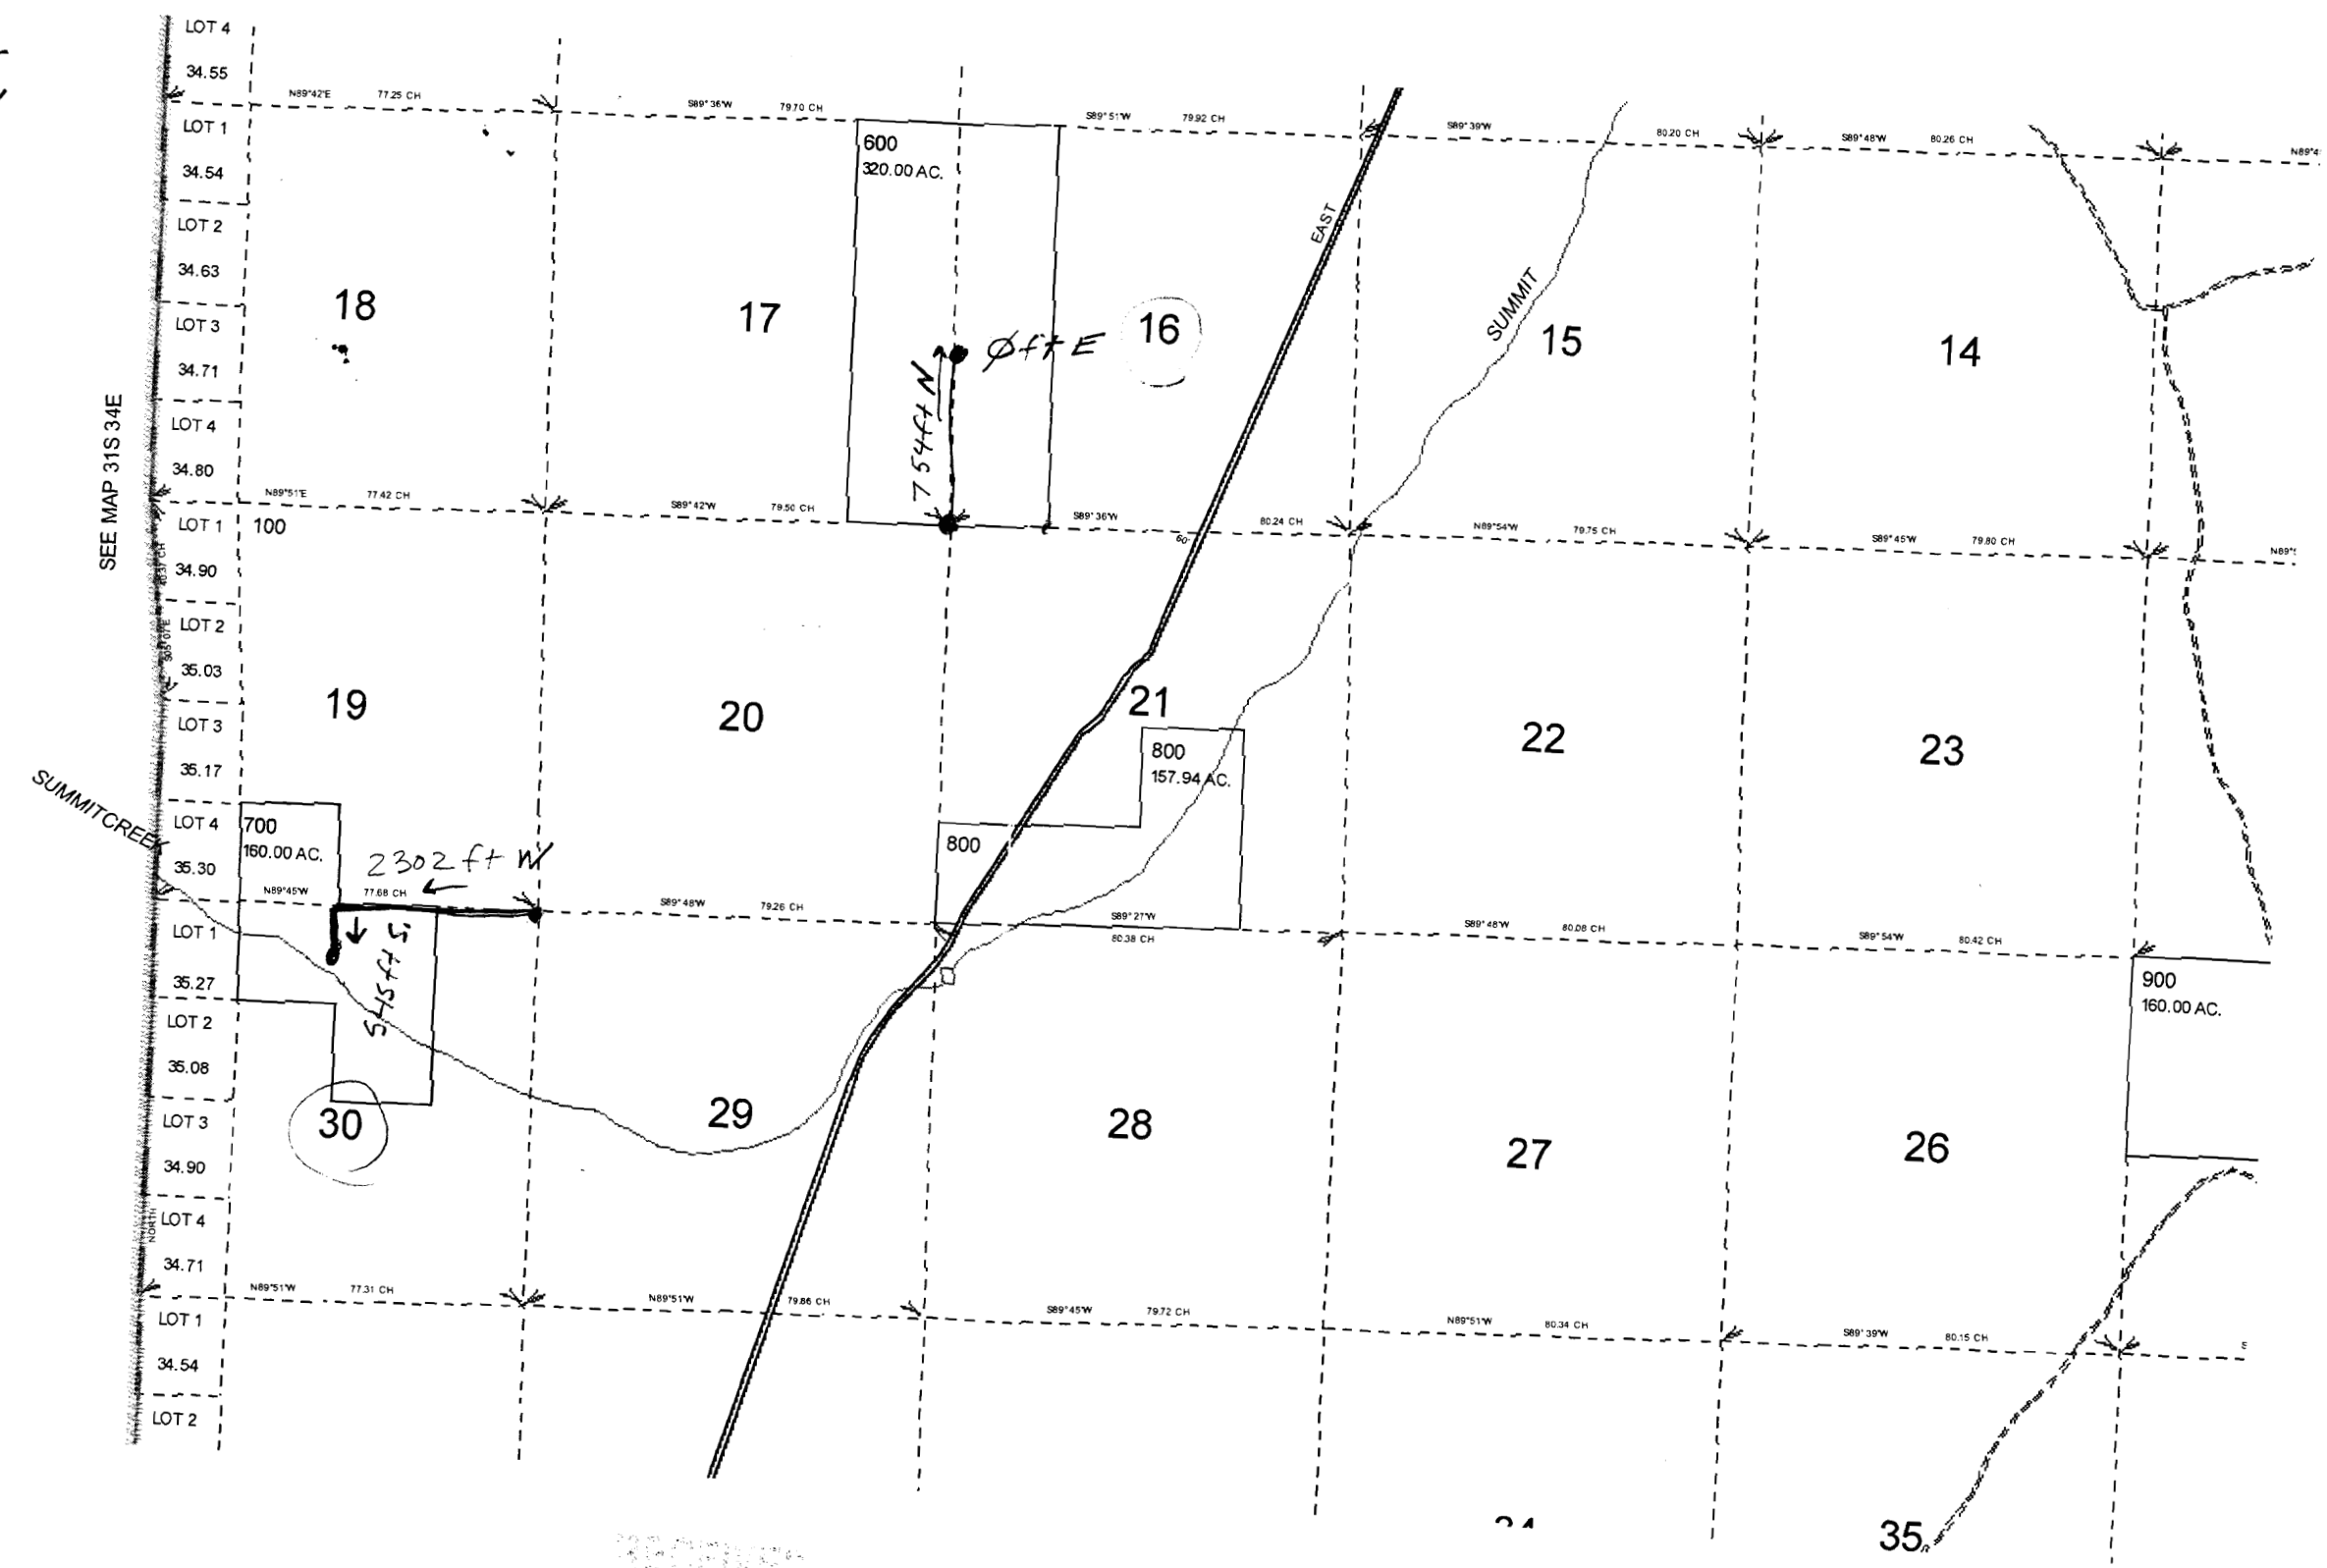

