


Approved through  
ZON 2010-01715

# Proposed Reservoir 35-4W-33-300

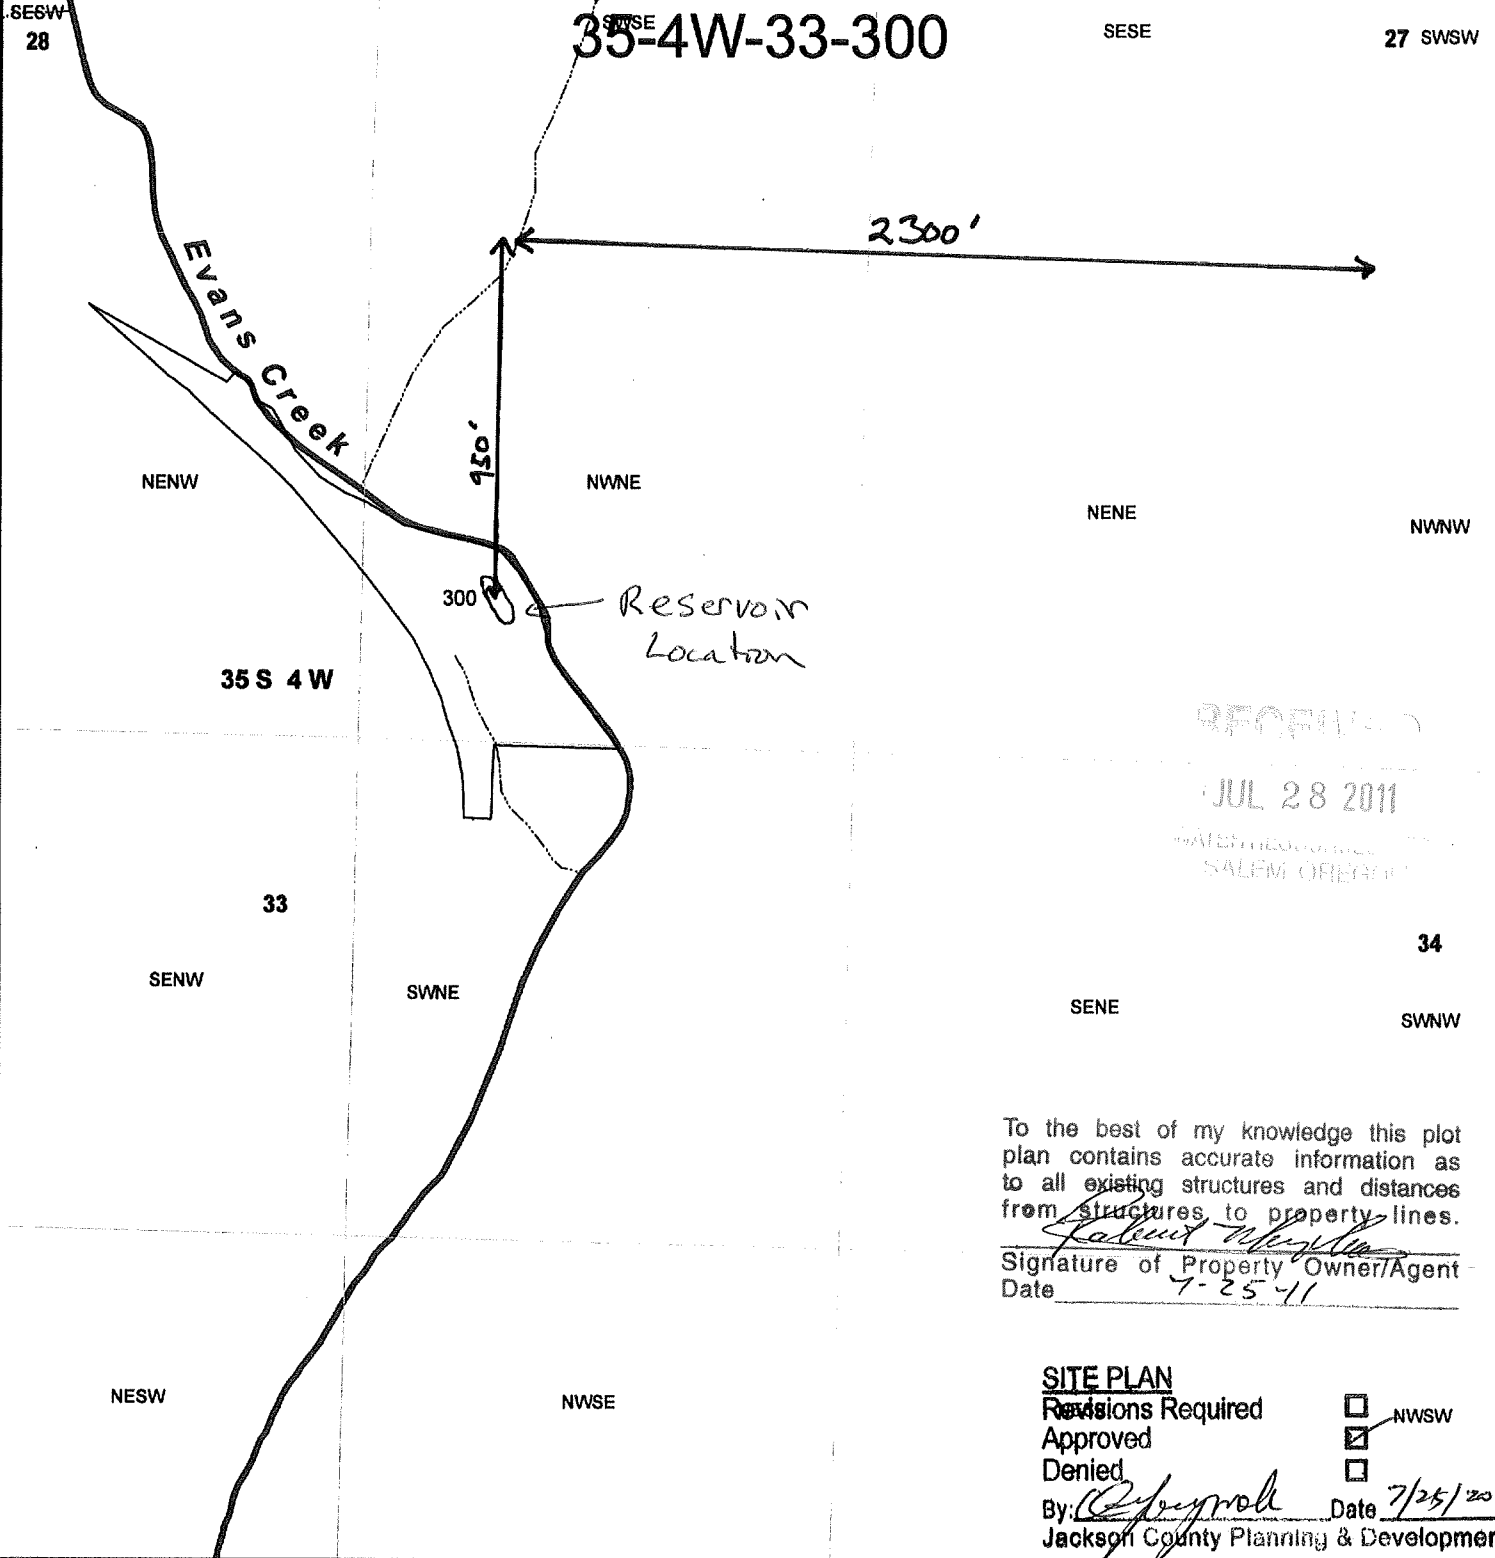

JUL 28 2011  
Salem Oregon


To the best of my knowledge this plot plan contains accurate information as to all existing structures and distances from structures to property lines.

*[Signature]*  
Signature of Property Owner/Agent  
Date 7-25-11

**SITE PLAN**

Revisions Required  NWSW  
 Approved   
 Denied

By: *[Signature]* Date 7/25/2011  
 Jackson County Planning & Development

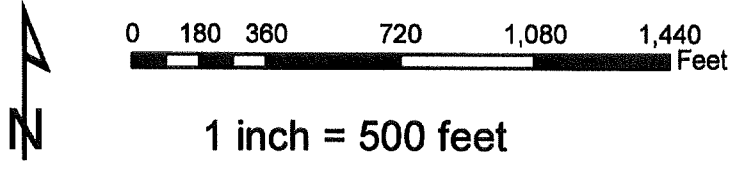

**Legend**

Tax Lot       Sections  
 Townships       Quarter quarters

R-87740

# Proposed Reservoir 35-4W-33-300

SESW  
28

SESE

27 SWSW

Evans Creek

2300'

NENW

NWNE

NENE

NWNW

950'

Reservoir Location

35 S 4 W


JUL 28 2011

WATER RESOURCES  
SALEM, OREGON

33

34

SESW

SWNE

SENE


SWSW

NESW

NWSE

NESE


NWSW

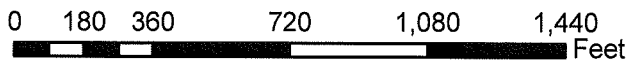

1 inch = 500 feet


R-87740

## Legend

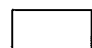 Tax Lot

 Sections

 Townships

 Quarter quarters