G-1449

OWRD Basic Web Mapping Application (beta)

Locate a place on the map ▸ Use Advanced Map ▸ Help ▸ Links ▸

Zoom In | Zoom Out | Pan | Full Extent | Identify

- OWRD Data
- Base Data
- Imagery

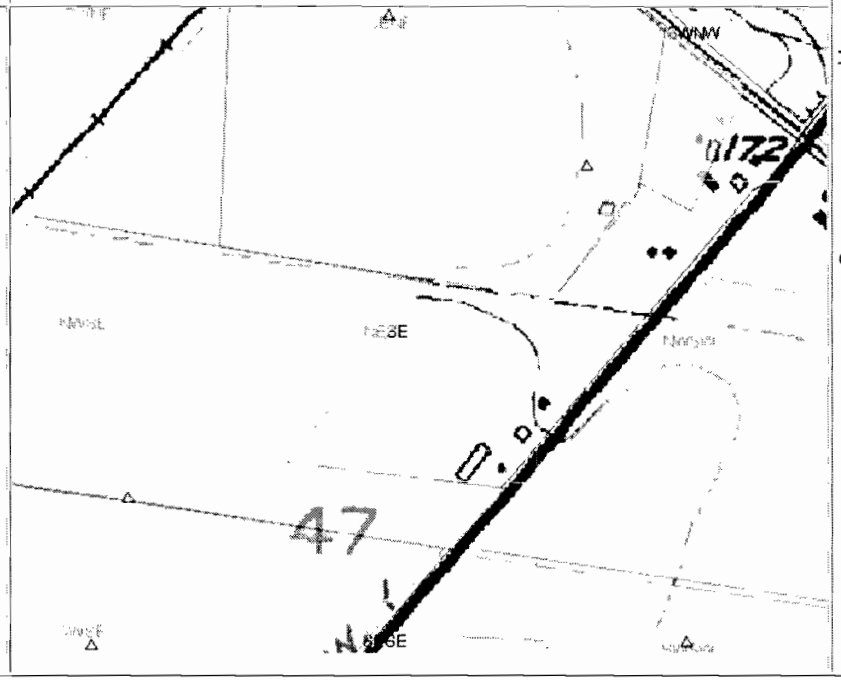

Selected Point

Latitude: 45.090961 , Longitude: -122.909437
Oregon Lambert Coordinate: 690211.10, 1226932.88
Perform a peak discharge estimate at this point
This point is located in the following TRSQQ:

TRSQQ: 05.00S-02.00W-34-NESE

County: Marion
Basin: Willamette
WM District: 16
WM Region: NW
Withdrawn Area:
WAB: PUDDING R > MOLALLA R - AB MILL CR (151)
Priority WAB:
Rule 4D: Rules apply
Groundwater Restricted:
Scenic Water Way:
Division 33: LOWER COLUMBIA
Water Quality Limited:
Water Rights: See Water Rights in this section (Platcard)
Well Logs: See Well Logs in this section

JUL 29 2011

K. Kalugin

LEGEND

LINE TYPES

TAX LOT BOUNDARY	OLD PROPERTY LINE
ROAD RIGHT-OF-WAY	VACATED RIGHT-OF-WAY
RAILROAD	RAILROAD RIGHT-OF-WAY
STREAM, LAKE, ETC. TAX LOT BOUNDARY	STREAM, LAKE, ETC. NON-BOUNDARY
SUBDIVISION BOUNDARY	PARTITION PLAT HDY.
TAX CODE BOUNDARY	EASEMENT

SYMBOL TYPES

D.L.C.

CONTROL POINTS

SURVEY MONUMENTS

G.L.O. CORNERS

SECTION 1/4 SEC 1/16 SEC

NUMBERS

TAX CODE NO.

000 00 00 0

ACREAGE – ALL ACREAGES EXCLUDE ANY PORTION THAT MAY LIE WITHIN THE INDICATED PUBLIC RIGHT OF WAYS.

TICK MARKS – WHEN A TICK MARK IS INDICATED ON THE EXTENSION OF A LINE, THEN THE DIMENSION GOES TO THE TICK MARK. GENERALLY THIS IS USED WHEN DIMENSIONS GO INTO PUBLIC RIGHT OF WAYS.

226.00
169.00

ARROWS ARE USED WITH DIMENSIONS IN AREAS OF GREATER COMPLEXITY.

NOTICE: This map was created for Assessor's Office use ONLY.

G-17479
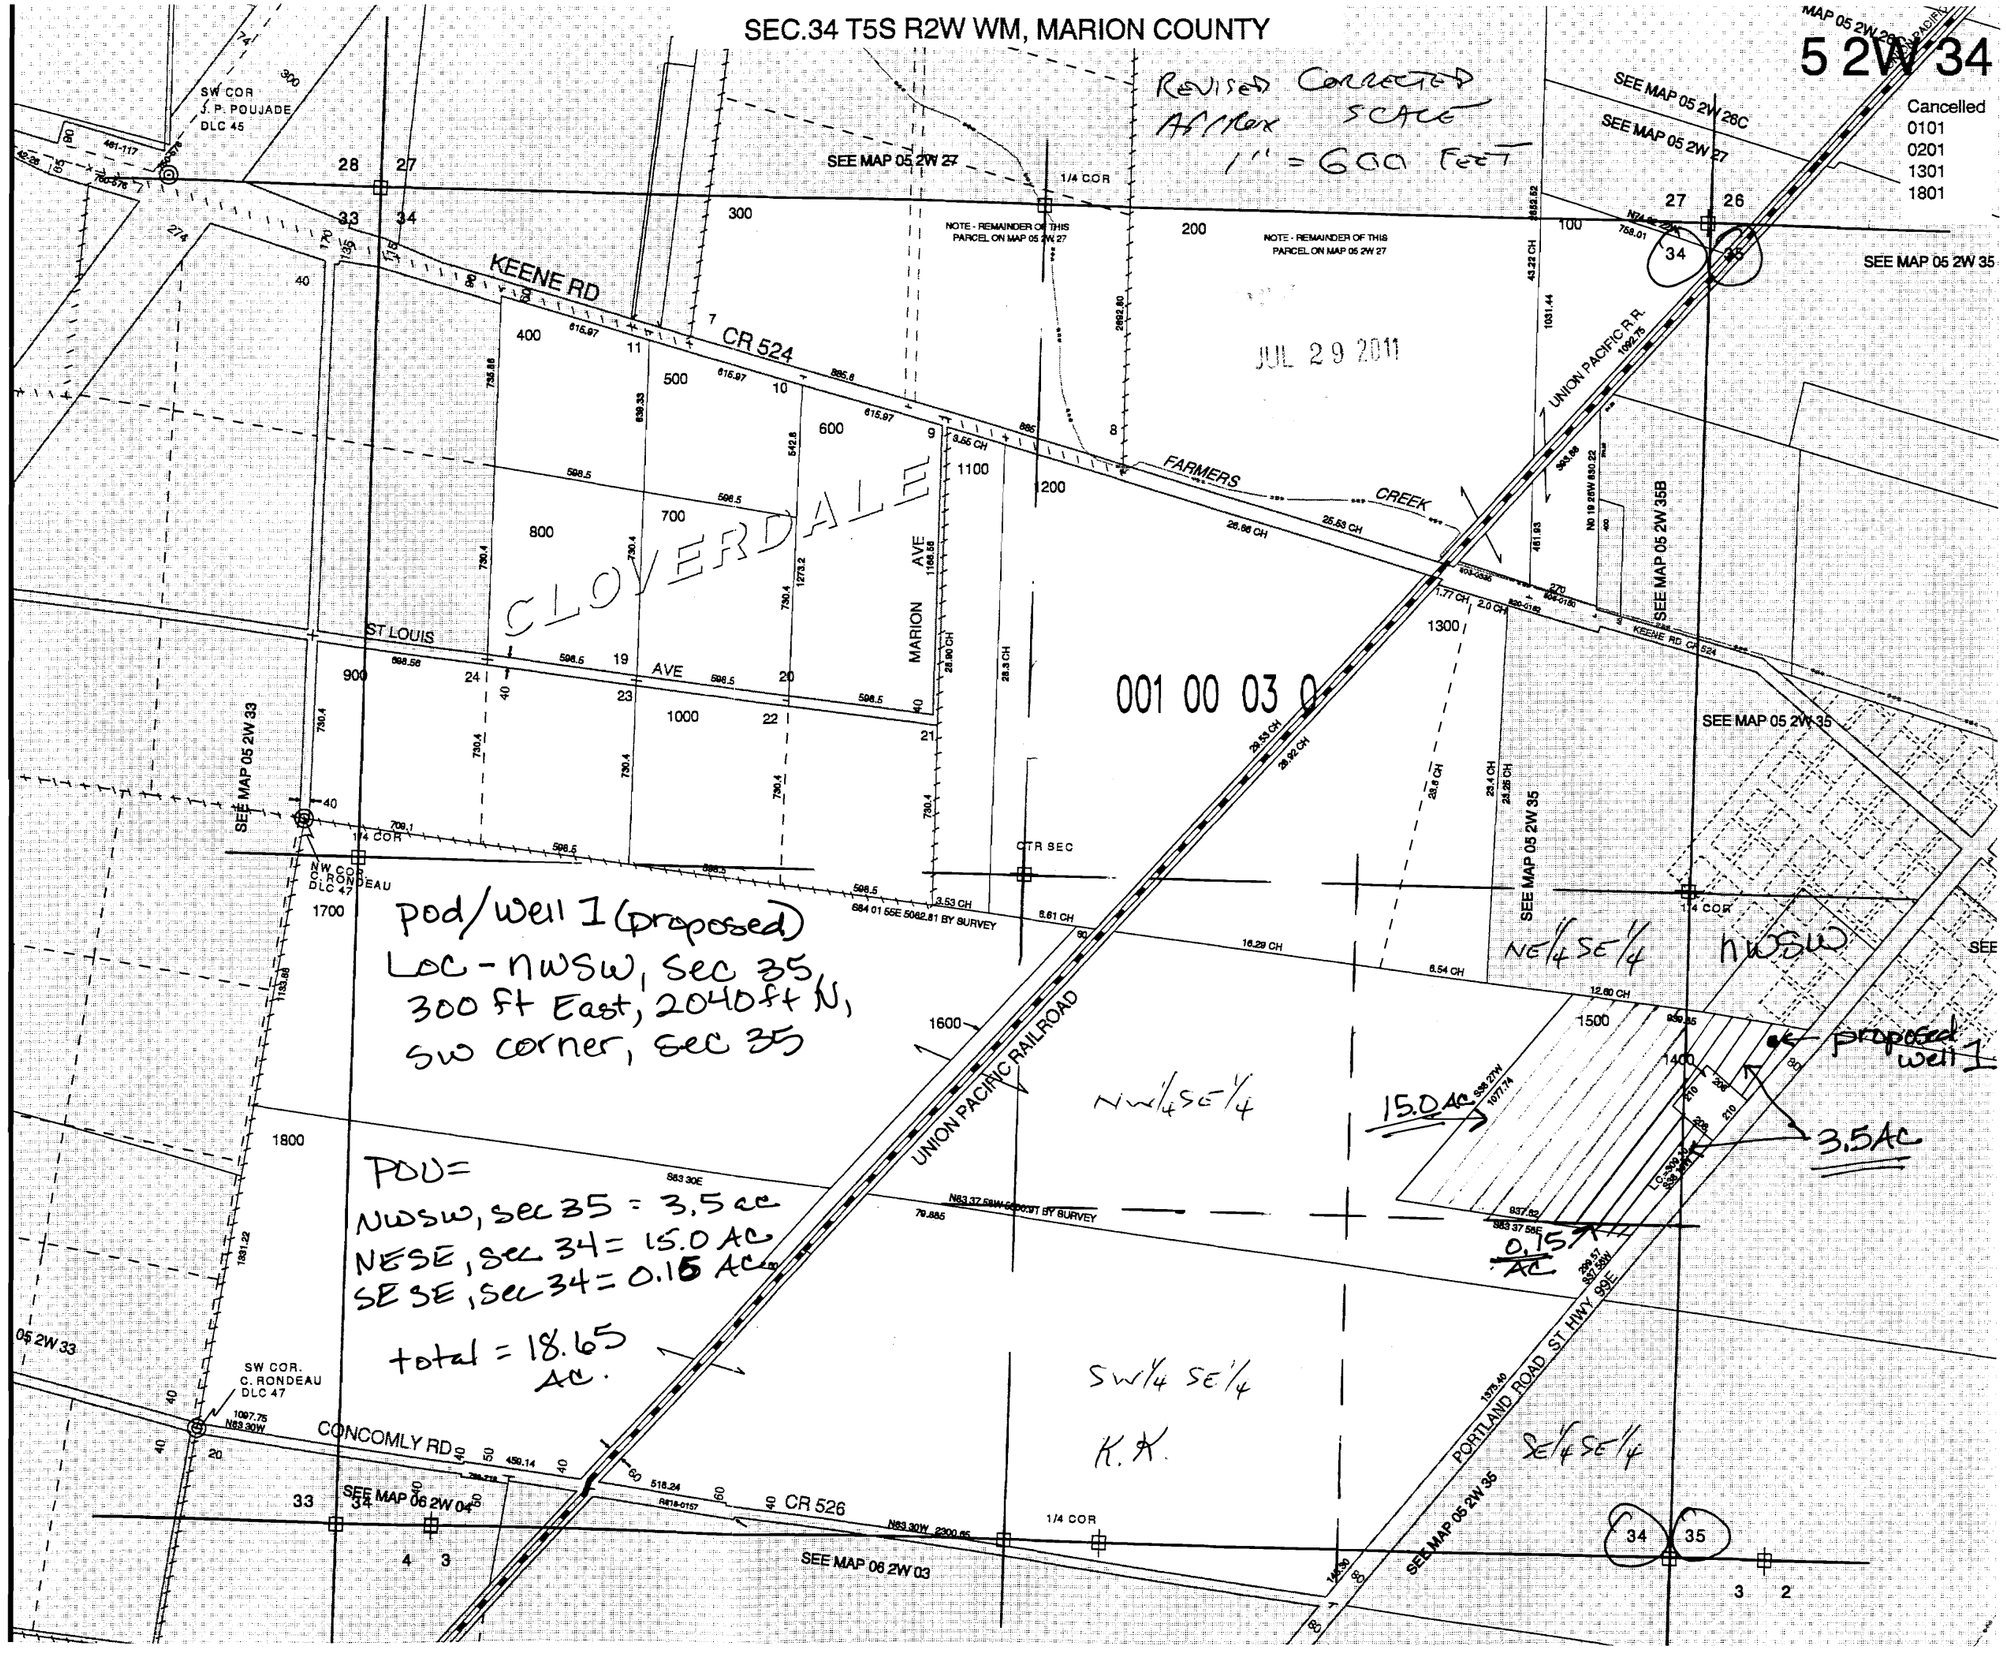
Assessor "We Care" GIS Geographic Information System