


Section 9, Town. 8 S., Range 2 E.

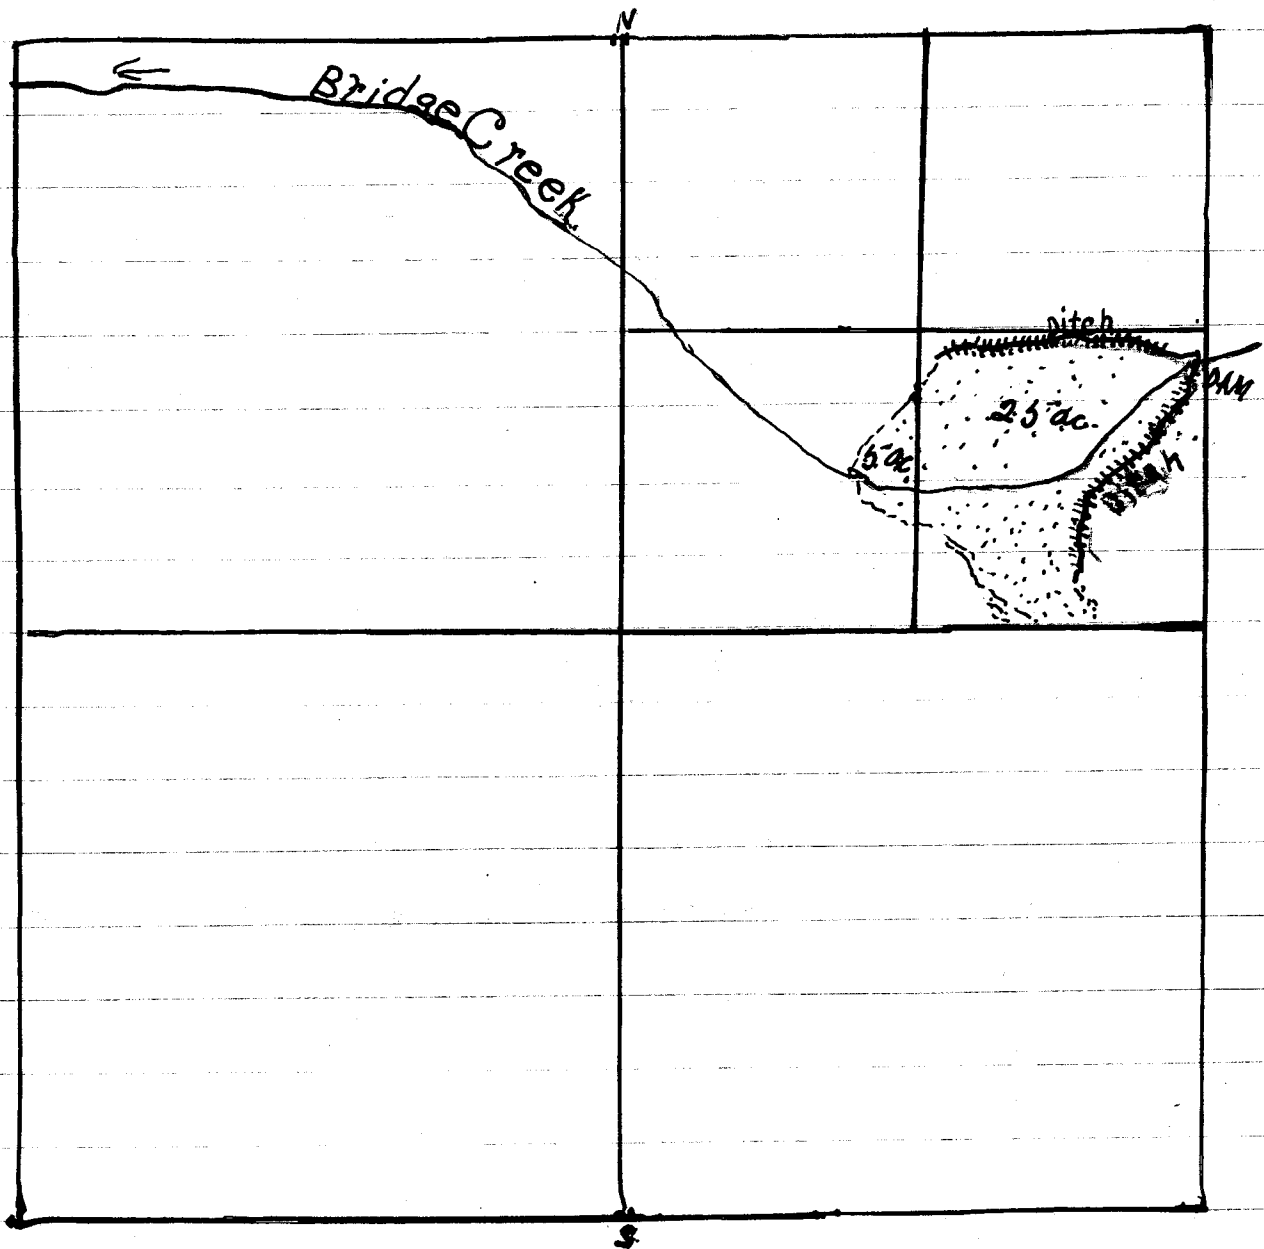

Marty's Irrigation System showing ground actually irrigated.