

WATER RESOURCES DEPT
SALEM OREGON 503743

AUG 12 2011


RECEIVED



1" = 200'

CORRECTED, REVISED, APPROX.

WORK COST
TOTAL 9 ACRES PRIMARY

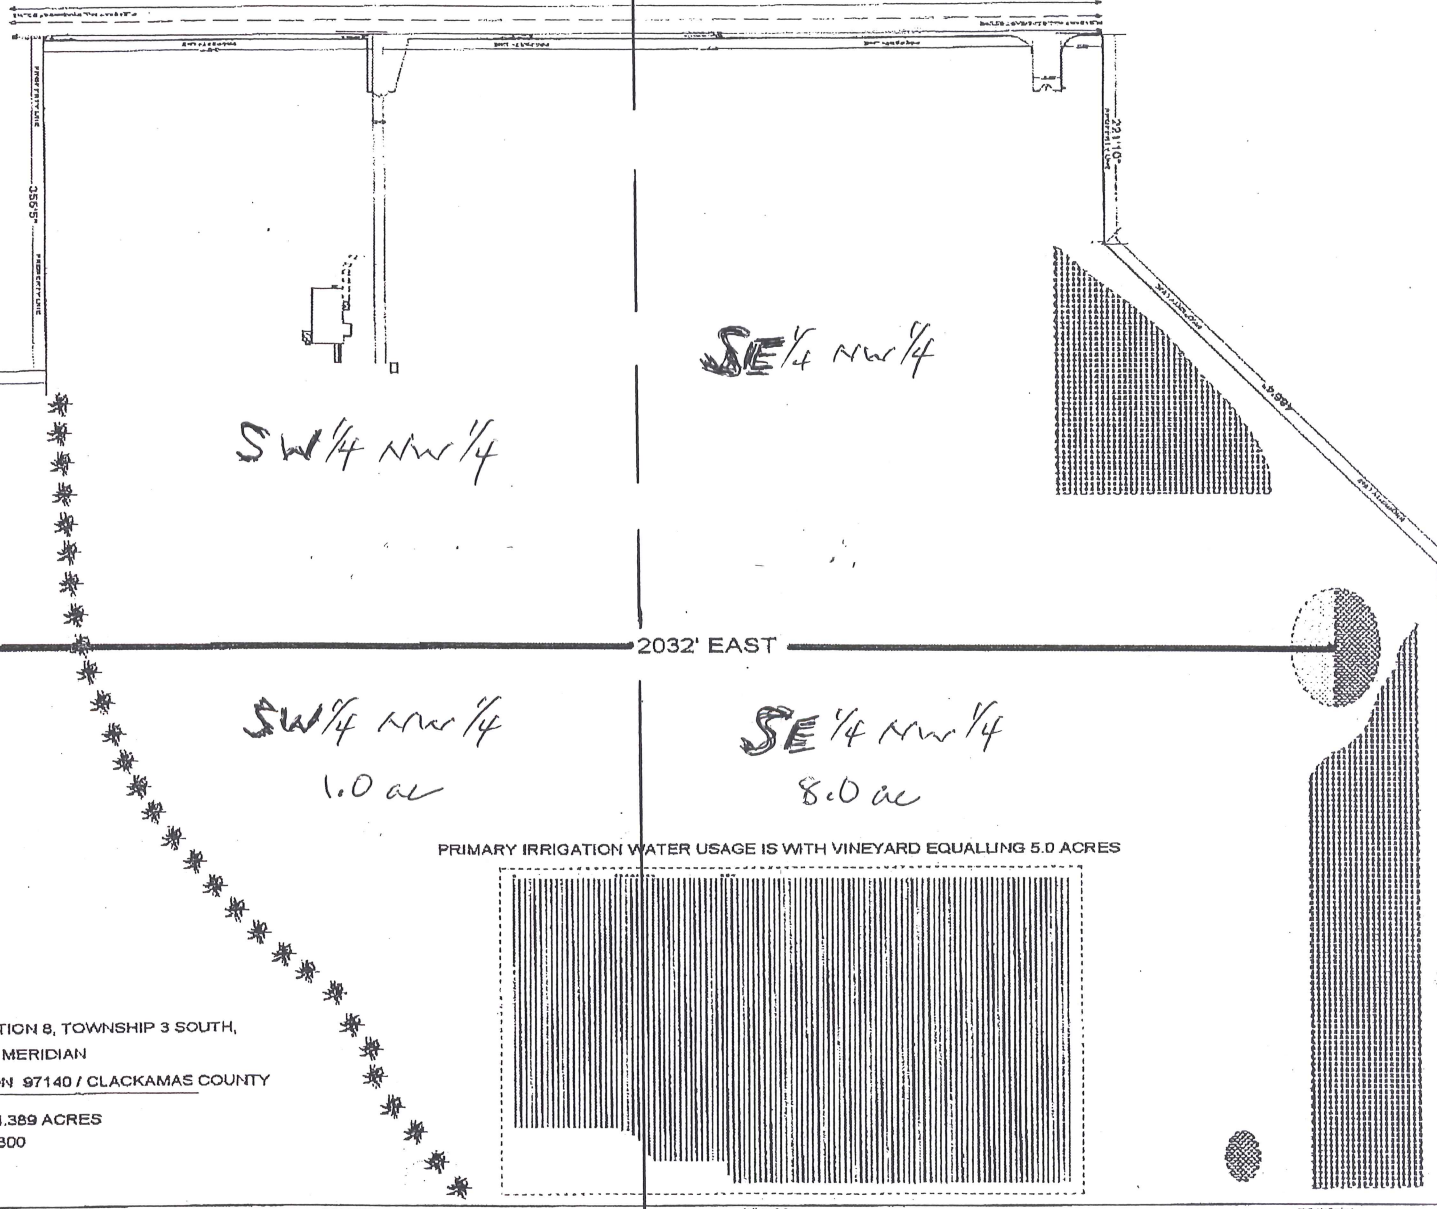

SW 1/4 NW 1/4

SE 1/4 NW 1/4

SW 1/4 NW 1/4
1.0 ac

SE 1/4 NW 1/4
8.0 ac

PRIMARY IRRIGATION WATER USAGE IS WITH VINEYARD EQUALING 5.0 ACRES

A TRACT OF LAND IN THE NORTHWEST 1/4 OF SECTION 8, TOWNSHIP 3 SOUTH,
RANGE 1 WEST, WILLAMETTE MERIDIAN
18110 SW PLEASANT HILL ROAD / SHERWOOD, OREGON 97140 / CLACKAMAS COUNTY


PROPERTY EQUATES OUT TO 54.389 ACRES
PROPERTY TAX LOT # 1300
E.F.U. 305-01

1/4 CORNER

NW1/4 SEC 8 T35 R1W WM.
CLACKAMAS COUNTY

3 1W 89

This map was prepared for
assessment purposes only.

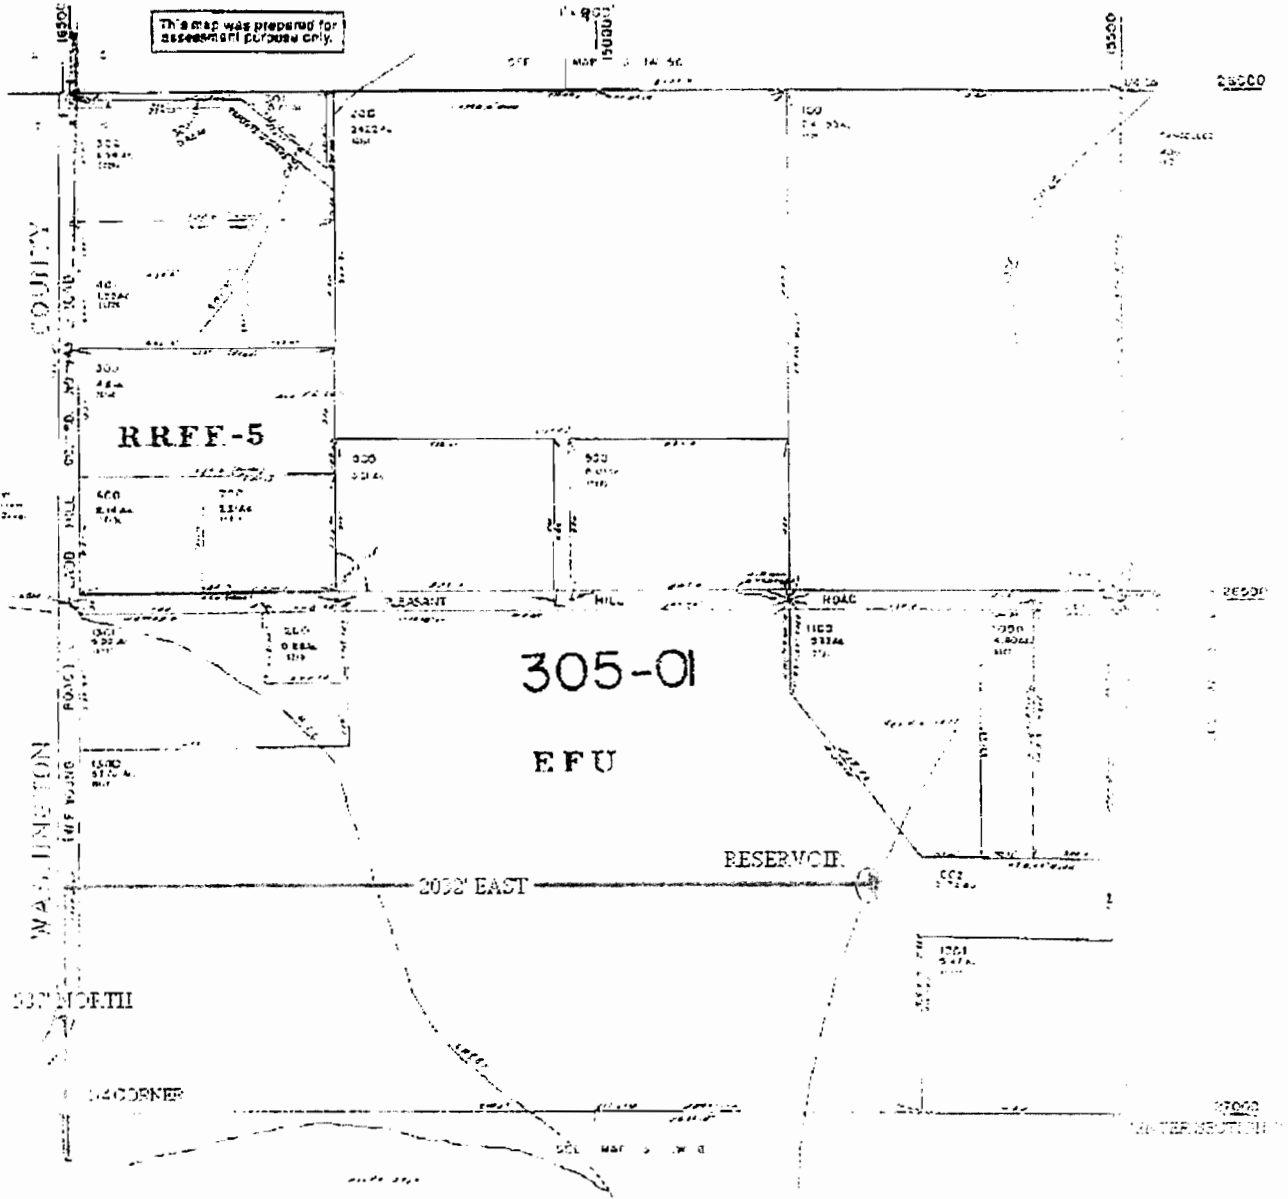

RECEIVED

AUG 12 2011

WATER RESOURCES DEPT
SALEM, OREGON

S-87743

WATER RESOURCES DEPT
SALEM, OREGON


S-87745

AUG 12 2011

RECEIVED



1" = 200'

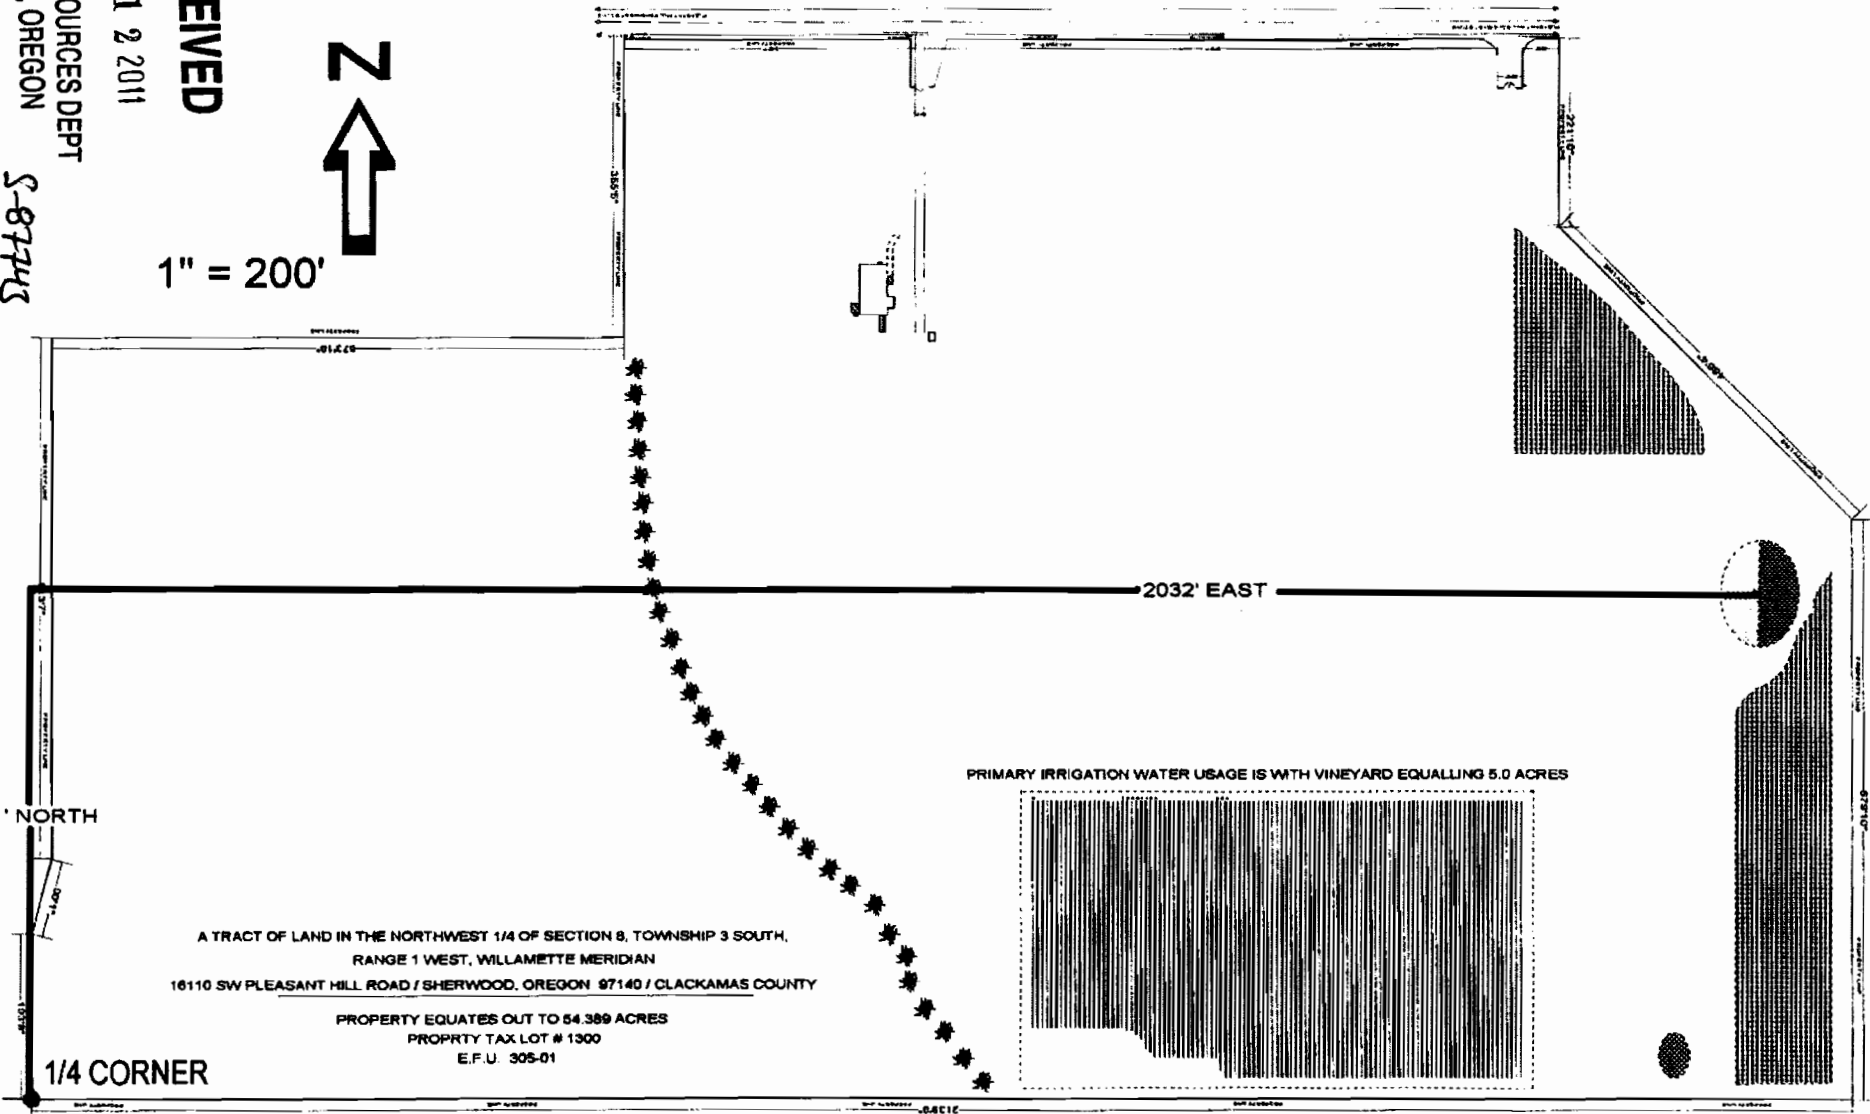

A TRACT OF LAND IN THE NORTHWEST 1/4 OF SECTION 8, TOWNSHIP 3 SOUTH,
RANGE 1 WEST, WILLAMETTE MERIDIAN
16110 SW PLEASANT HILL ROAD / SHERWOOD, OREGON 97140 / CLACKAMAS COUNTY

PROPERTY EQUATES OUT TO 54.389 ACRES
PROPERTY TAX LOT # 1300
E.F.U. 305-01

1/4 CORNER

PRIMARY IRRIGATION WATER USAGE IS WITH VINEYARD EQUALLING 5.0 ACRES