

113-2-3

2


Surveyed June 10 and 11, 1925.

1. Robert Irving
2. David A. Wisner
3. Geo M<sup>o</sup> Arthur
4. Mrs. Geo. Kidd
5. Alex. Murray
6. Sam Lofton
7. Kellog A Snow
8. E.C. Chinouth
9. O.R. Mascall
10. Clara Murray
11. P.A. Snyder
12. K. Murray
13. C.L. Jones
14. W.L. Greenwell
15. P. Trospen
16. P. Trospen
17. P. Trospen
18. June Ingersol
19. Hiram Munjar

20. Wm. Wyllie
21. John M<sup>o</sup> Gillvary
22. Geo. Snyder
23. M.E. Glover
24. W. Stone Jr.
25. Stewart L.S. Co.
26. Whitfield Stone
27. Stewart L.S. Co.
28. Ed. Lucas
29. J.E. Snow
30. J.E. Snow
31. J.E. Snow

12


Surveyed July 1, 1925

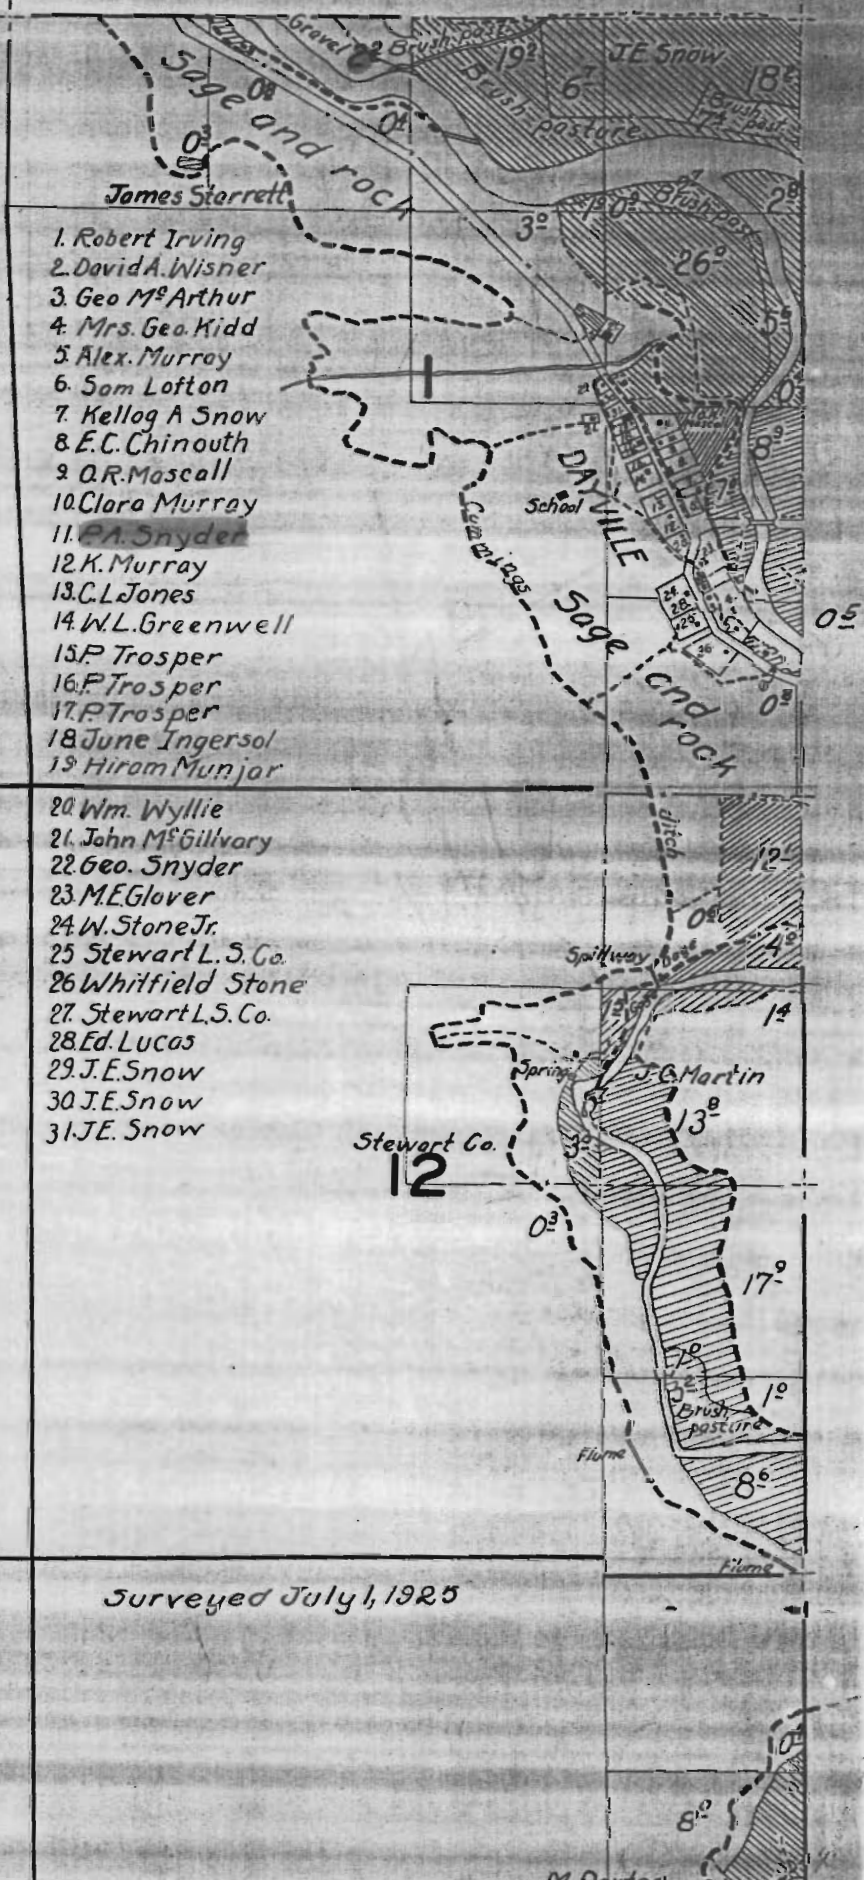

27


26

25

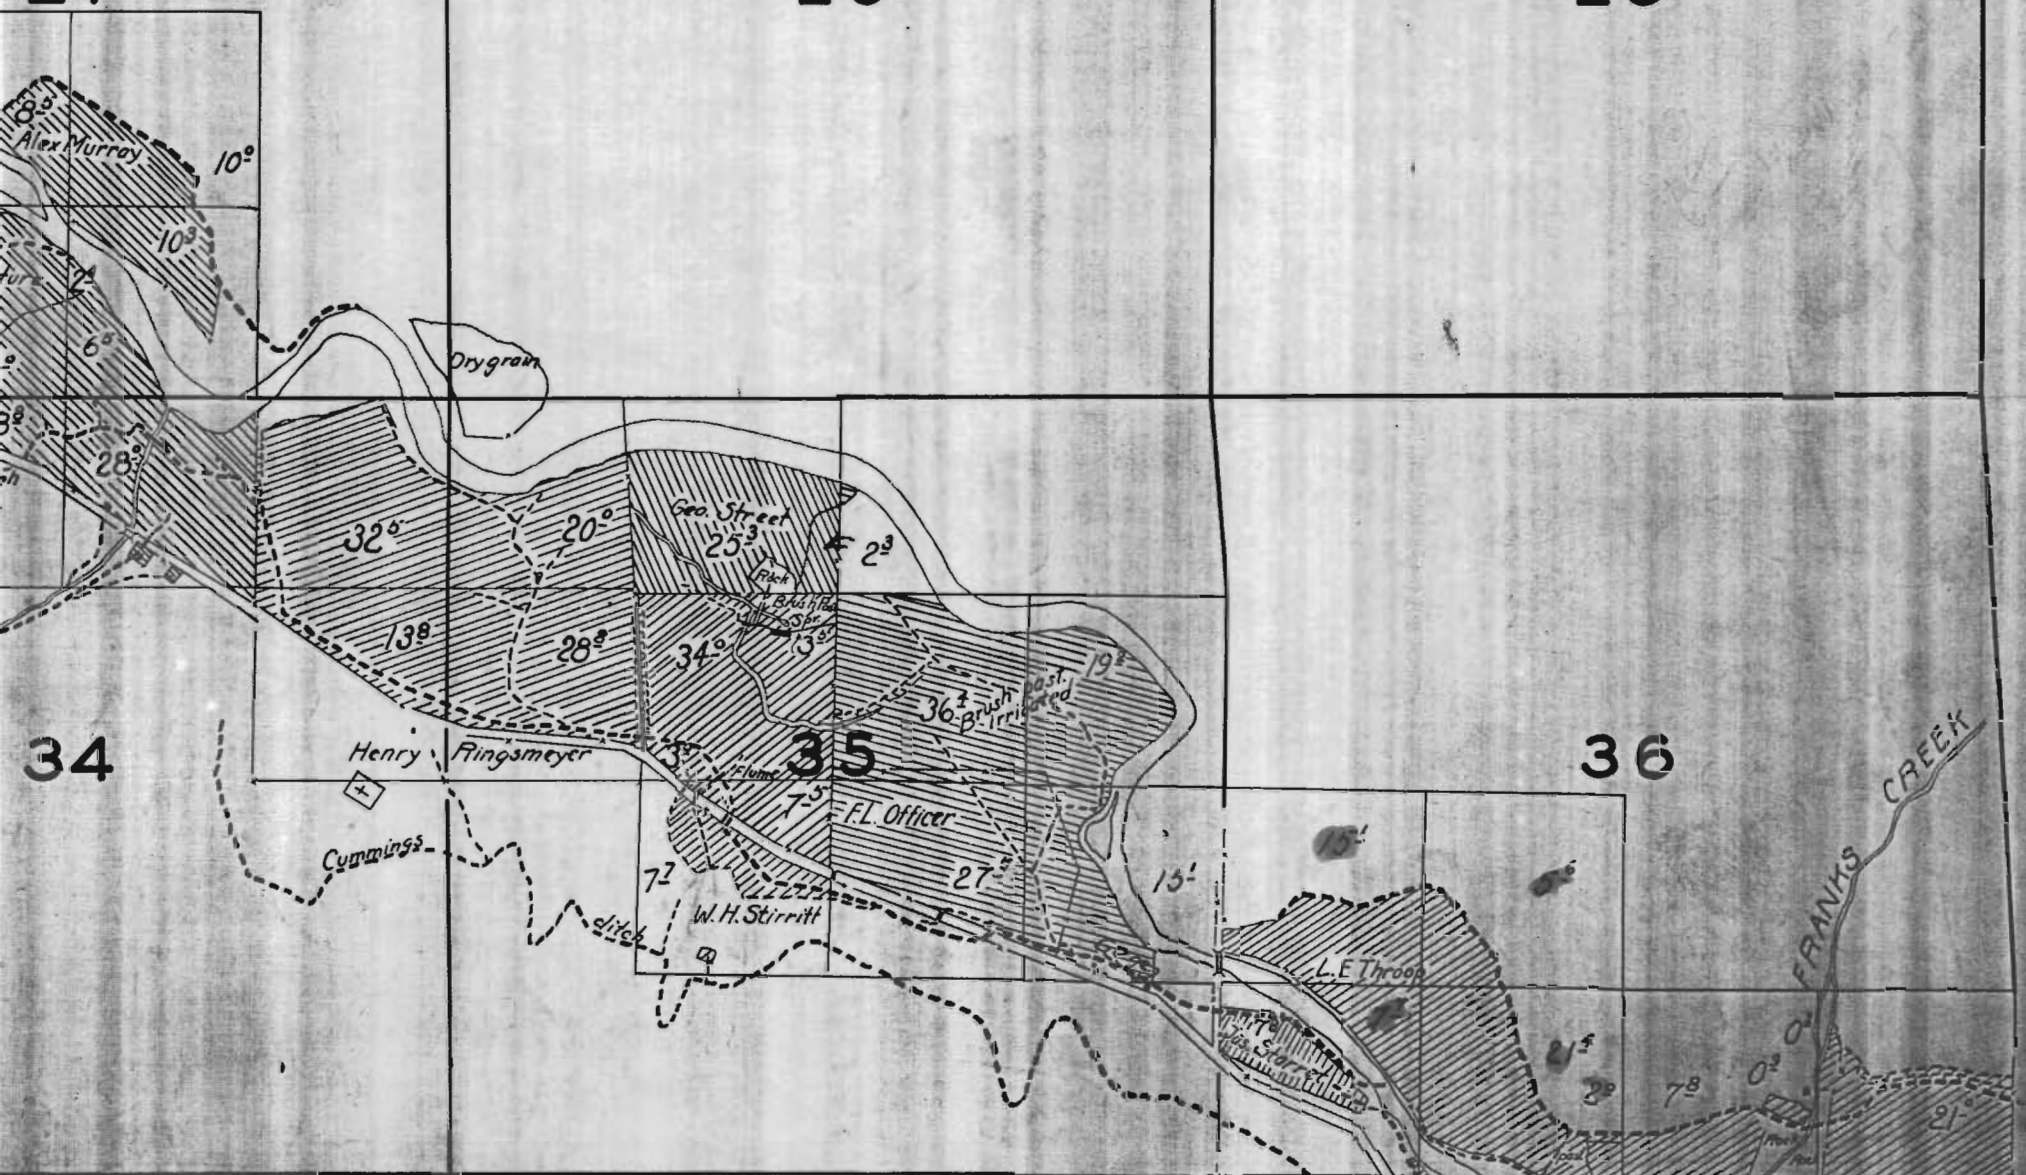

26

25

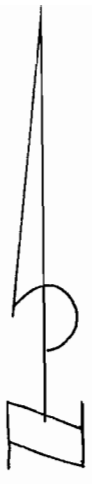

35

T-3274

36

T. 12 S. R. 26 E.

13 S. R. 26 E.

2

Alternate pt of Diversion By Pump

Existing pt. of Diversion

John Day River

Running Ditch

South Fork John Day

JOHN E. FISHER  
DAYVILLE, OREGON  
1974

Tr-3274

76  
DEPT  
SCN


T-8832

RECEIVED


JUN 07 2001

WATER RESOURCES DEPT.  
SALEM, OREGON


T12S R26E, W.M.

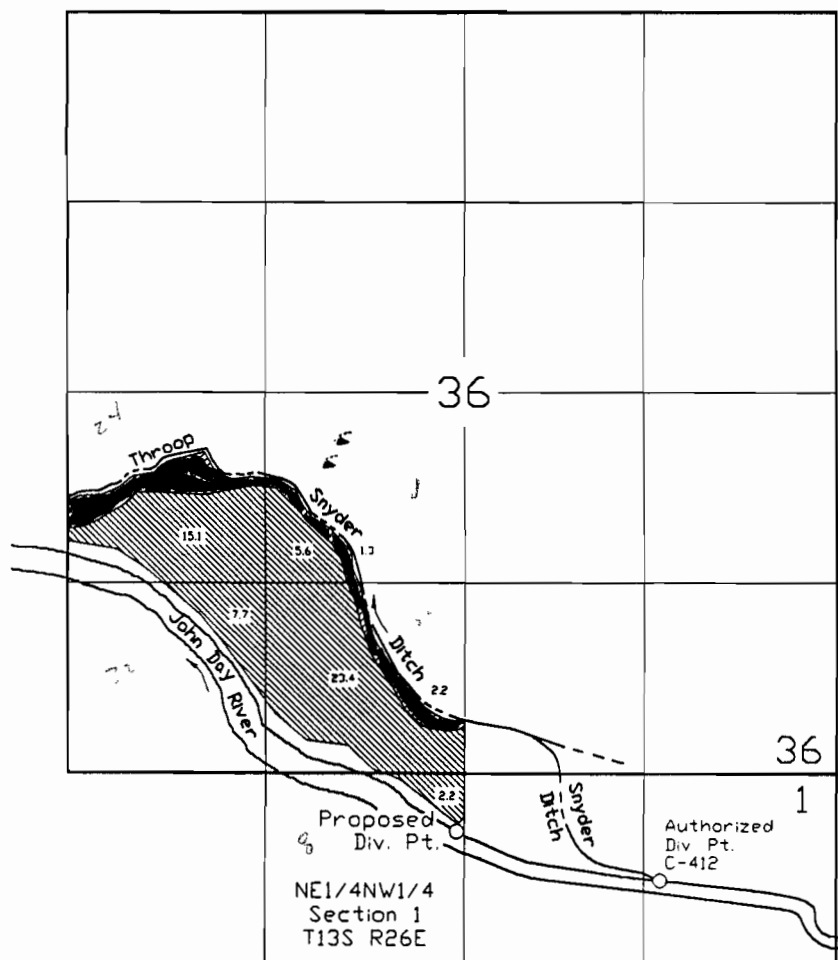

SCALE 1"=1320'

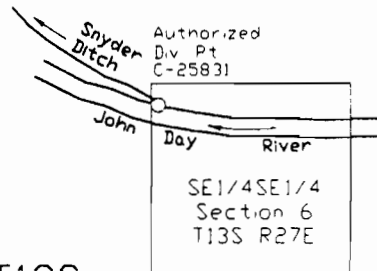

Proposed diversion point is 400 ft S. and 50 ft. W. of the S1/4 corner of Section 36.

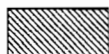 C-25831

 C-412

### APPLICATION MAP FOR CHANGE IN POINT OF DIVERSION

FOR


FERRIS CREEK RANCH

BY

CORNERSTONE SURVEYING, INC.  
P.O. BOX 33  
JOHN DAY, OR. 97845

C-412 includes other lands not shown.

NOTE: The preparation of this map was for the purpose of identifying the location of the proposed water right and has no intent to provide dimensions or location of property ownership lines.

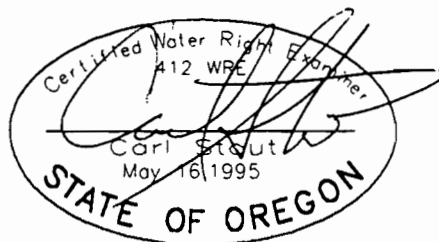



T-8832

**RECEIVED**


JUN 07 2001

WATER RESOURCES DEPT.  
SALEM, OREGON

T12S R26E, W.M.

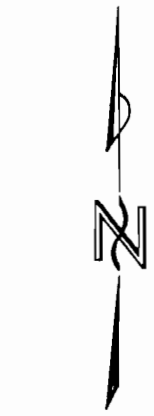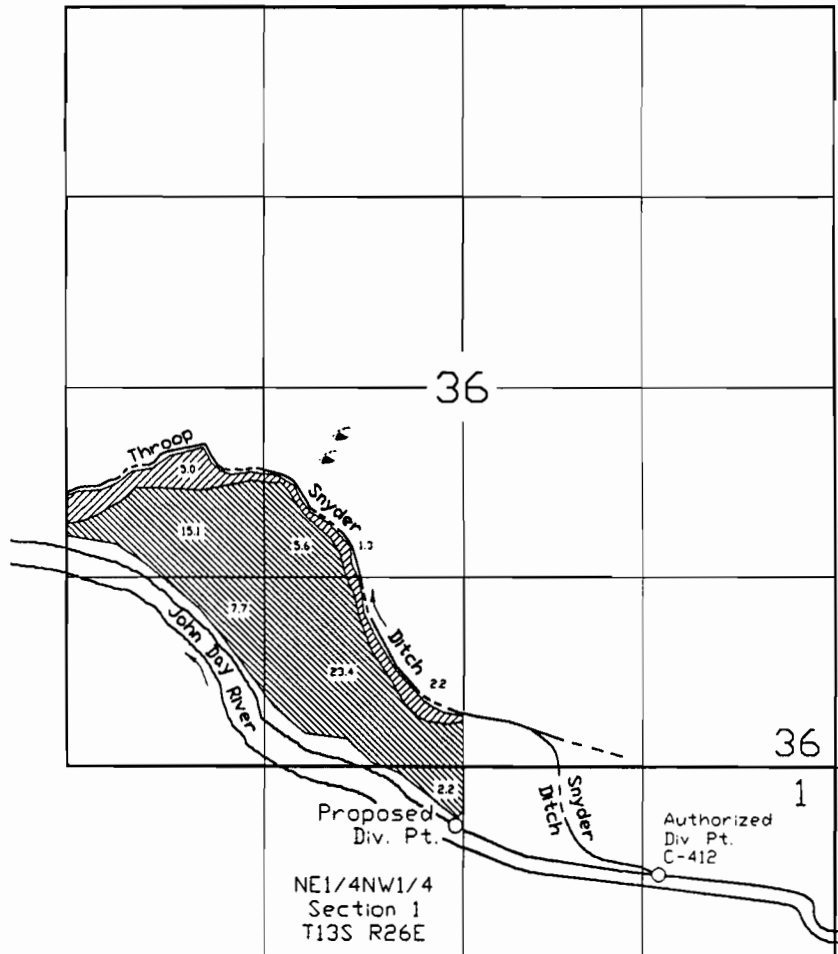

SCALE 1" = 1320'

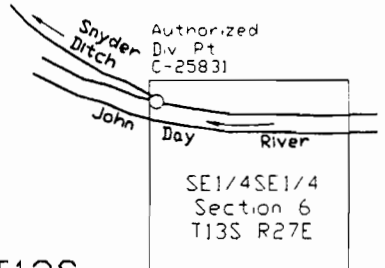

Proposed diversion point is 400 ft. S.  
and 50 ft. W. of the S1/4 corner  
of Section 36.



APPLICATION MAP FOR  
CHANGE IN POINT OF DIVERSION

FOR

FERRIS CREEK RANCH

BY

CORNERSTONE SURVEYING, INC.  
P.O. BOX 33  
JOHN DAY, OR. 97845

-  C-25831
-  C-412

C-412 includes other lands not shown.

NOTE: The preparation of this map  
was for the purpose of identifying  
the location of the proposed water  
right and has no intent to provide  
dimensions or location of property  
ownership lines.

