


T13S R26E

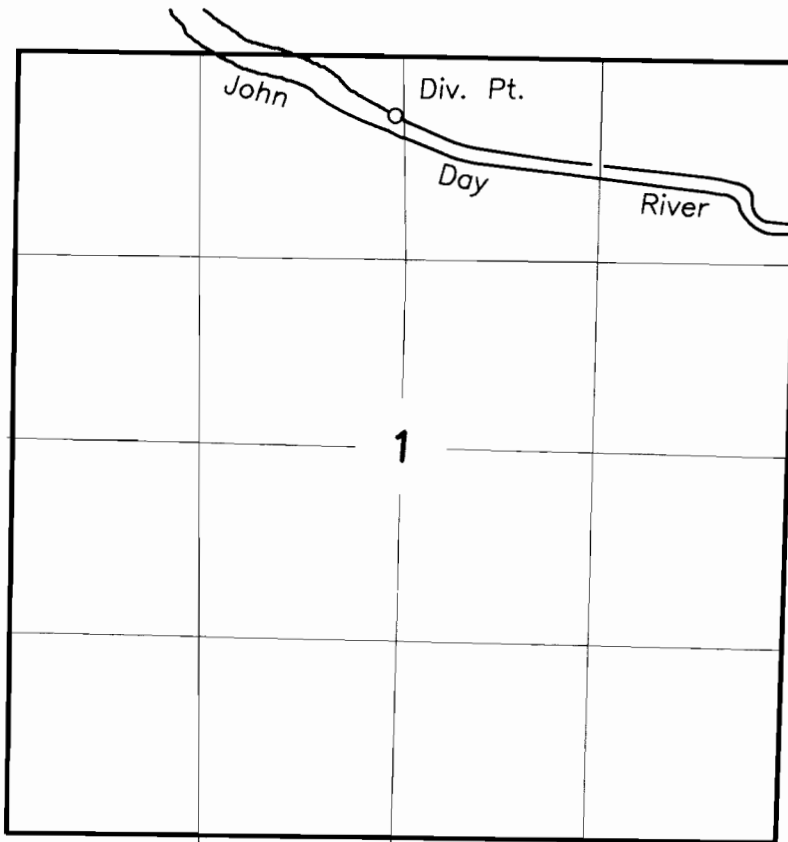

Scale 1"=1320'

Point of Diversion  
400 ft. South and 50 ft. West  
of the N1/4 corner of Sec. 1

## FINAL PROOF SURVEY

UNDER  
Transfer T-8832

IN NAME OF

Jerald and Barbara Clausen  
and  
Larry and Danielle Slaughter

Surveyed February 23, 2001

