


Application for Water Storage
In the Name of
Silver Butte Timber Company
Section 28, T32S, R4W, WM

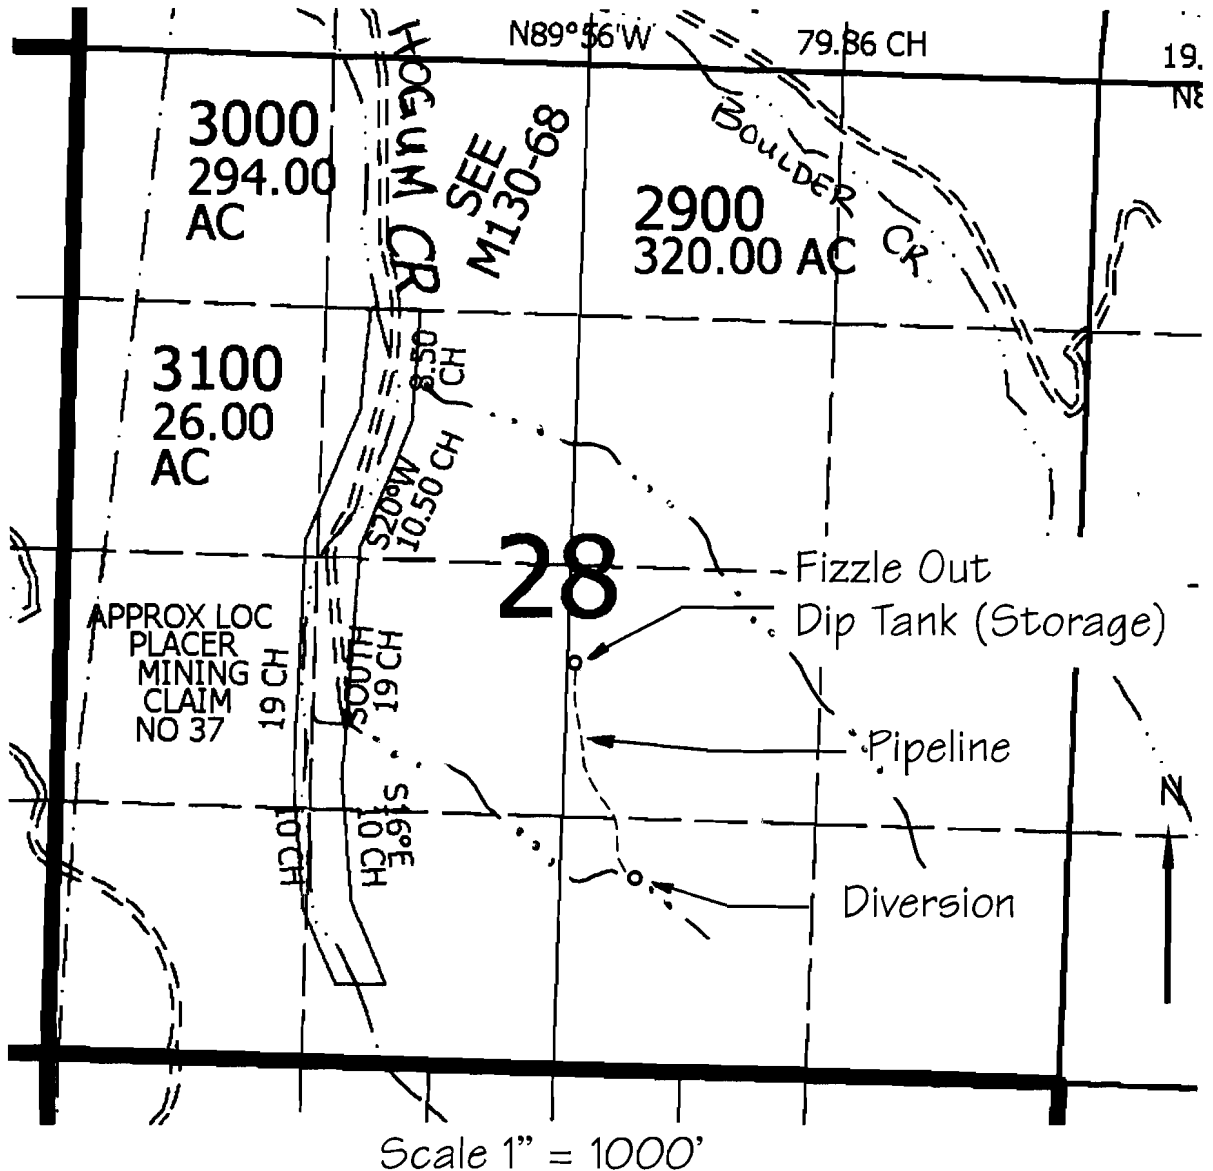

The point of diversion is located 925 feet north and 2245 feet west and the point of use is located 2110 feet north and 2595 feet west of the southeast corner of Section 28, Township 32 South, Range 4 West, WM.

The purpose of this map is to identify the location of the water right. It is not intended to provide information relative to the location of the property ownership boundary lines.

RECEIVED

AUG 22 2011

WATER RESOURCES DEPT
SALEM, OREGON

R-87746