

WORK COPY

WINCHUCK

RIVER

SEE MAP 41S 13W 23D

23 24

E. 1/4 SEC. 26 T. 41S. R. 13W. W.M. CURRY COUNTY

26 25


17-5

CS 41-1226

CORRECTED SC ACRE 300 FT.

U.S. HWY. 101


SEE MAP 41S 13W 26

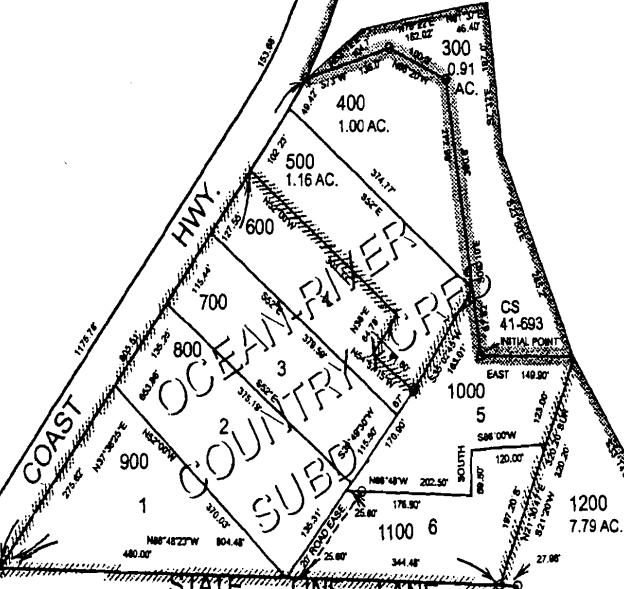

CS 41-693

1200 7.79 AC.

400 Feet

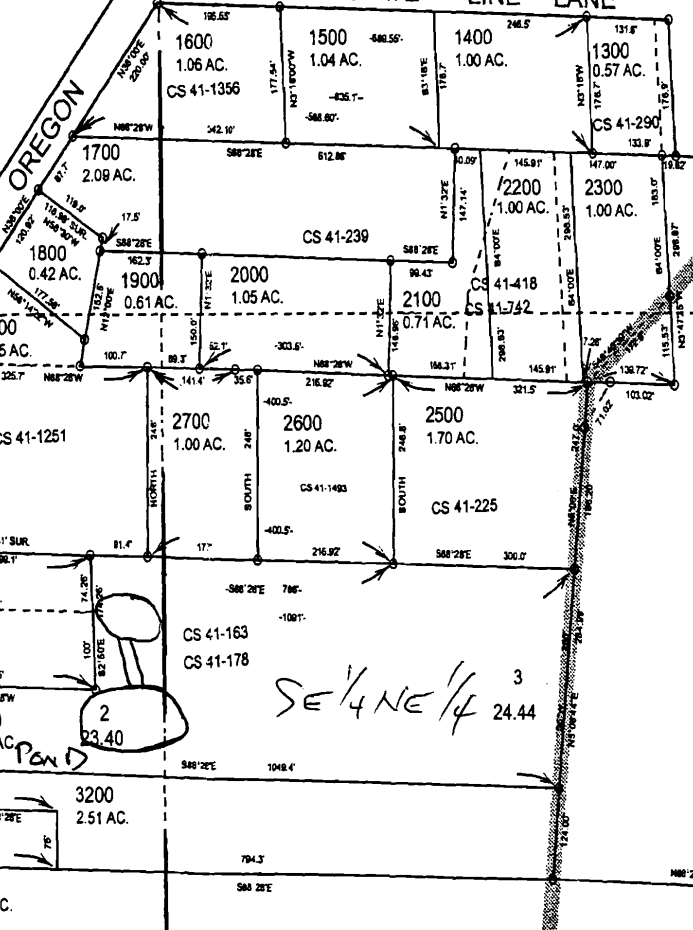

CS 41-1285

CS 41-1321

17-6

SE 1/4 NE 1/4 3 24.44

70 ft. from CORNER SECTION 26 30 ft. So 70 ft. W.

Sw 1/4 NE 1/4

2 23.40

26 25


2-87748

CALIFORNIA

CS 41-1226

N.E. 1/4 SEC. 26 T.41S. R.13W. W.M.  
CURRY COUNTY

SEE MAP 41S 13W 25

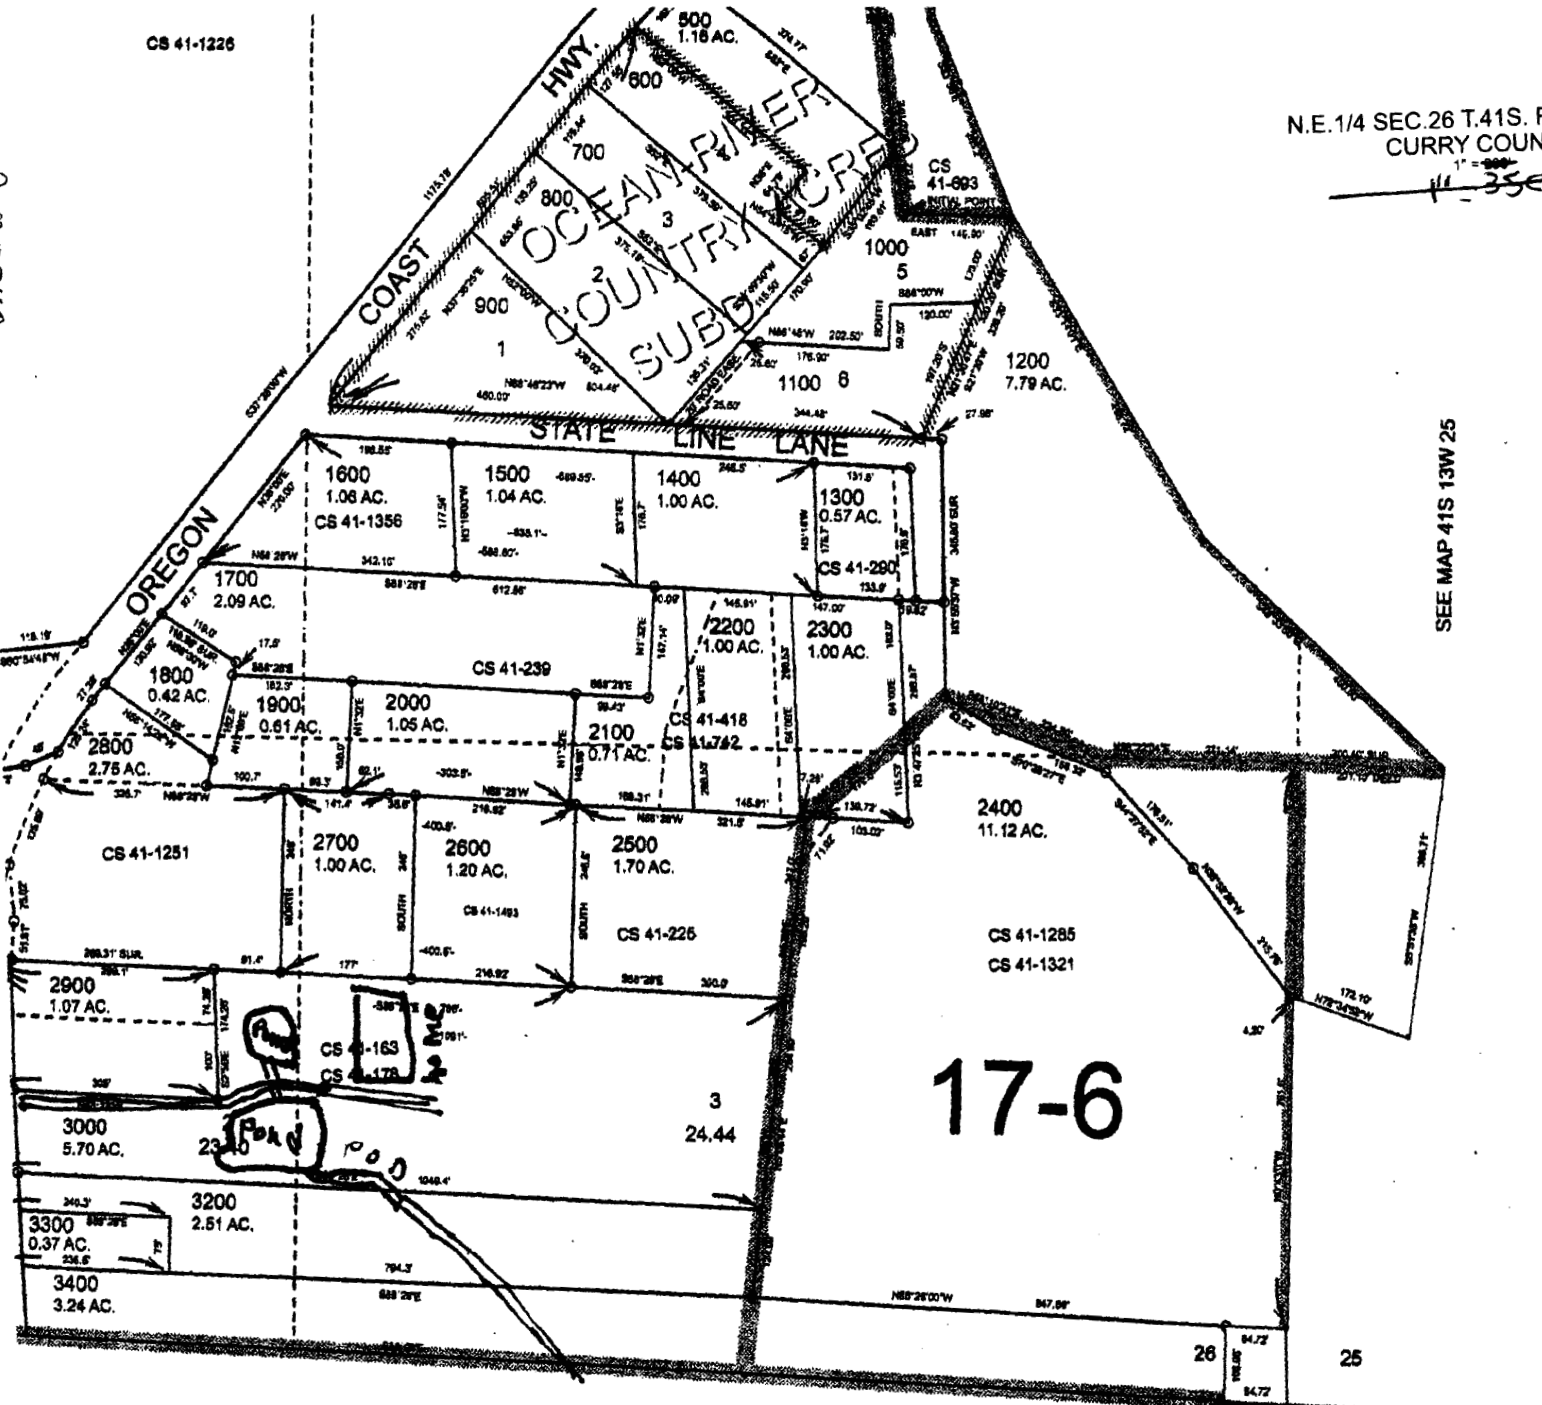


17-6

RECEIVED

WATER RESOURCES DEP.  
SALEM, OREGON  
Revised RAA

CALIFORNIA

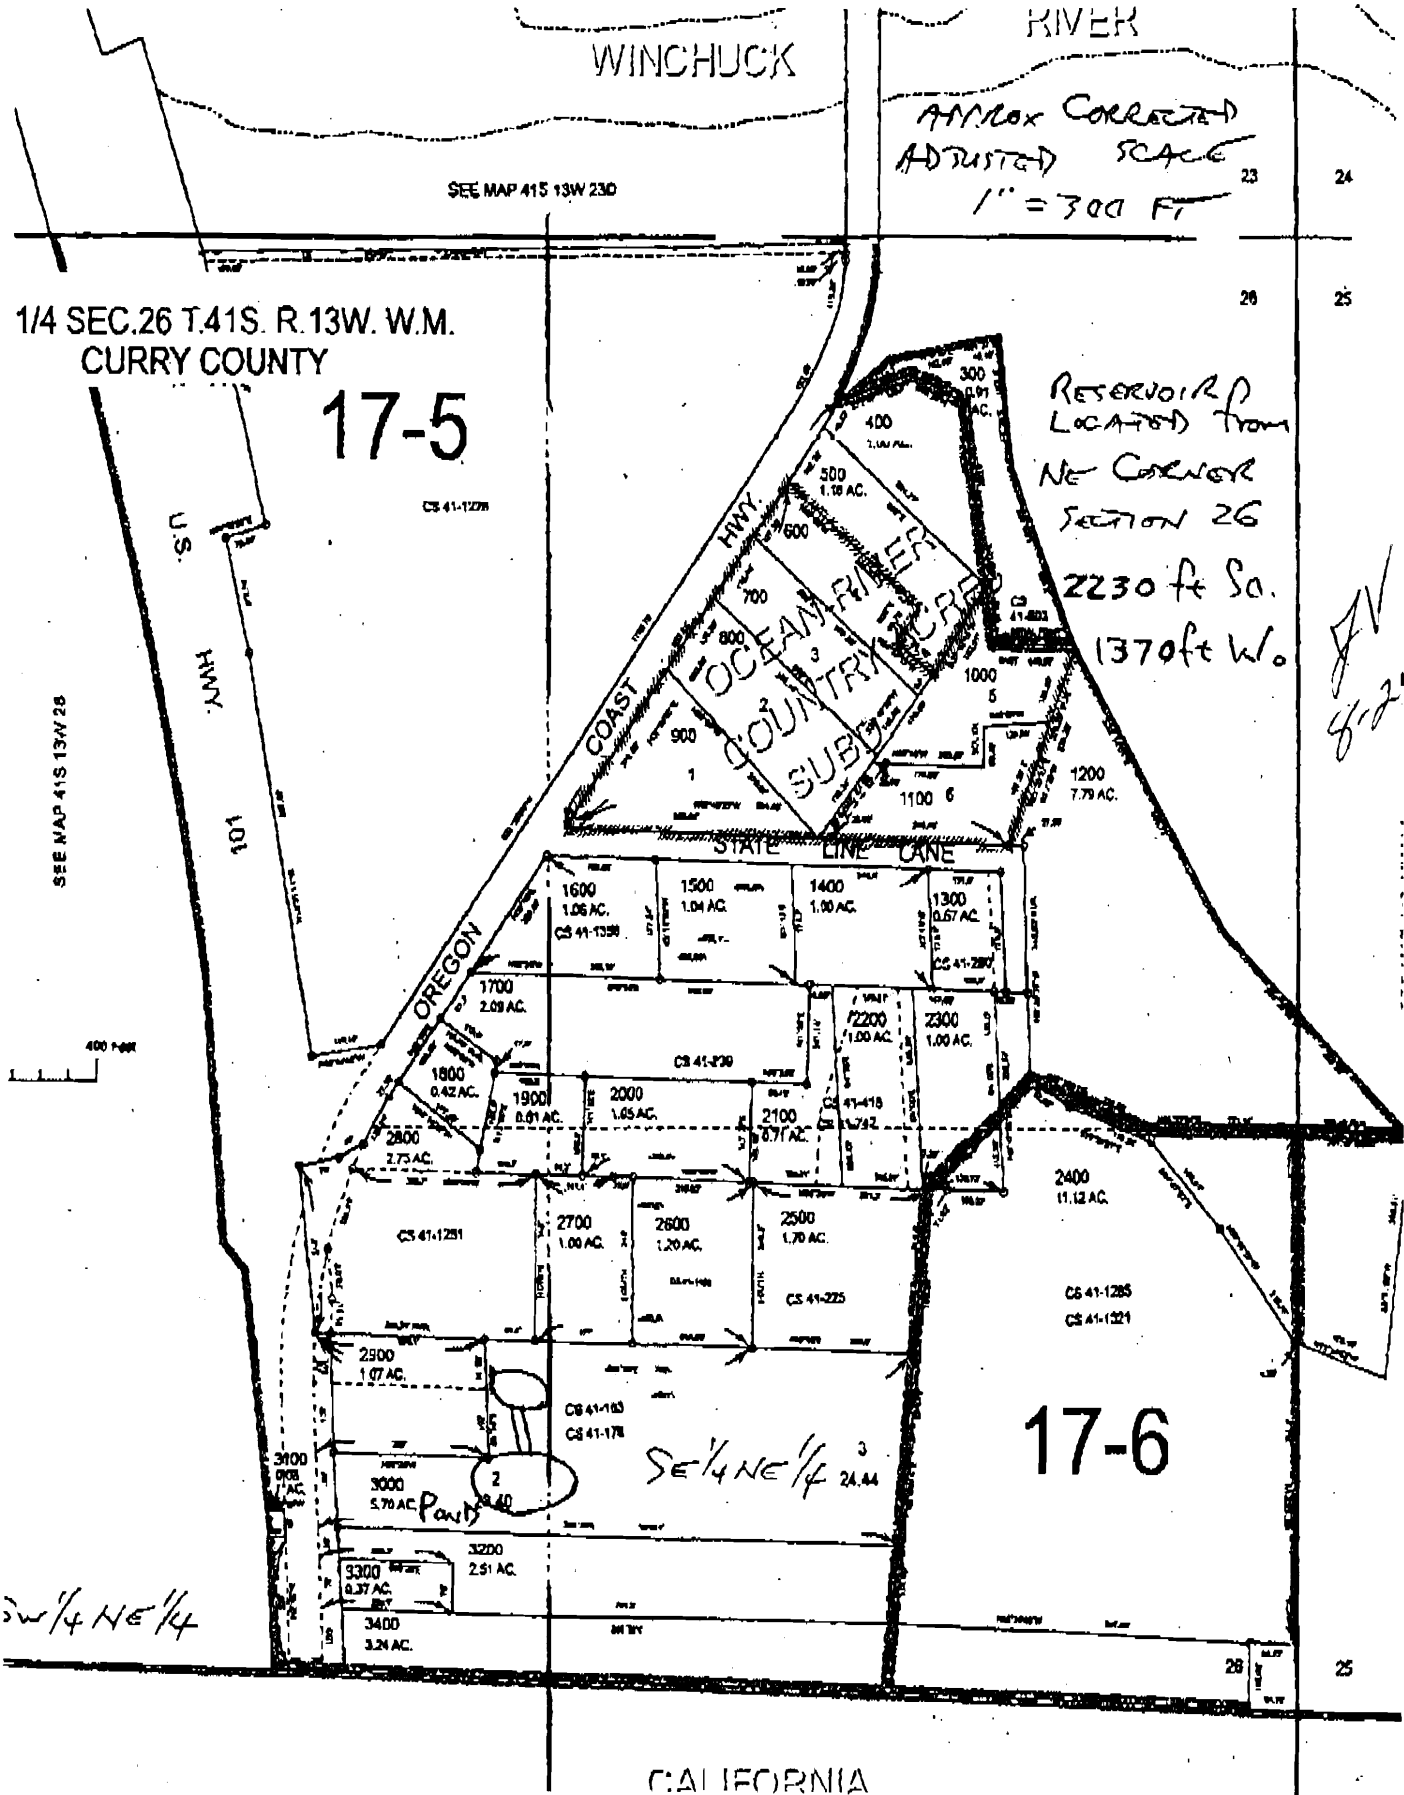

1/4 SEC.26 T.41S. R.13W. W.M.  
CURRY COUNTY

17-5

RESERVOIR  
LOCATED FROM  
NE CORNER  
SECTION 26  
2230 ft So.  
1370 ft W.

FN  
8-24-11

17-6

SE 1/4 NE 1/4 24.44

SW 1/4 NE 1/4

R-87748

WINCHUCK

RIVER

APPROX CORRECTED  
ADJUSTED SCALE  
1" = 300 FT

SEE MAP 41S 13W 23D

23

24

26

25

1/4 SEC. 26 T. 41S. R. 13W. W.M.  
CURRY COUNTY

17-5

CS 41-1226


RESERVOIR  
LOCATED FROM  
NE CORNER  
SECTION 26  
2230 ft So.  
1370 ft W.

U.S.  
H.WY.  
101

COAST  
OCEAN RIVER  
COUNTRY  
SUBDIVISION

STATE LINE LANE


SEE MAP 41S 13W 26

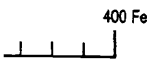

SW 1/4 NE 1/4

R-87748

CALIFORNIA

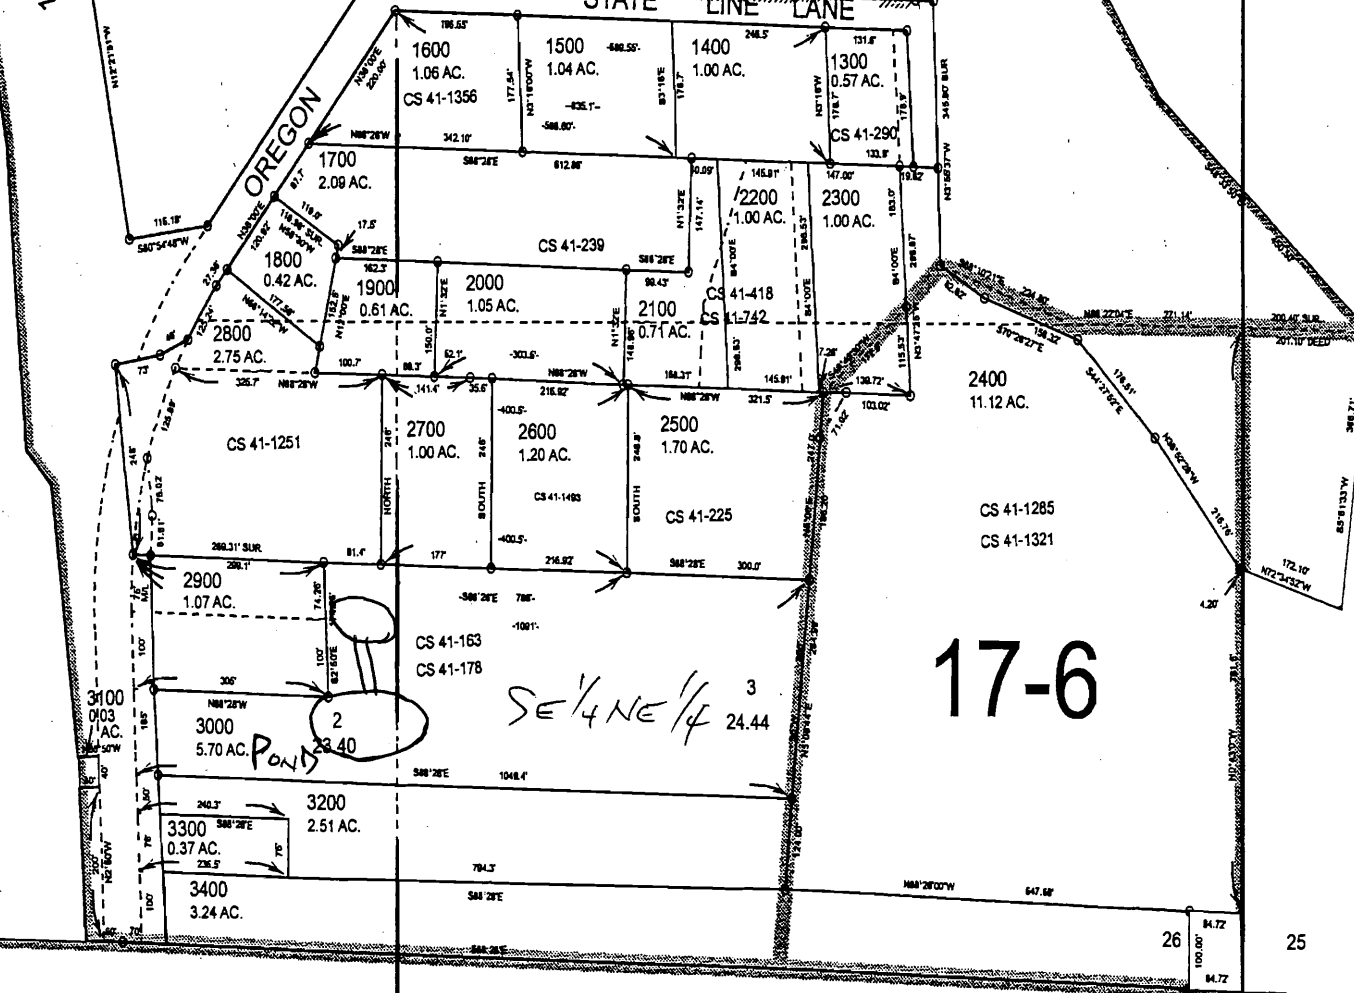

17-6

SE 1/4 NE 1/4 3  
24.44

26

25