

Did not fly as well #1
 Annual Volume
 std 2 1/2 / acre ft.
 2.5 / " / acre
 2.5 AF / acre -
 in annual acre ft.

7/8 8-19-2011

LEGEND

LINE TYPES

TAX LOT BOUNDARY OLD PROPERTY LINE
 ROAD RIGHT-OF-WAY VACATED RIGHT-OF-WAY
 RAILROAD RAILROAD RIGHT-OF-WAY
 STREAM, LAKE, ETC. STREAM, LAKE, ETC.
 TAX LOT BOUNDARY NON-BOUNDARY
 SUBDIVISION BOUNDARY PARTITION PLAT BND.
 TAX CODE BOUNDARY EASEMENT

SYMBOL TYPES

D.L.C.

CONTROL POINTS

SURVEY MONUMENTS

D.L.C. CORNERS

SECTION 1/4 SEC 1/8 SEC 1/16 SEC

NUMBERS

TAX CODE NO.
 000 00 00 0

ACREAGE - ALL ACREAGES EXCLUDE ANY PORTION THAT MAY LIE WITHIN THE INDICATED PUBLIC RIGHT OF WAY.

TICK MARKS - WHEN A TICK MARK IS INDICATED ON THE EXTENSION OF A LINE, THEN THE DIMENSION GOES TO THE TICK MARK. GENERALLY THIS IS USED WHEN DIMENSIONS GO INTO PUBLIC RIGHT OF WAY.


ARROWS ARE USED WITH DIMENSIONS IN AREAS OF GREATER COMPLEXITY.

NOTICE: This map was created for Assessor's Office use ONLY.



RECEIVED
 AUG 19 2011
 WATER RESOURCES DEPT
 TOWNSHIP ENGINEER

ADJUSTED ANTIKEX
 REVISED SCALE
 1" = 400 FEET

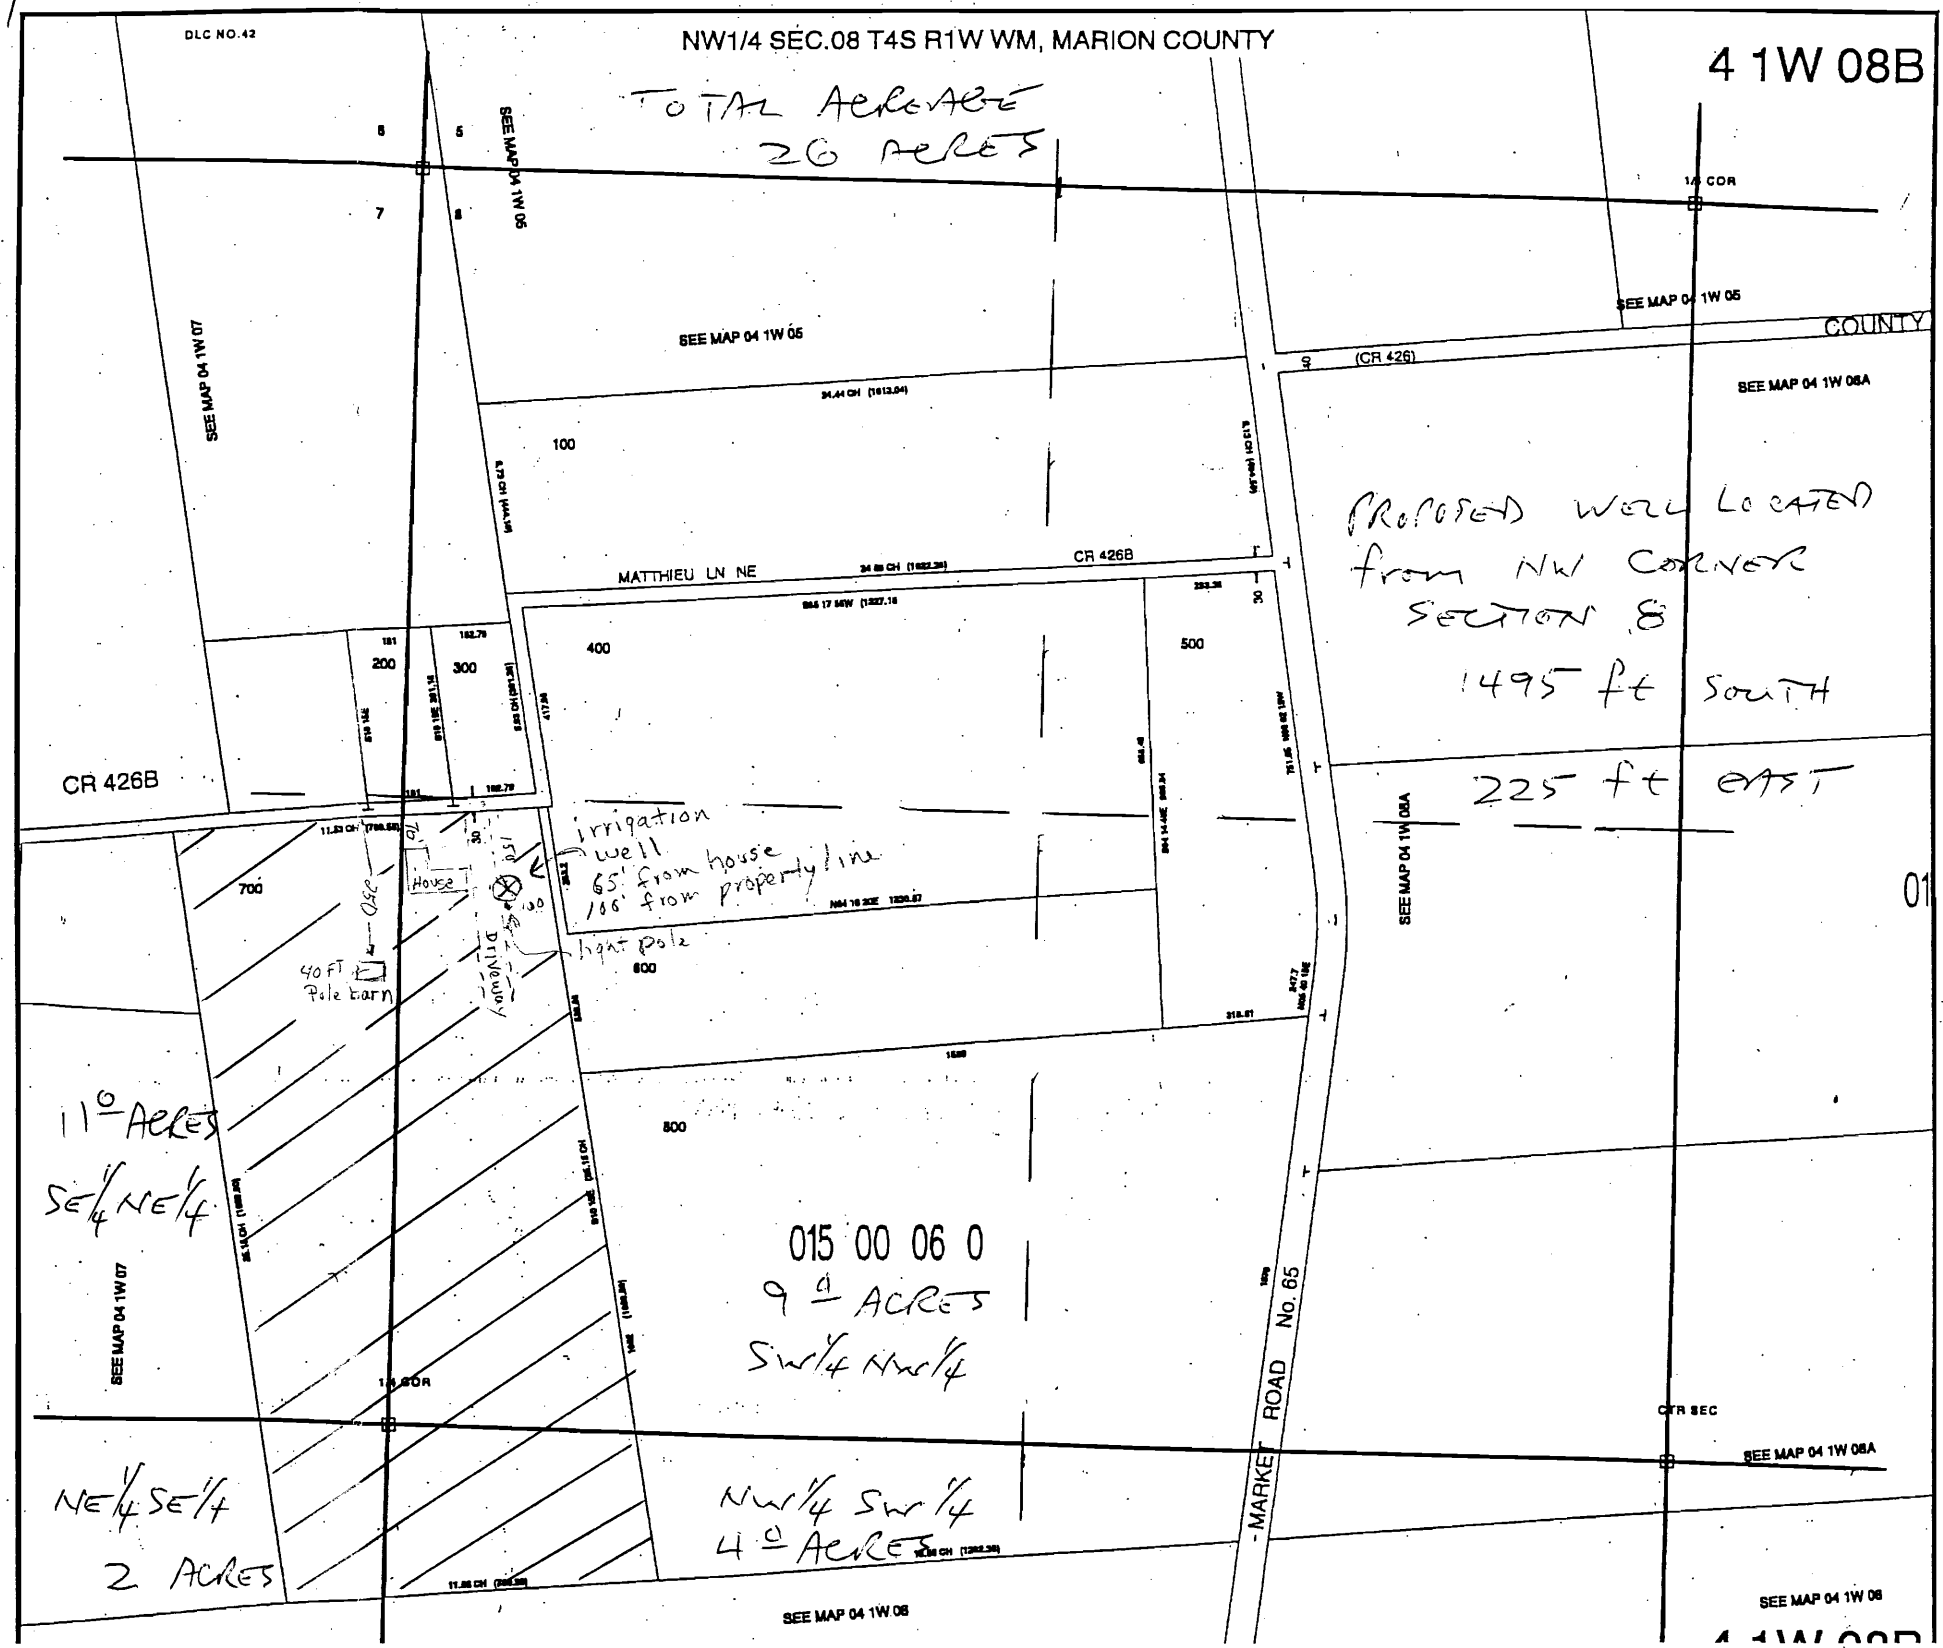

House 70' from Matthieu Ln
 " 165' " East property line
 Driveway 135' from East property line
 Well 65' from house
 Well 150' from Matthieu Ln.
 Well 100 feet from East property line

Identify as well #1
 Annual Volume
 2 1/2 / acre ft.
 2.5 / " " / acre
 2.5 AF / acre
 in annual acre ft.

LEGEND

LINE TYPES

TAX LOT BOUNDARY	OLD PROPERTY LINE
ROAD RIGHT-OF-WAY	VACATED RIGHT-OF-WAY
RAILROAD	RAILROAD RIGHT-OF-WAY
STREAM, LAKE, ETC.	STREAM, LAKE, ETC.
TAX LOT BOUNDARY	NON-BOUNDARY
SUBDIVISION BOUNDARY	PARTITION PLAT BND.
TAX CODE BOUNDARY	EASEMENT

SYMBOL TYPES

D.L.C.

CONTROL POINTS

SURVEY MONUMENTS

Q.L.D. CORNERS

SECTION 1/4 SEC 1/8 SEC

NUMBERS

TAX CODE NO.
 000 00 00 0


ACREAGE - ALL ACREAGES EXCLUDE ANY PORTION THAT MAY LIE WITHIN THE INDICATED PUBLIC RIGHT OF WAY.

TICK MARKS - WHEN A TICK MARK IS INDICATED ON THE EXTENSION OF A LINE, THEN THE DIMENSION GOES TO THE TICK MARK. GENERALLY THIS IS USED WHEN DIMENSIONS GO INTO PUBLIC RIGHT OF WAYS.

ARROWS ARE USED WITH DIMENSIONS IN AREAS OF GREATER COMPLEXITY.

NOTICE: This map was created for Assessor's Office use ONLY.

Assessor "We Care" GIS Geographic Information System

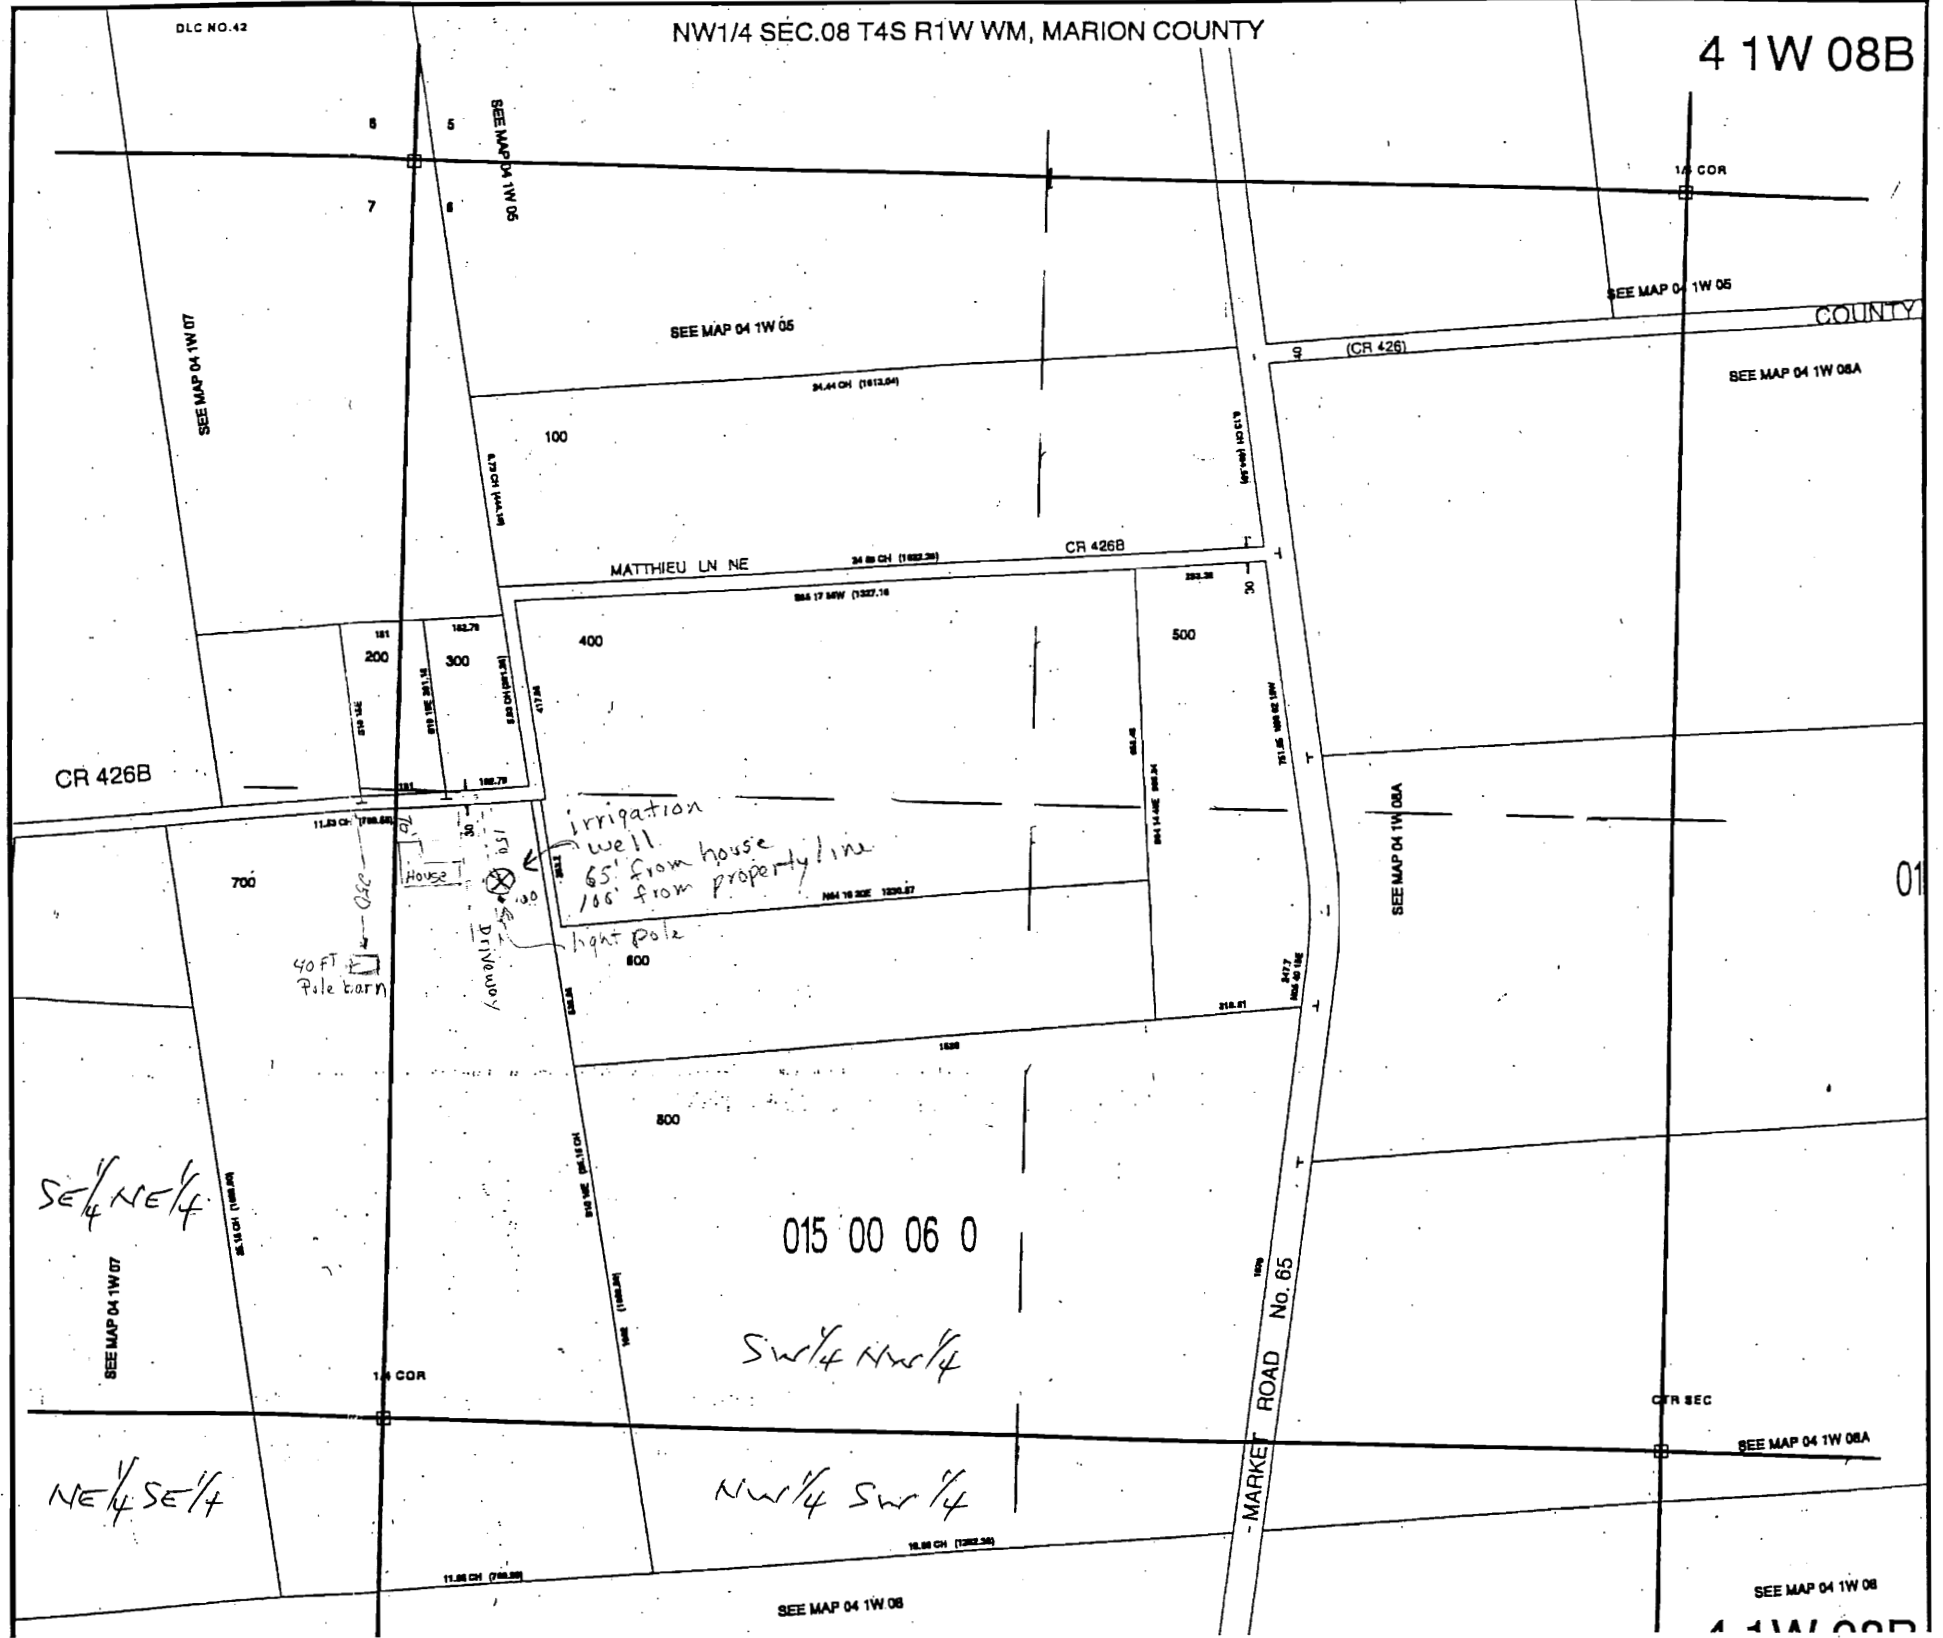

ADJUSTED APPROX
 REVISID SCALE
 1" = 400 FEET

House 70' from Matthieu Ln
 " 165' " East property line
 Driveway 135' from East property line
 Well 65' from house
 well 150' from Matthieu Ln.
 well 100 feet from East property line

AUG 19 2011

Gr-7482