


T.5N. R26E.W.M.

SPRINKLER APPLICATION
of
Charles E. & June S. Early

4-16-69



Scale:
1" = 10 chains

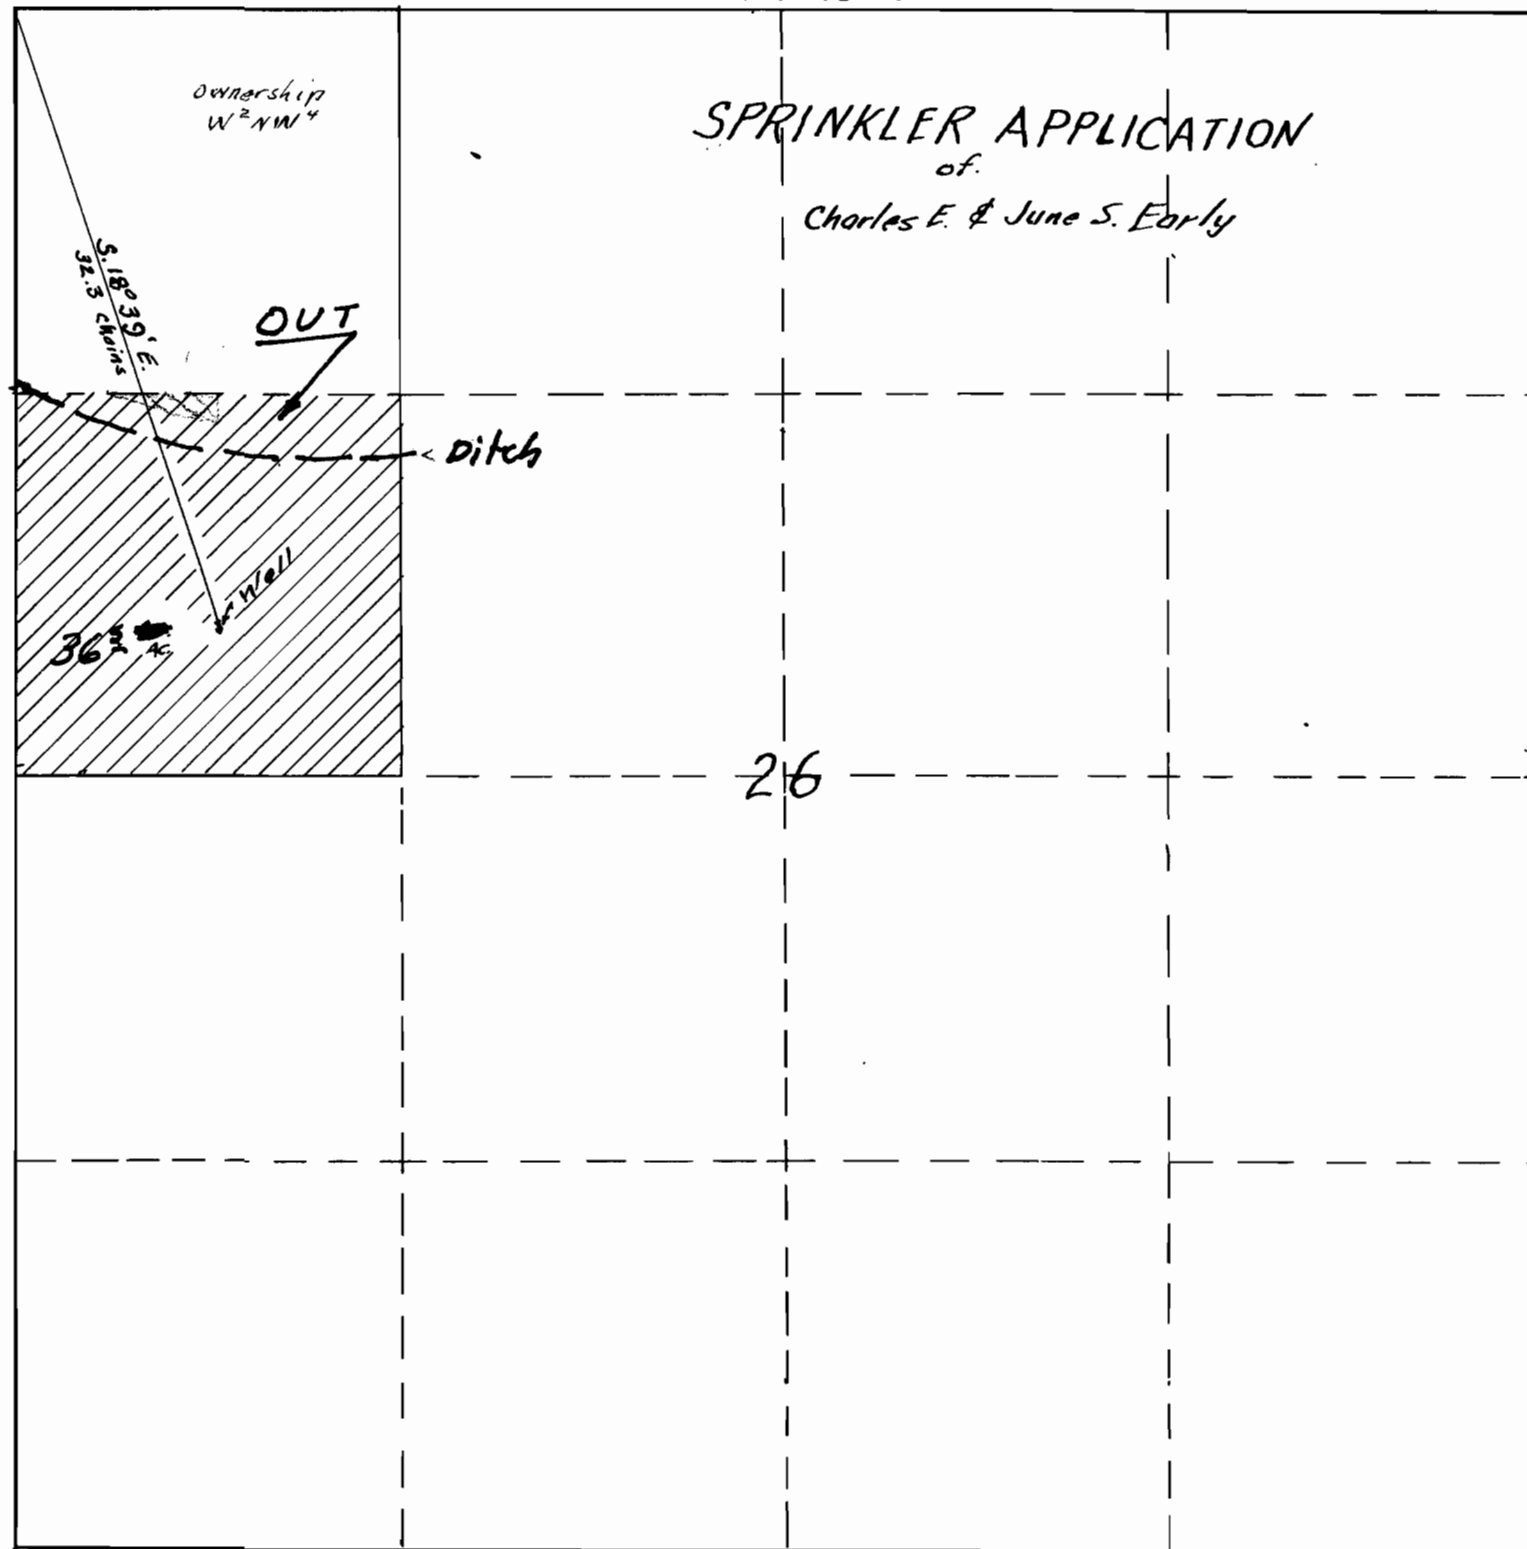

I, J.C. Payne, certify
that this map
was made from notes
of a field survey on
June 4, 1955.



RECEIVED
APR 16 1969
STATE ENGINEER
SALEM, OREGON

Application No. G-4795
Permit No. G 4520

Application No. ~~H-839~~
Permit No. ~~H-732~~