
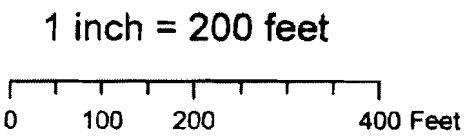


# Reservoir Location 38S-4W-8-SW-SW Taxlot: 705

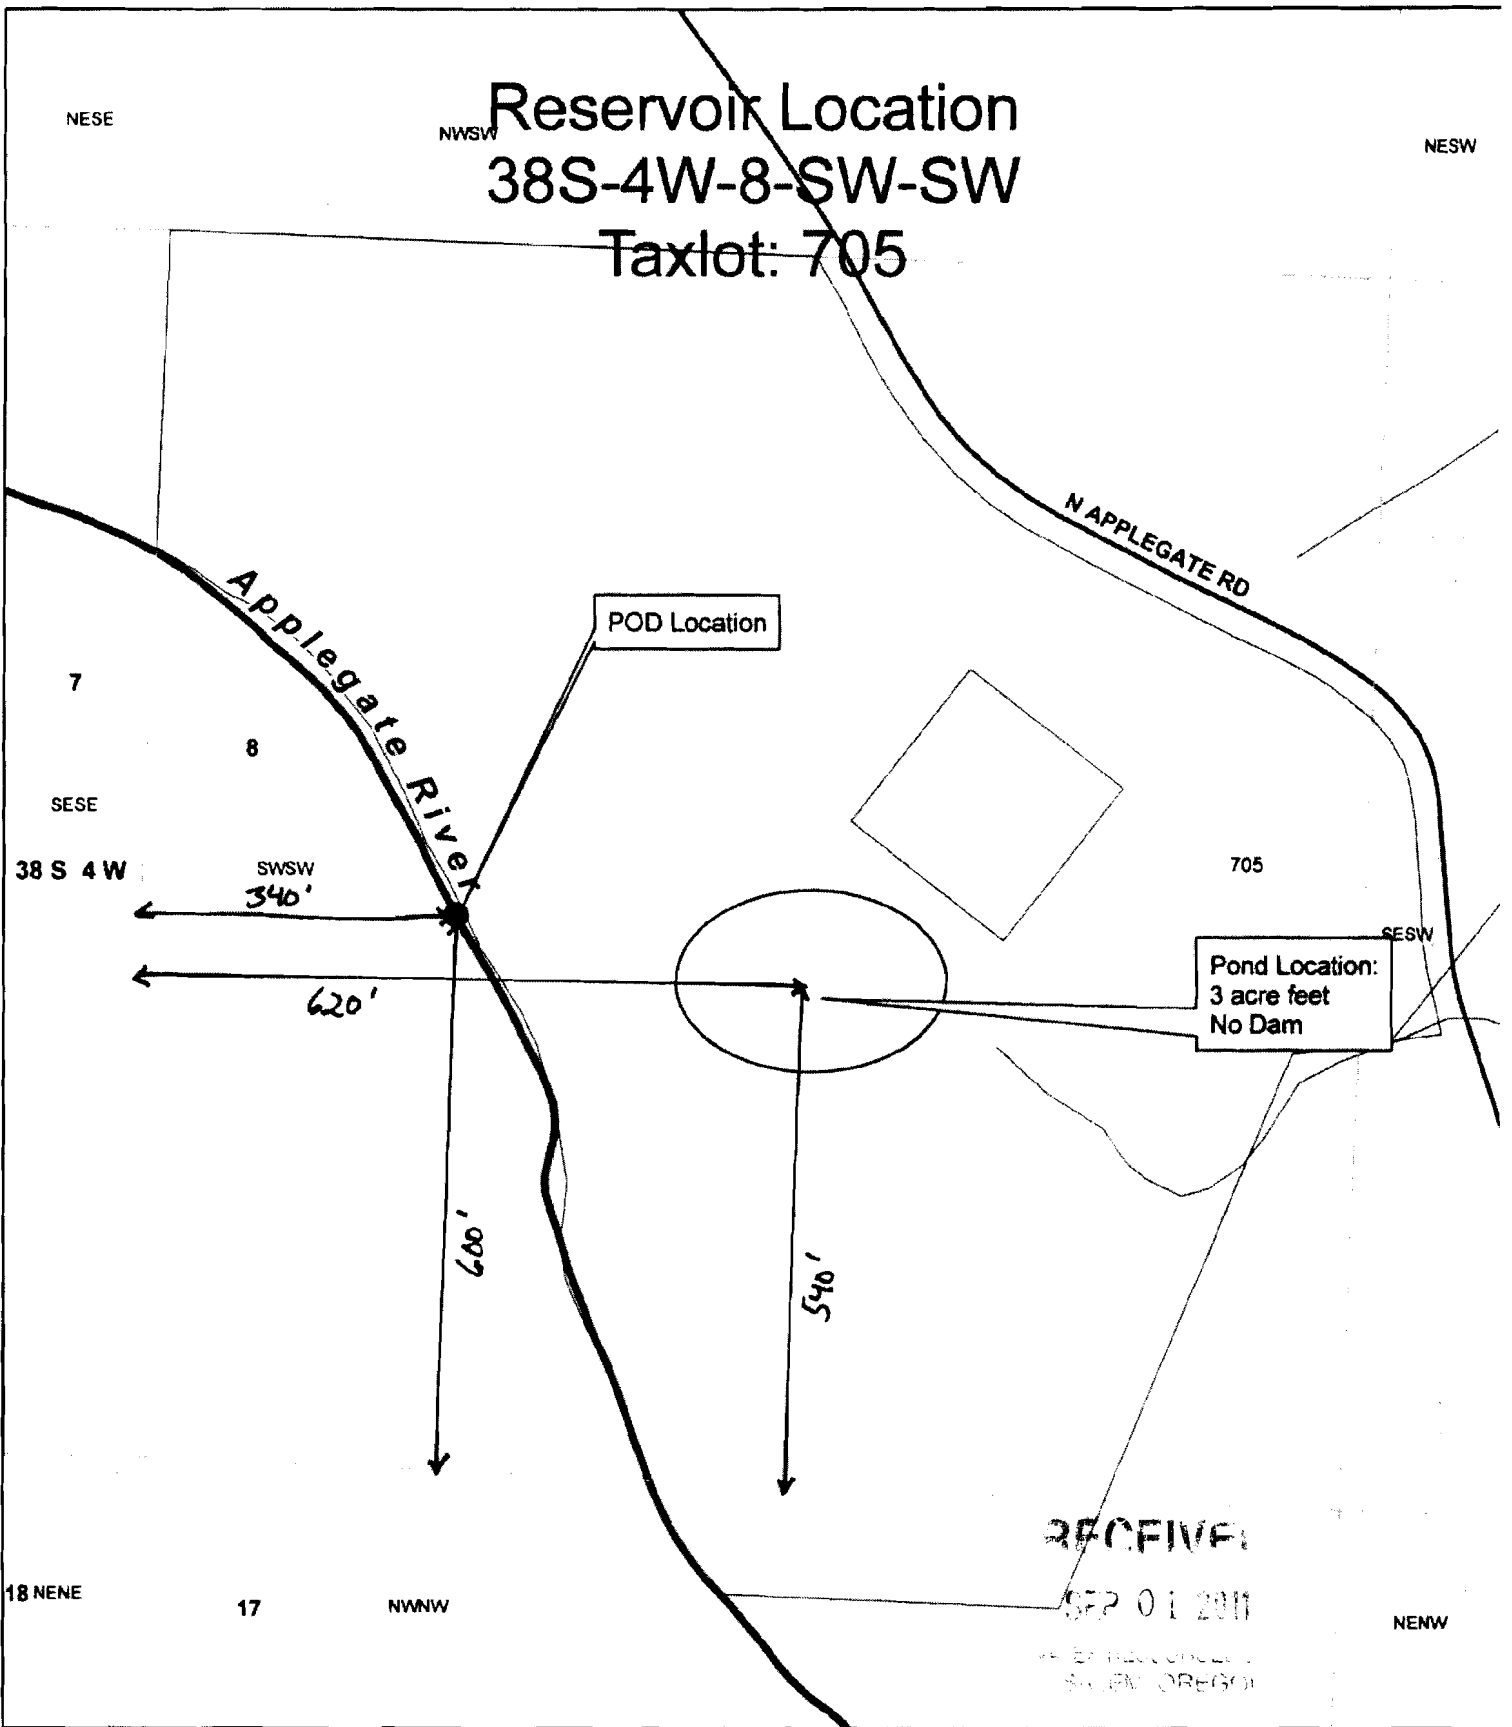


## Legend

- Tax Lot
- Townships
- Pond
- POD
- Sections
- Quarter quarters

Reservoir Location  
38S-4W-8-SW-SW  
Taxlot: 705

*Superseded  
by 9/1/11 map*

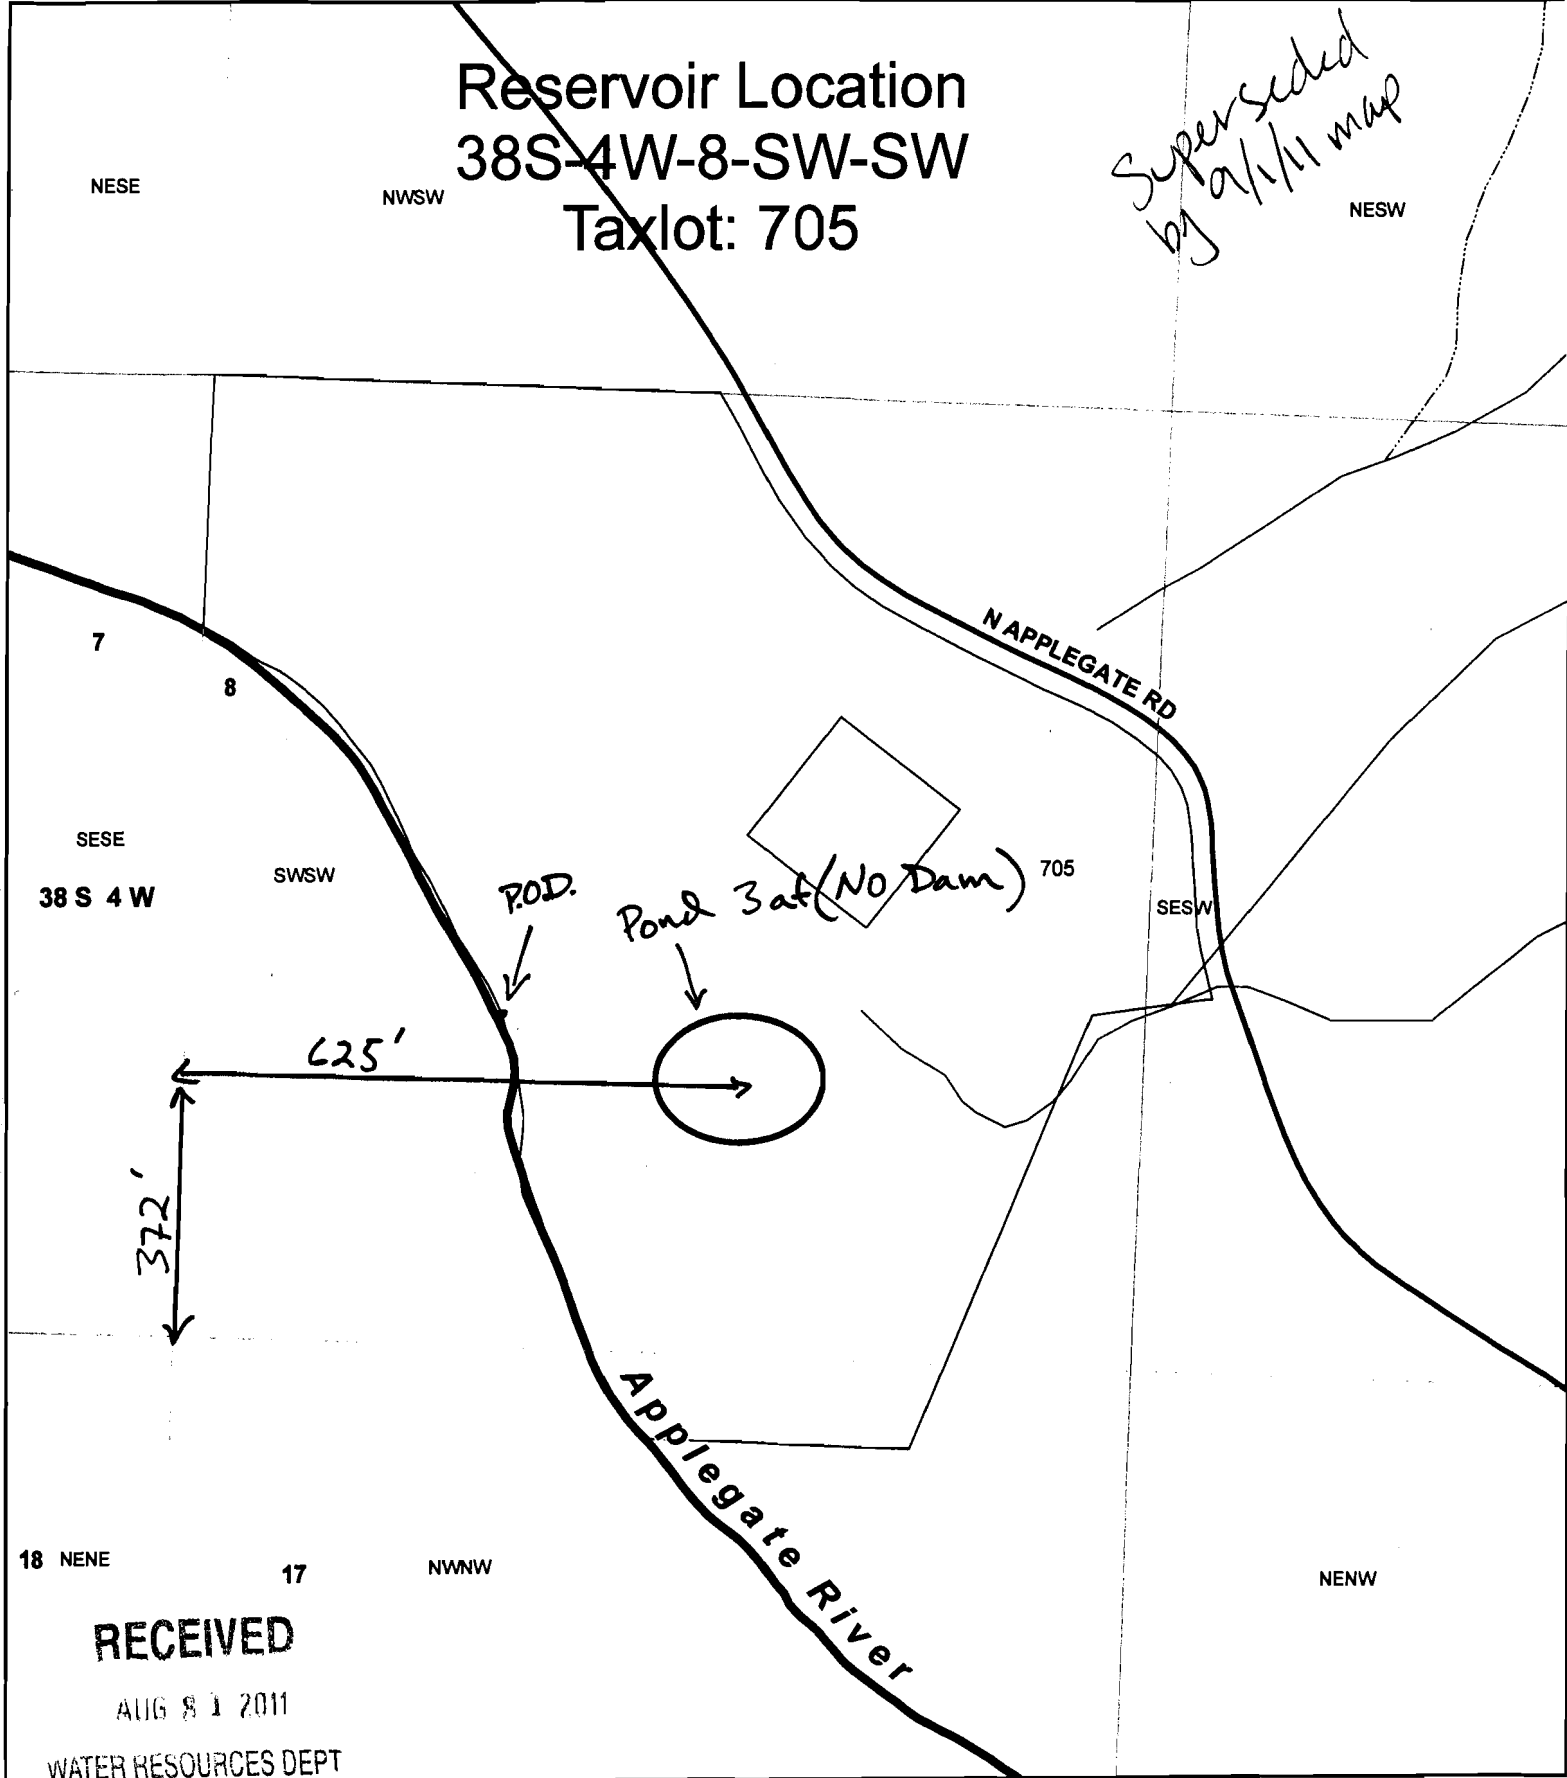

18 NENE 17 NWNW


NENW

RECEIVED

AUG 8 1 2011

WATER RESOURCES DEPT  
SALEM, OREGON

1 inch = 266 feet

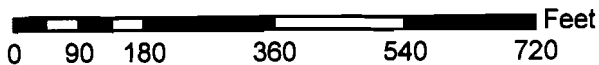

Legend

- Tax Lot
- Sections
- Townships
- Quarter quarters
- Pond Location

**OWRD Basic Web Mapping Application (beta)**

	<p>Locate a place on the map ▶ Use Advanced Map ▶ Help ▶ Links ▶</p> <p>  Zoom In             Zoom Out             Pan             Full Extent             Identify       </p>	<p><b>Selected Point</b></p> <p>Perform a peak discharge estimate at this point          This point is located in the following TRSQQ:</p>
<p> </p> <p><input type="checkbox"/> OWRD Data</p> <ul style="list-style-type: none"> <li><input checked="" type="checkbox"/> Rule Boundaries</li> <li><input checked="" type="checkbox"/> Political Boundaries</li> <li><input checked="" type="checkbox"/> Water Availability</li> <li><input checked="" type="checkbox"/> Water Rights</li> <li><input checked="" type="checkbox"/> Surface water</li> </ul> <p><input checked="" type="checkbox"/> Base Data</p> <ul style="list-style-type: none"> <li><input checked="" type="checkbox"/> Political Boundaries</li> <li><input checked="" type="checkbox"/> PLS</li> <li><input checked="" type="checkbox"/> Roads</li> <li><input checked="" type="checkbox"/> Surface water</li> <li><input checked="" type="checkbox"/> Topography</li> </ul> <p><input checked="" type="checkbox"/> Imagery</p> <ul style="list-style-type: none"> <li><input type="checkbox"/> Aerial Photography</li> <li><input checked="" type="checkbox"/> USGSquads</li> </ul>		<p><b>TRSQQ: 38.005-04.00W-08-SWSW</b></p> <p>County: Jackson          Basin: Rogue          WM District: 13          WM Region: SW          Withdrawn Area:          WAB: <u>APPLEGATE R &gt; ROGUE R - AT MOUT</u>          Priority WAB: <u>APPLEGATE R @ mouth (249)</u>          Rule 4D:          Groundwater Restricted:          Scenic Water Way: <u>ABOVE The Rogue Scenic Waterway</u>          Division 33: STATEWIDE          Water Quality Limited: Yes          Water Rights: <u>See Water Rights in this section (Pla</u>          Well Logs: <u>See Well Logs in this section</u></p>

**RECEIVED**

AUG 31 2011

WATER RESOURCES DEPT  
SALEM, OREGON