


REQUEST FOR ASSIGNMENT &
ACCEPTANCE OF HYDROELECTRIC PROJECT
TERMS & CONDITIONS

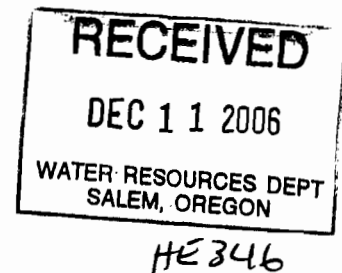

Oregon Water Resources Department
725 Summer Street, NE, Suite A
Salem, Oregon 97301-1271

I/We, Earland Dixie Lathrop

707 SE Hillcrest Rd (address)

John Day, OR. 97845 (city, state, zip)

have attached proof of ownership of the land and/or facilities involved in Hydroelectric License HE 346 issued in the name of Joseph Schmidt. I/We, hereby request assignment of Hydroelectric License HE 346 to my/our name(s).

(Attach copy of deed to land or land sales contract, and tax lot map of diversion site and powerhouse, and \$25 recording fee.)

I/We, Earland Dixie Lathrop, in consideration of the assignment to me/us of rights and privileges evidenced by the license covering Major Hydroelectric Project No. HE 346, do hereby promise and agree I/we will exercise such rights and privileges in conformity to the laws of the State of Oregon, conditions imposed in said license, and the rules and regulations of the Water Resources Commission made pursuant thereto.

I/We hereby certify that I am/we are citizen(s) of the United States of America.

Dated on this 6th day of Dec, 2006.

Earland Lathrop
Dixie Lathrop

Subscribed and sworn to before me this 6th day of Dec, 2006.



Tami A. Kowing
Notary Public for the State of Oregon

My Commission Expires: 11/20/07

Mrs. James Hayes P.O. Box 989 Mt. Vernon Oregon 97865
MR. Joseph Schr tz P.O. Box 326 Mt. Vernon Oregon 97865

R-8291

long.
19° 03' 35"

↑
N


Exhibit A

(P R 13061)

long.
119° 03' 30"

sec 24

R 30 E T 14 S

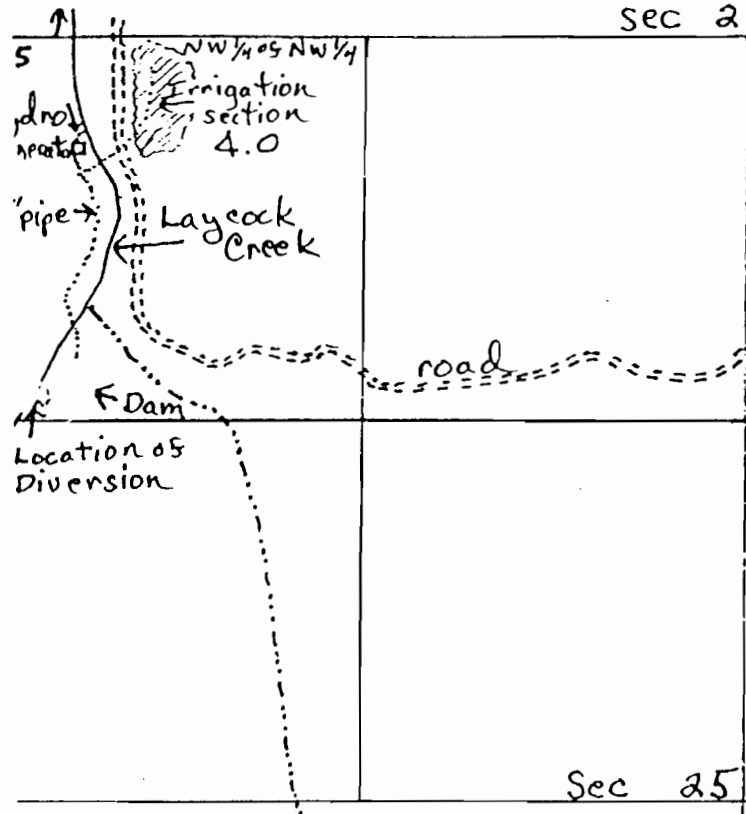

Application No.

R-61935 &
61936

Permit No.

R 8291
45912

The reservoir is in the
NW 1/4 NW 1/4 Sec 25, T. 14
R. 30 E, W.M. Tax Lot 3014

Sec 25

lat. 44° 20' 10"

point of Diversion
1400 ft S - 160 ft E NW Corner
Sec 25

place of Dam
1200 ft S - 200 ft E NW Corner
Sec 25

point of water re-entry
to Laycock Creek
600 ft S - 400 ft E NW
corner Sec 25

RECEIVED
DEC 11 2006
WATER RESOURCES DEPT
SALEM, OREGON

RECEIVED

OCT 18 2000

WATER RESOURCES DEPT.
SALEM, OREGON

Sec 36

RECEIVED

DEC 21 2000

WATER RESOURCES DEPT.
SALEM, OREGON

8" To 1 mile

25