

LEGEND

LINE TYPES

TAX LOT BOUNDARY	OLD PROPERTY LINE
ROAD RIGHT-OF-WAY	VACATED RIGHT-OF-WAY
RAILROAD	RAILROAD RIGHT-OF-WAY
STREAM, LAKE, ETC.	STREAM, LAKE, ETC.
TAX LOT BOUNDARY	NEW BOUNDARY
SUBDIVISION BOUNDARY	PARTITION PLAT BND.
TAX CODE BOUNDARY	EASEMENT

SYMBOL TYPES

D.L.C.	①	
CONTROL POINTS	▲	
SURVEY MONUMENTS	•	
G.L.S. CORNERS	+	
SECTION	1/4 SEC.	1/16 SEC.
	 1/4 COR.	 1/16 COR.

NUMBERS

TAX CODE NO.
000 00 00 0

ACREAGE - ALL ACREAGES EXCLUDE
ANY PORTION THAT MAY LIE
WITHIN THE INDICATED PUBLIC
RIGHT OF WAYS.

TICK MARKS - WHEN A TICK MARK IS
INDICATED ON THE EXTENSION OF
A LINE, THEN THE DIMENSION GOES
TO THE TICK MARK. GENERALLY THIS
IS USED WHEN DIMENSIONS GO INTO
PUBLIC RIGHT OF WAYS.

ARROWS ARE USED WITH DIMENSIONS
IN AREAS OF GREATER COMPLEXITY.

NOTICE: This map was
created for Assessor's
Office use ONLY.




SCALE 1" = 200'
or 1:2400

Plot file created: June 14, 2010
AerialImage092407c.tif geotiff

SW1/4 SEC.07 T9S R2W WM, MARION COUNTY

9 2W 07C

Cancelled
1900
2100

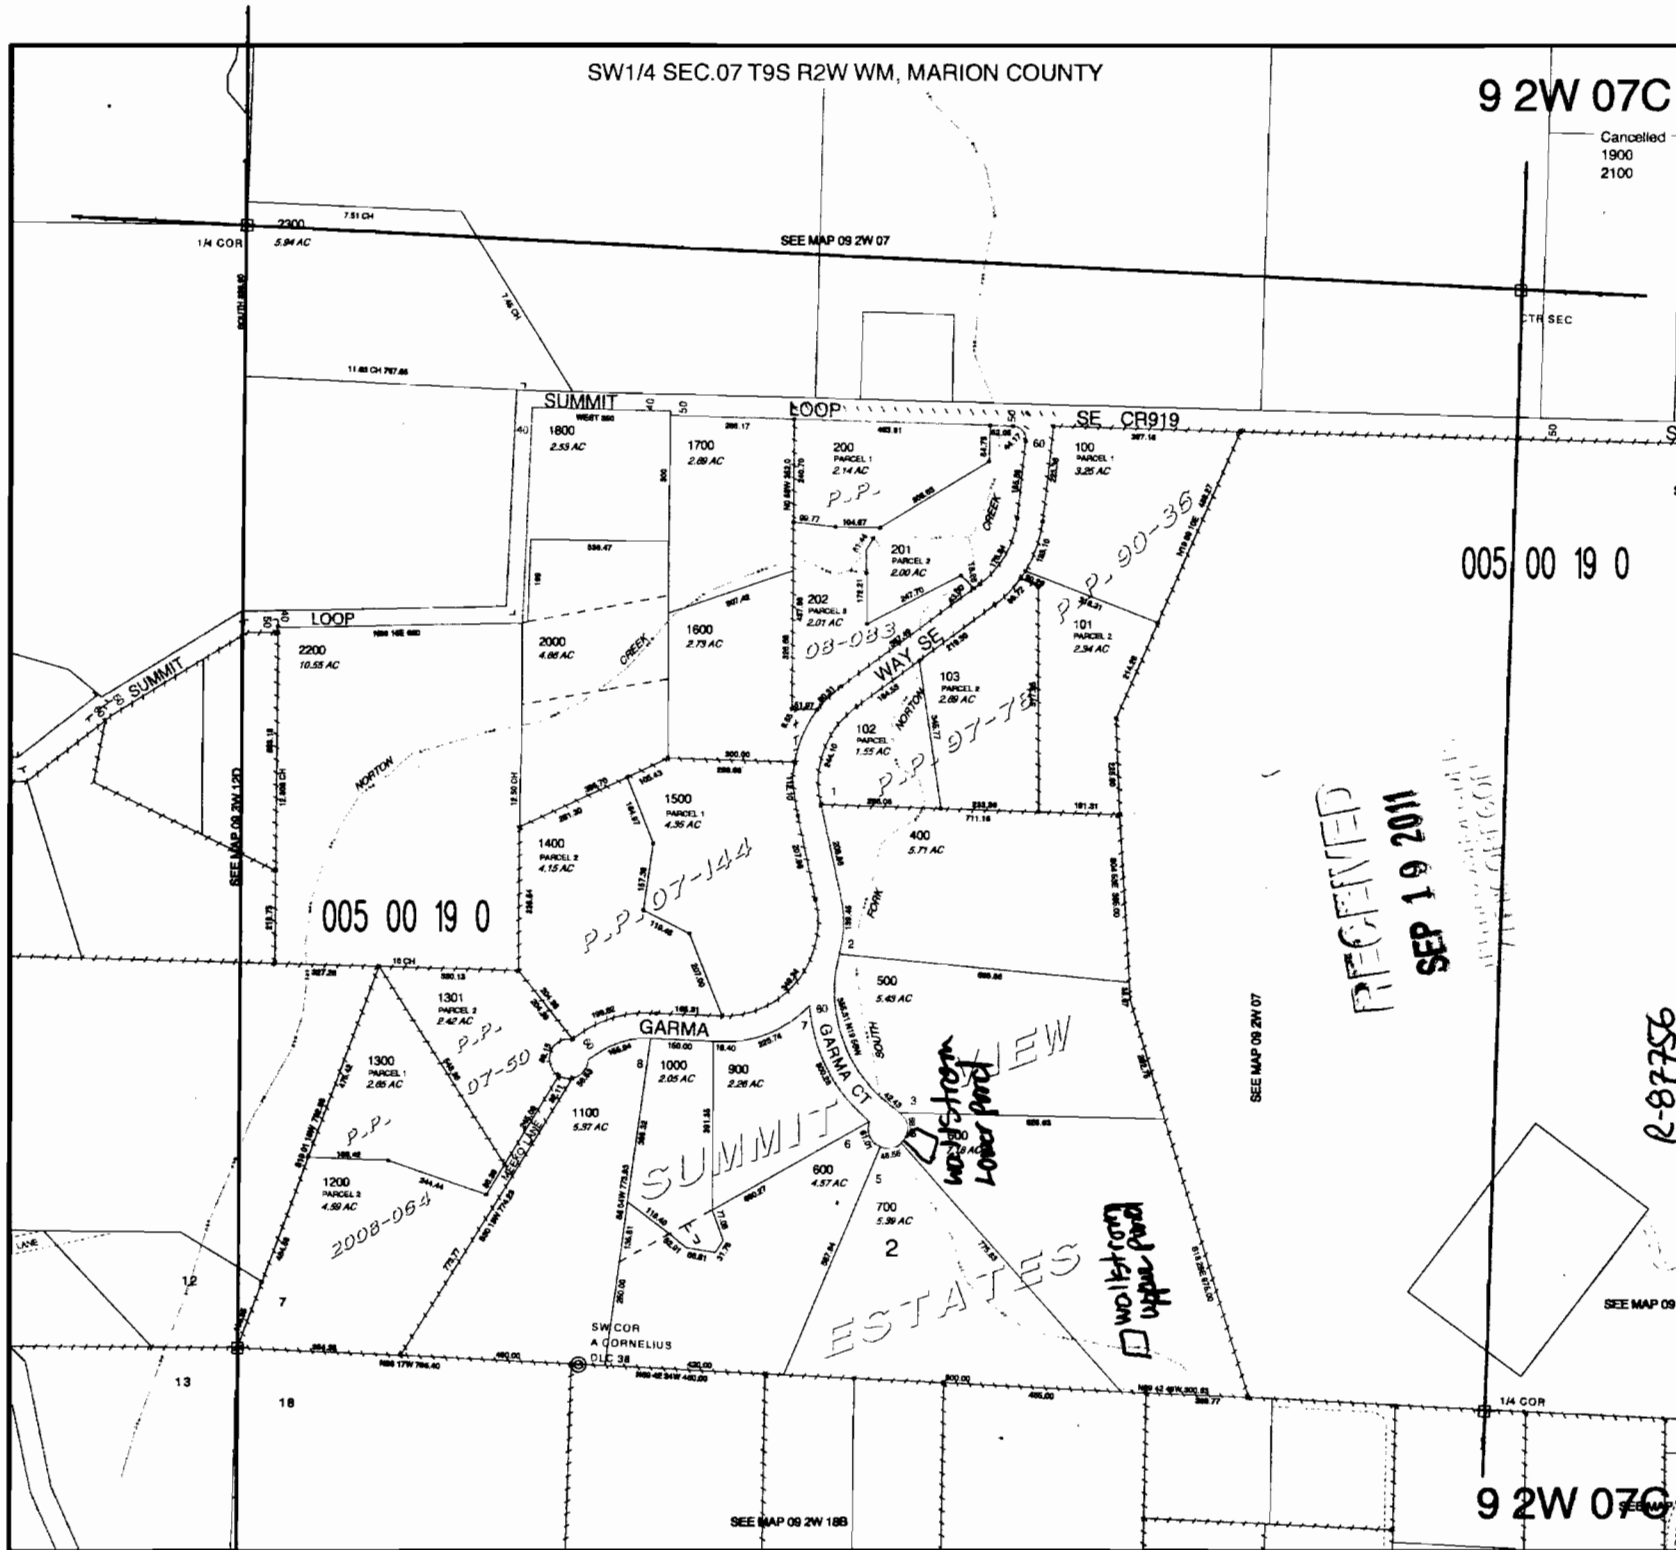

R-87756