


Water Rights Application Map

Located in portions of the SW 1/4 SW 1/4 and
the SE 1/4 NW 1/4 Section 26, Township 30 South,
Range 14 West, Willamette Meridian
Curry County, Oregon

NOTE:
THE P.O.D. IS AN IN-SPRING
PLASTIC 55 GALLON BARREL.
WHICH IS LOCATED 3989 FEET
WEST AND 4213 FEET SOUTH
OF THE SECTION CORNER
COMMON TO SECTIONS 23, 24,
25, 26, T.30S, R. 14W, WM.
1987 BLM BCIP

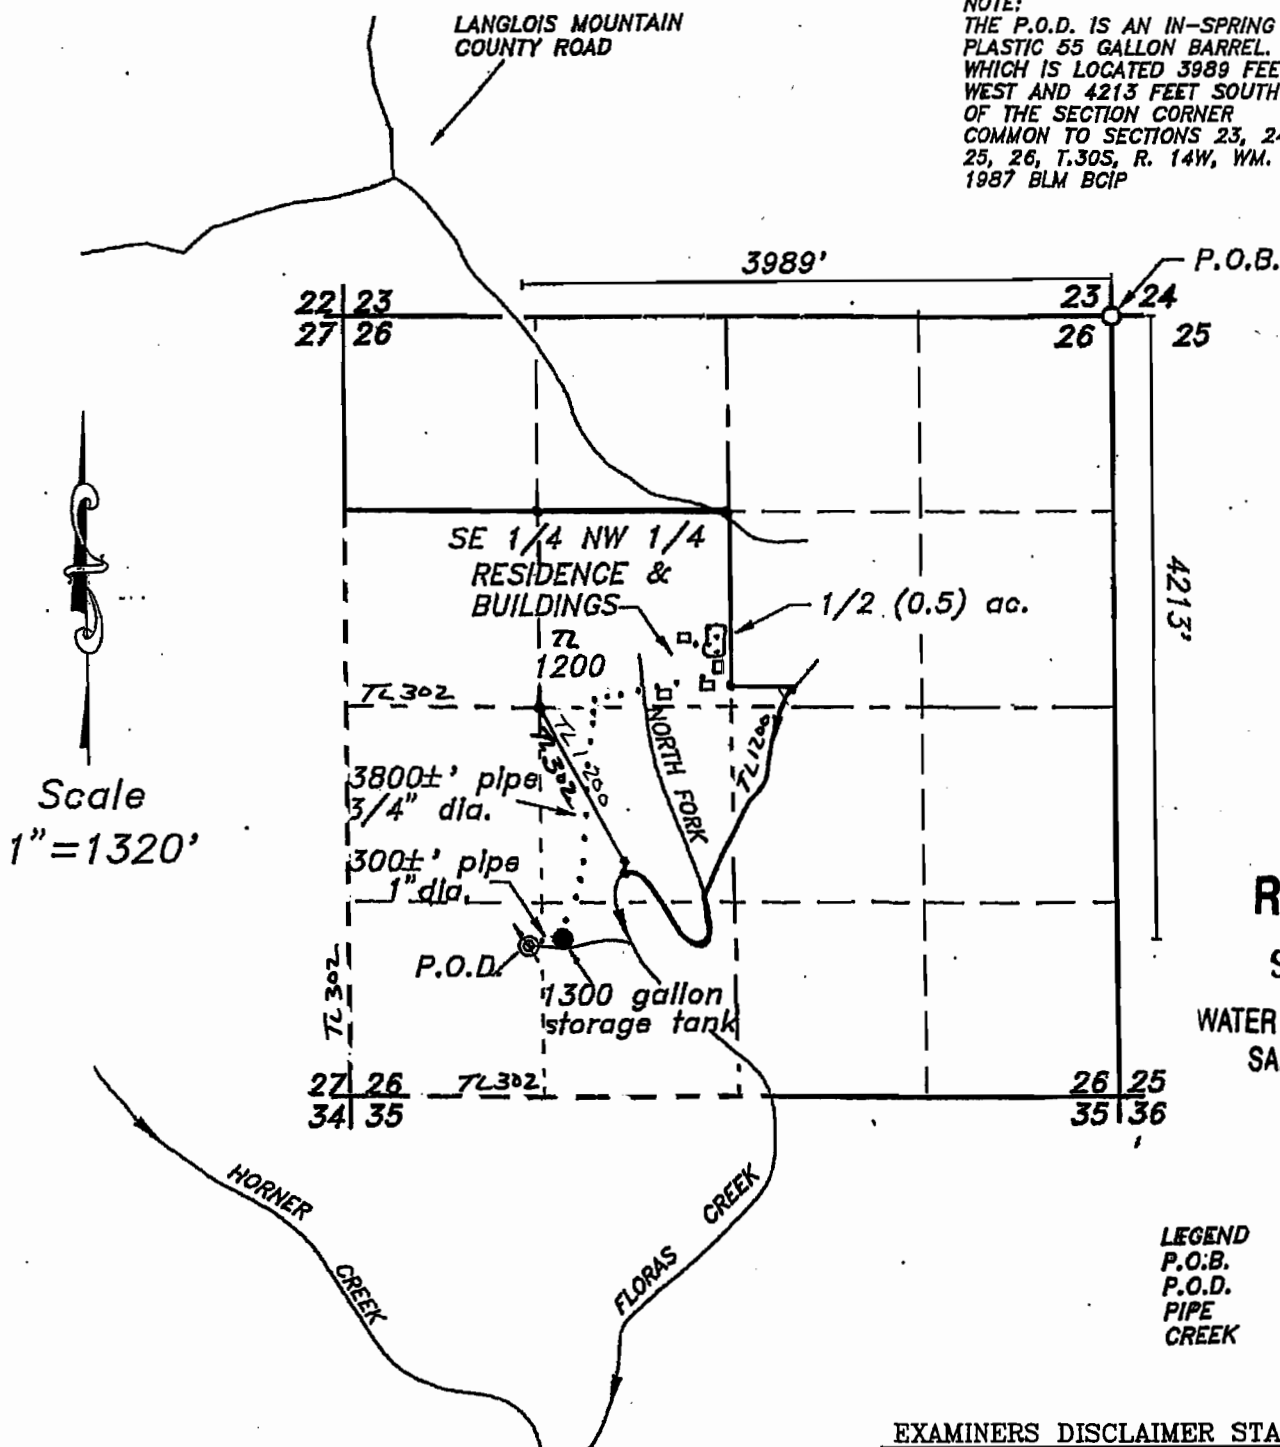

RECEIVED

SEP 20 2011

WATER RESOURCES DEPT
SALEM, OREGON

EXAMINERS DISCLAIMER STATEMENT

The preparation of this map was for the purpose of
identifying the location of the Water Right only and
has no intent to provide dimensions or location of
property ownership lines.

S-07757