


Corrected Map
SECTION PLAT

2/24/2012

Section 12 Township 24S Range 32E
County of Harney State of Oregon

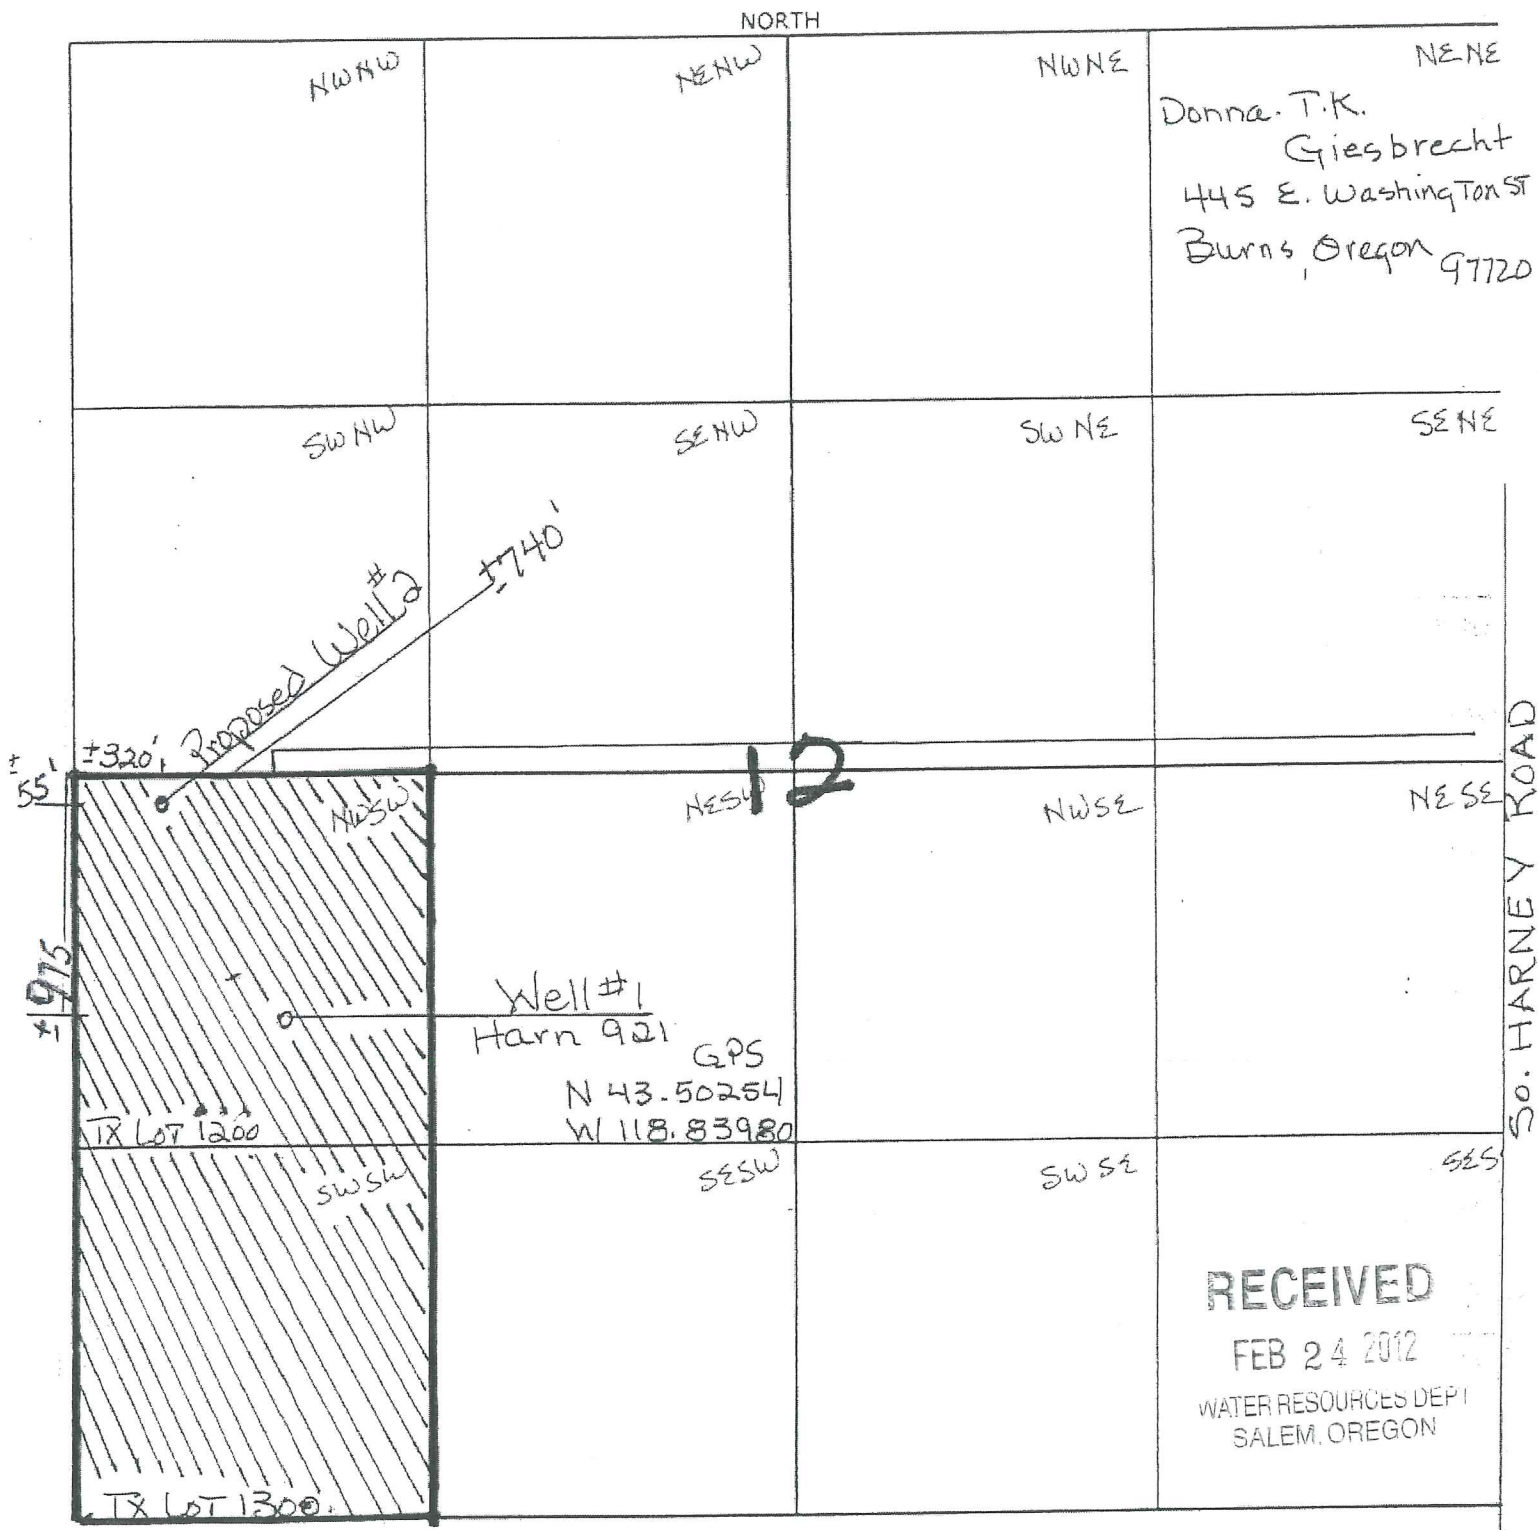


Help Prepared by:
Babe Hawk
County Asst. Watermaster

8" X 4" = 1 mile

App. G 17490

SECTION PLAT

Section 12 Township 24 S Range 32 E
 County of Harney State of Oregon

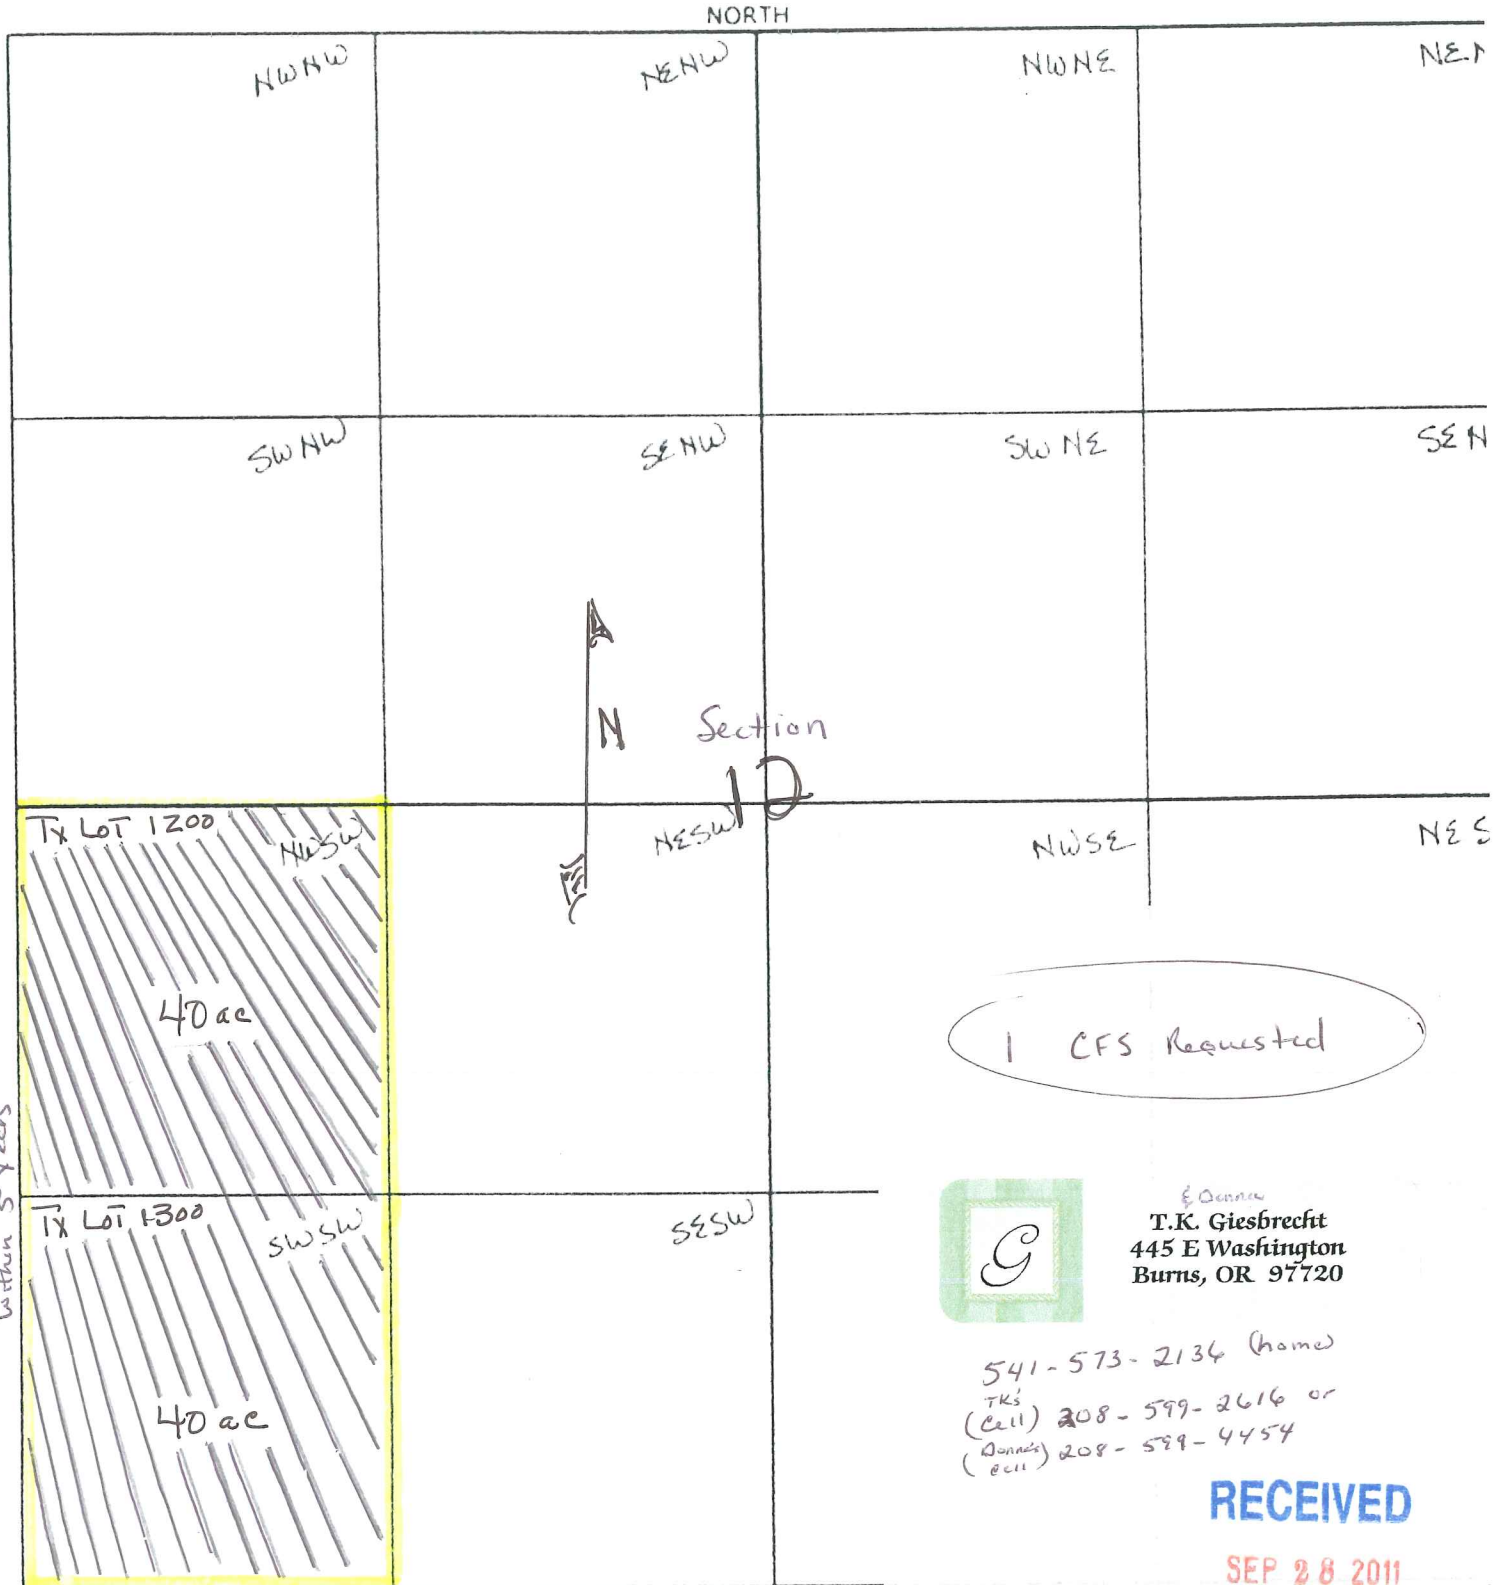

RECEIVED

SEP 28 2011

WATER RESOURCES DEPT
 SALEM, OREGON

4" = 1 mile


G-17490

Help prepared by
 Babe Hawk Asst. Wm
 Dist 10

ATTENTION:

MICHELE McAIEER
WATER RIGHTS CASEWORKER

SECTION PLAT

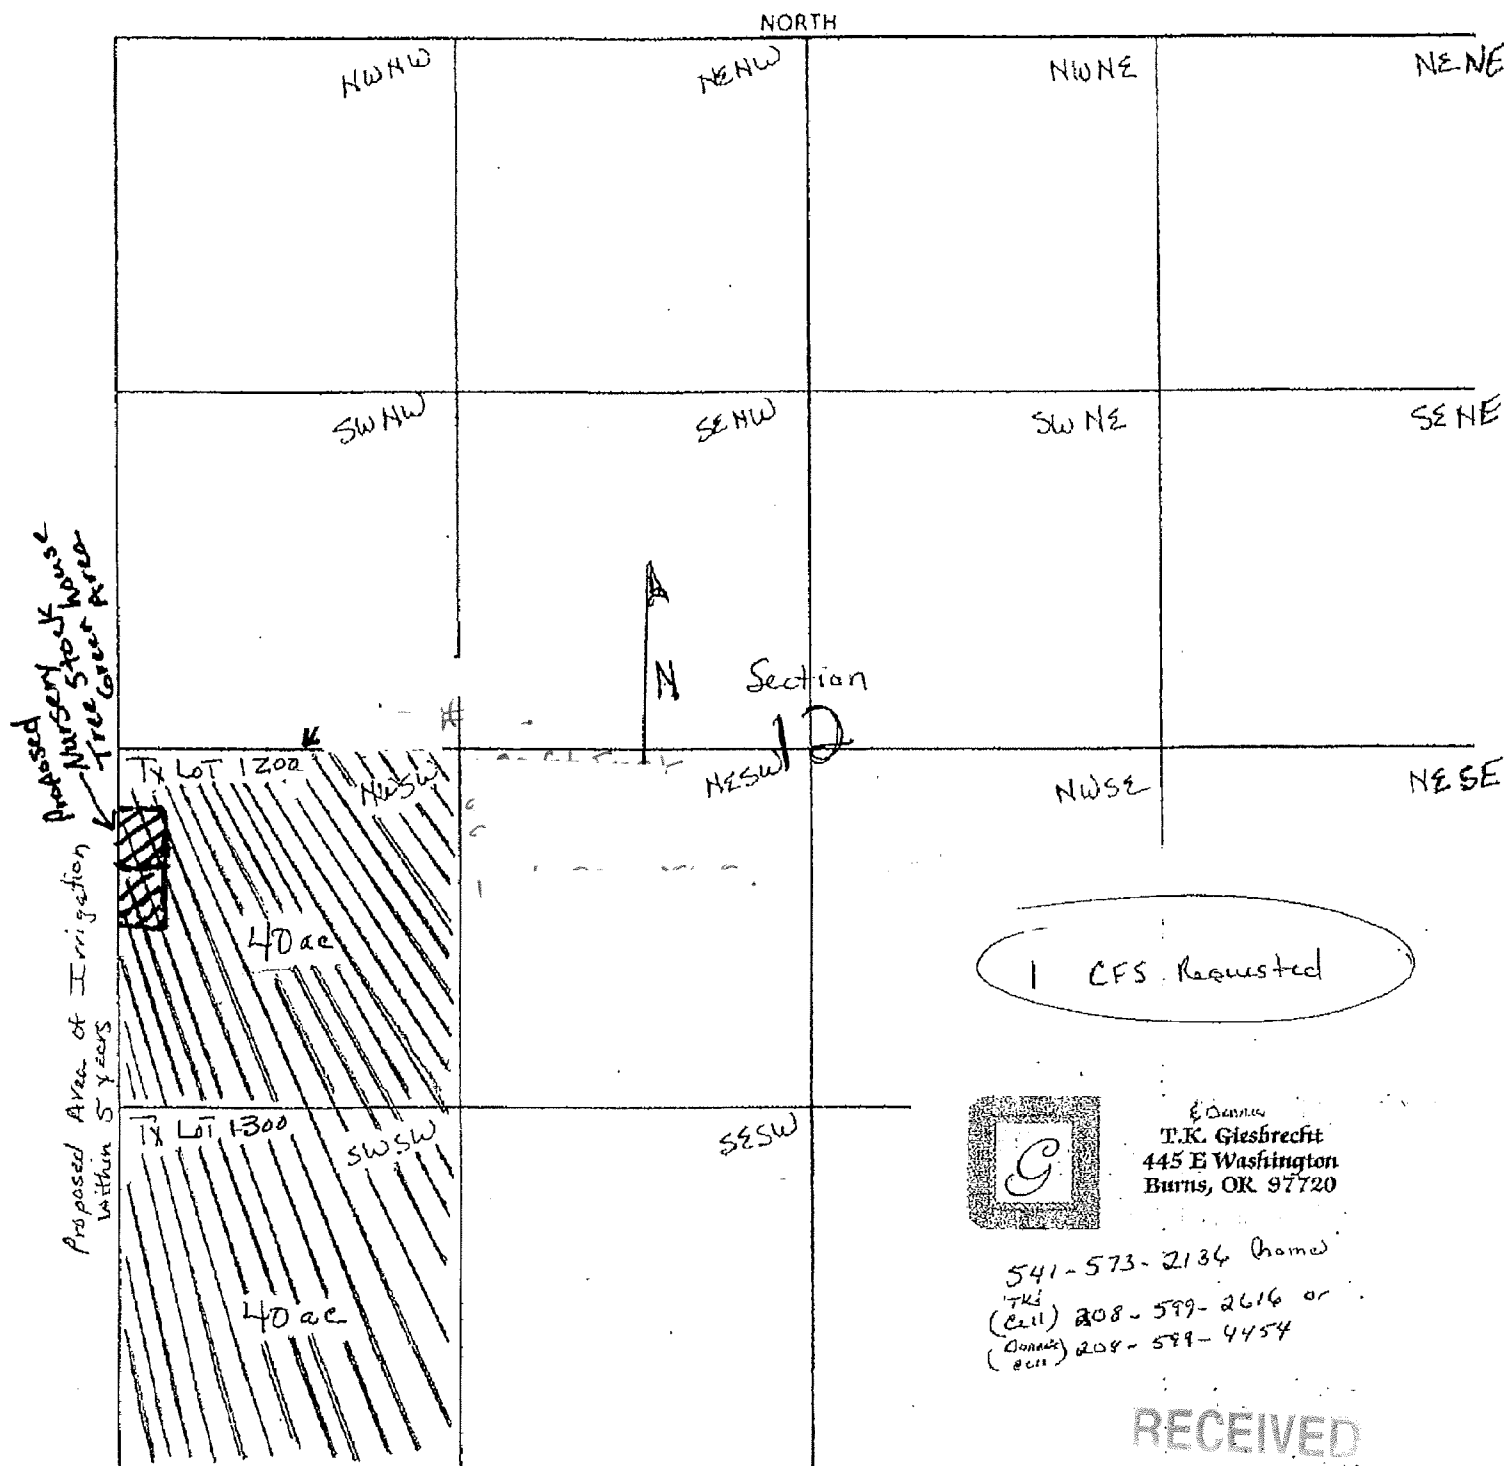Application # Section 12 Township 24 S Range 32 E
617490 County of Harney State of Oregonhelp provided by
Babe Hawk ASST. Wm
DIST 10

4" = 1 mile

6-17490E. Dennis
T.K. Giesbrecht
445 E Washington
Burns, OR 97720541-573-2134 Home
TKG
(cell) 208-599-2616 or
(Dennis) 208-599-4454
(cell)

RECEIVED

NOV 10 2011

WATER RESOURCES DEPT.
SALEM, OREGON

T.K. Giesbrecht
445 E Washtington
Burns, OR 97720

9

superseded
by 2/24/12 map

0 400 800
SCALE IN FEET

THIS MAP WAS PREPARED FOR
ASSESSMENT PURPOSE ONLY

SECTION 12 T.24S. R.32E. W.M.
HARNEY COUNTY

1"=400'

elevation of well: 4120 ft


24 32 12

RECEIVED


SEP 28 2011

WATER RESOURCES DEPT
SALEM, OREGON

G-17490

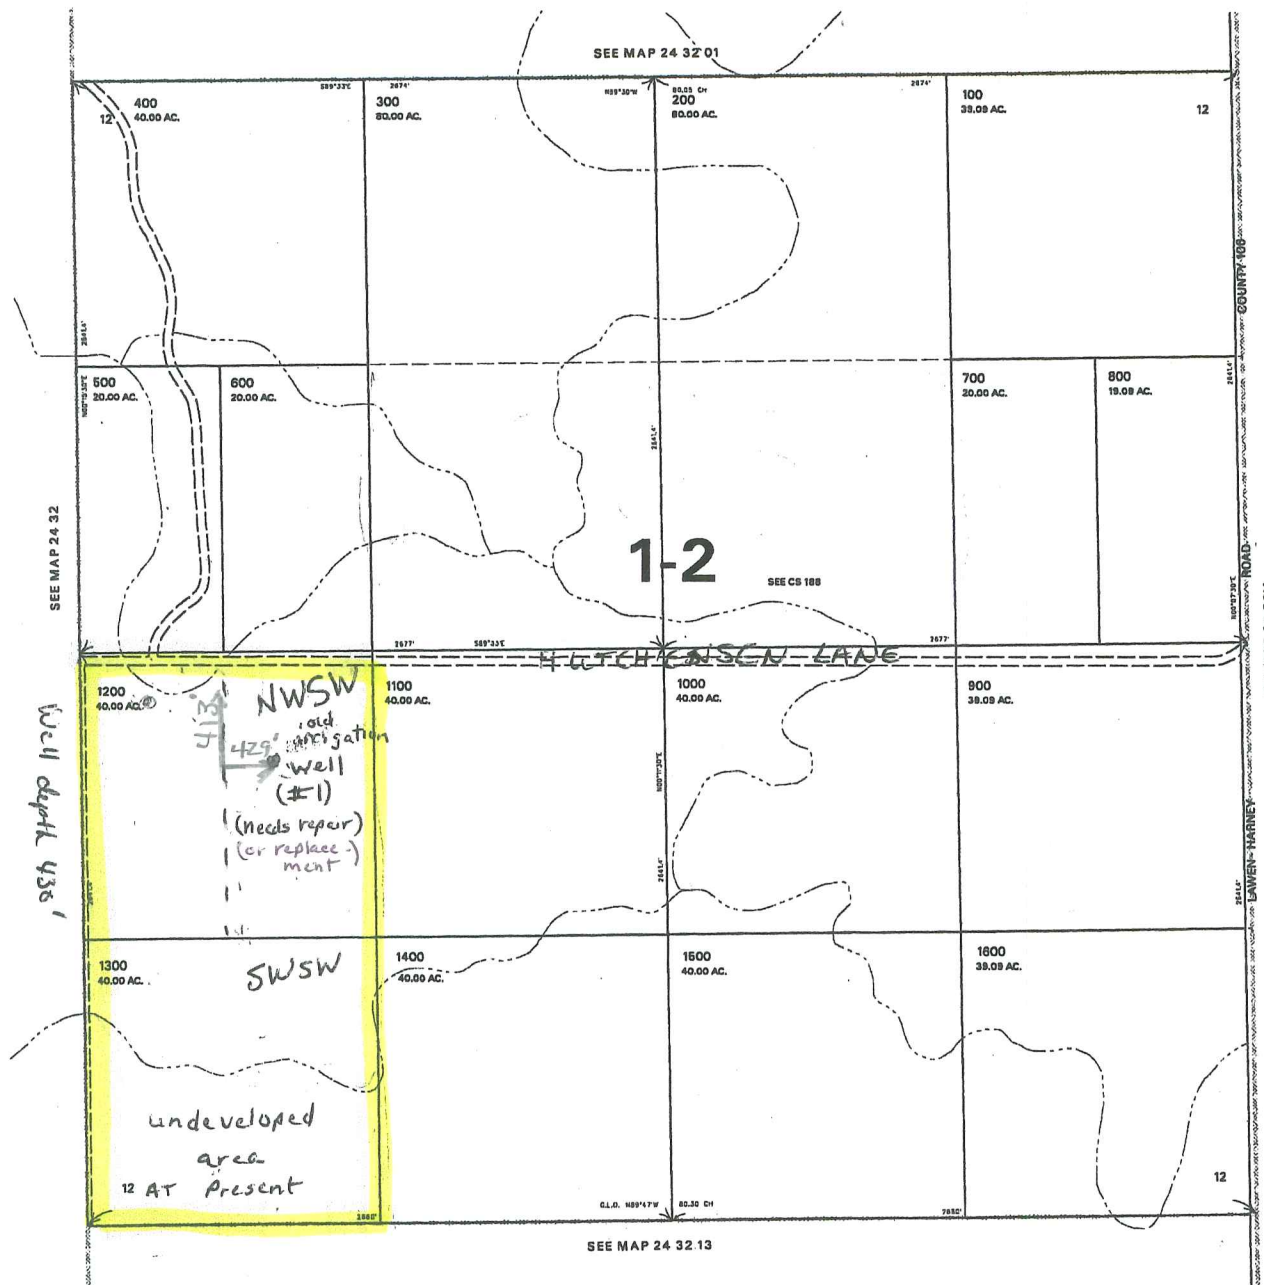

State of Oregon

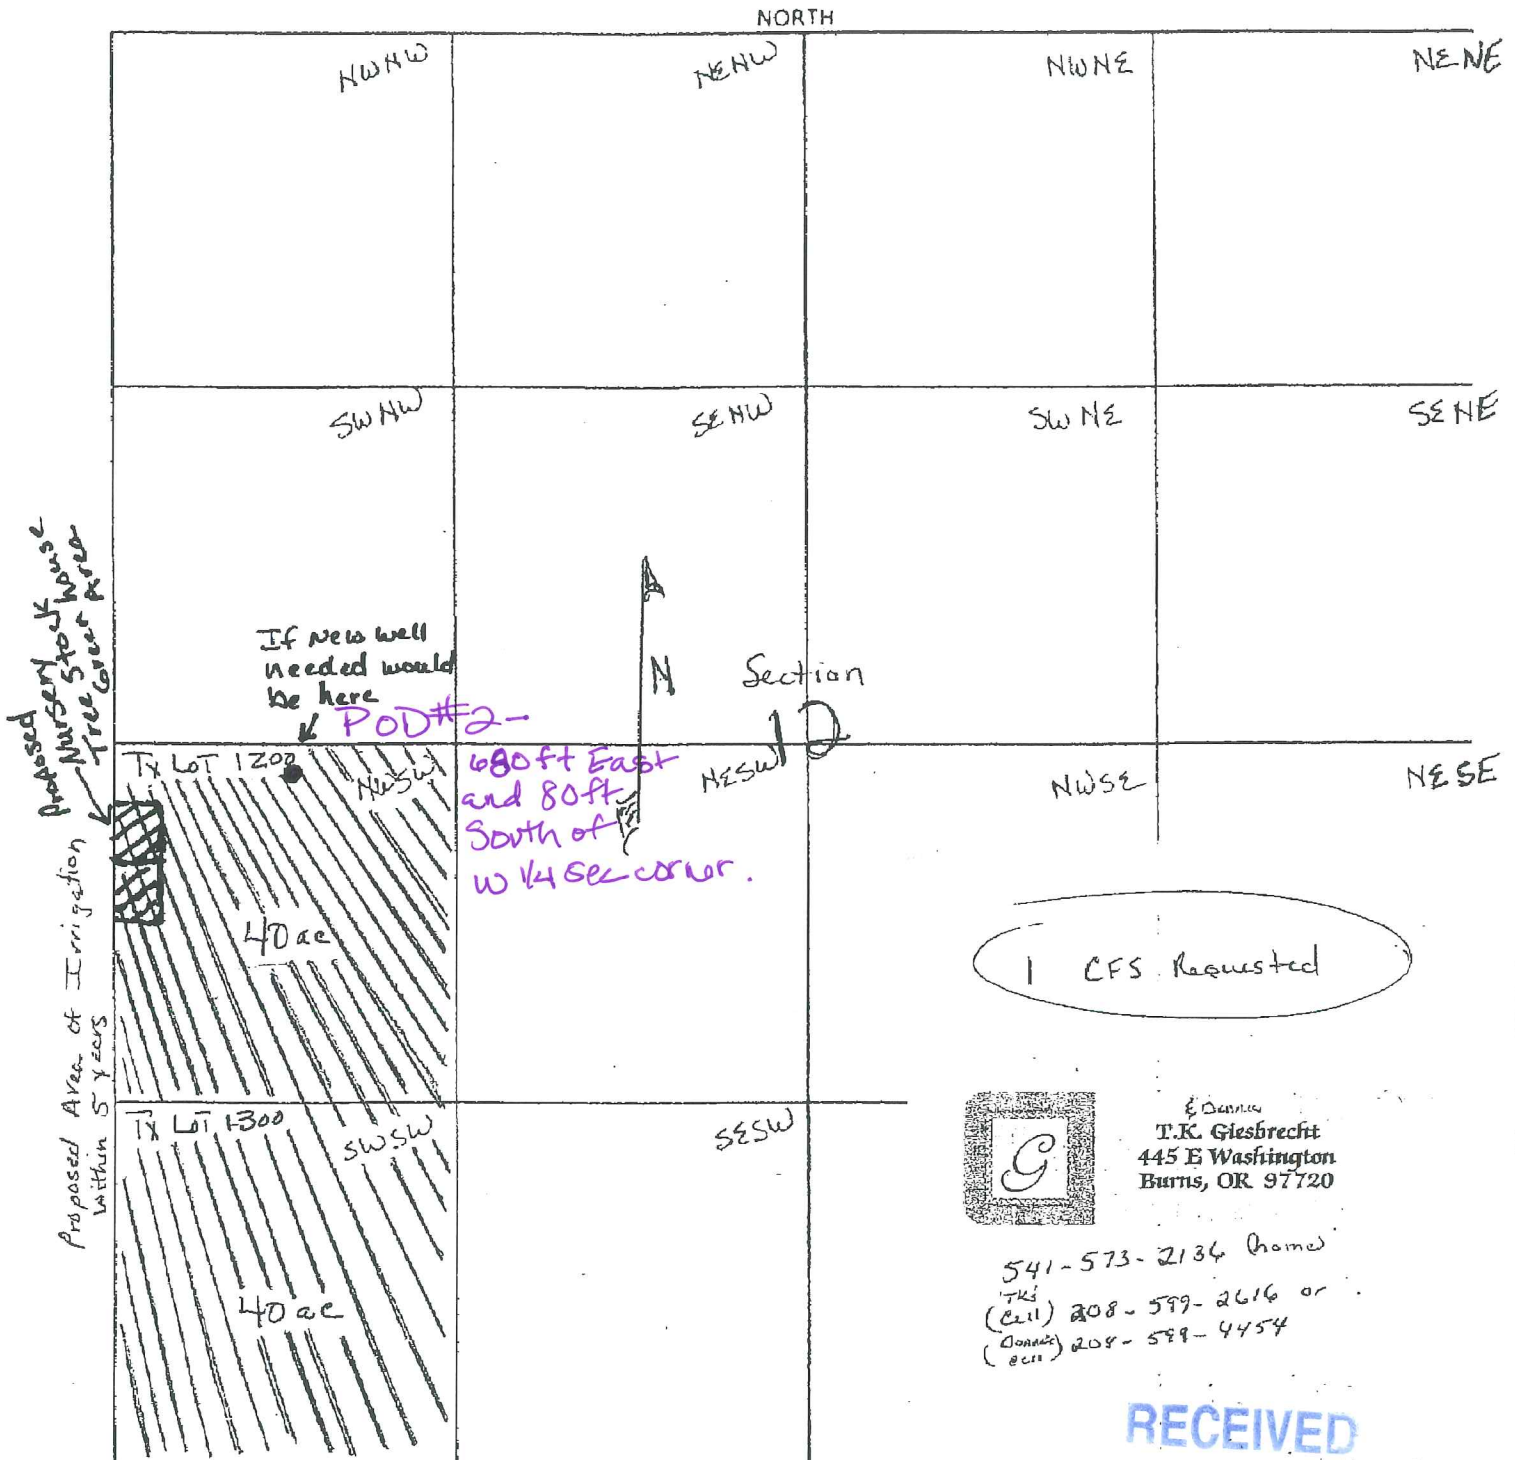

WATER RESOURCES DEPT
SALEM, OREGON