

SECTION PLAT

RECEIVED

Section 23

Township 26 S

Range 33 E

SEP 29 2011


County of Harney

State of Oregon

WATER RESOURCES DEPT
SALEM, OREGON

JAMES F. STUART WILSON

NORTH

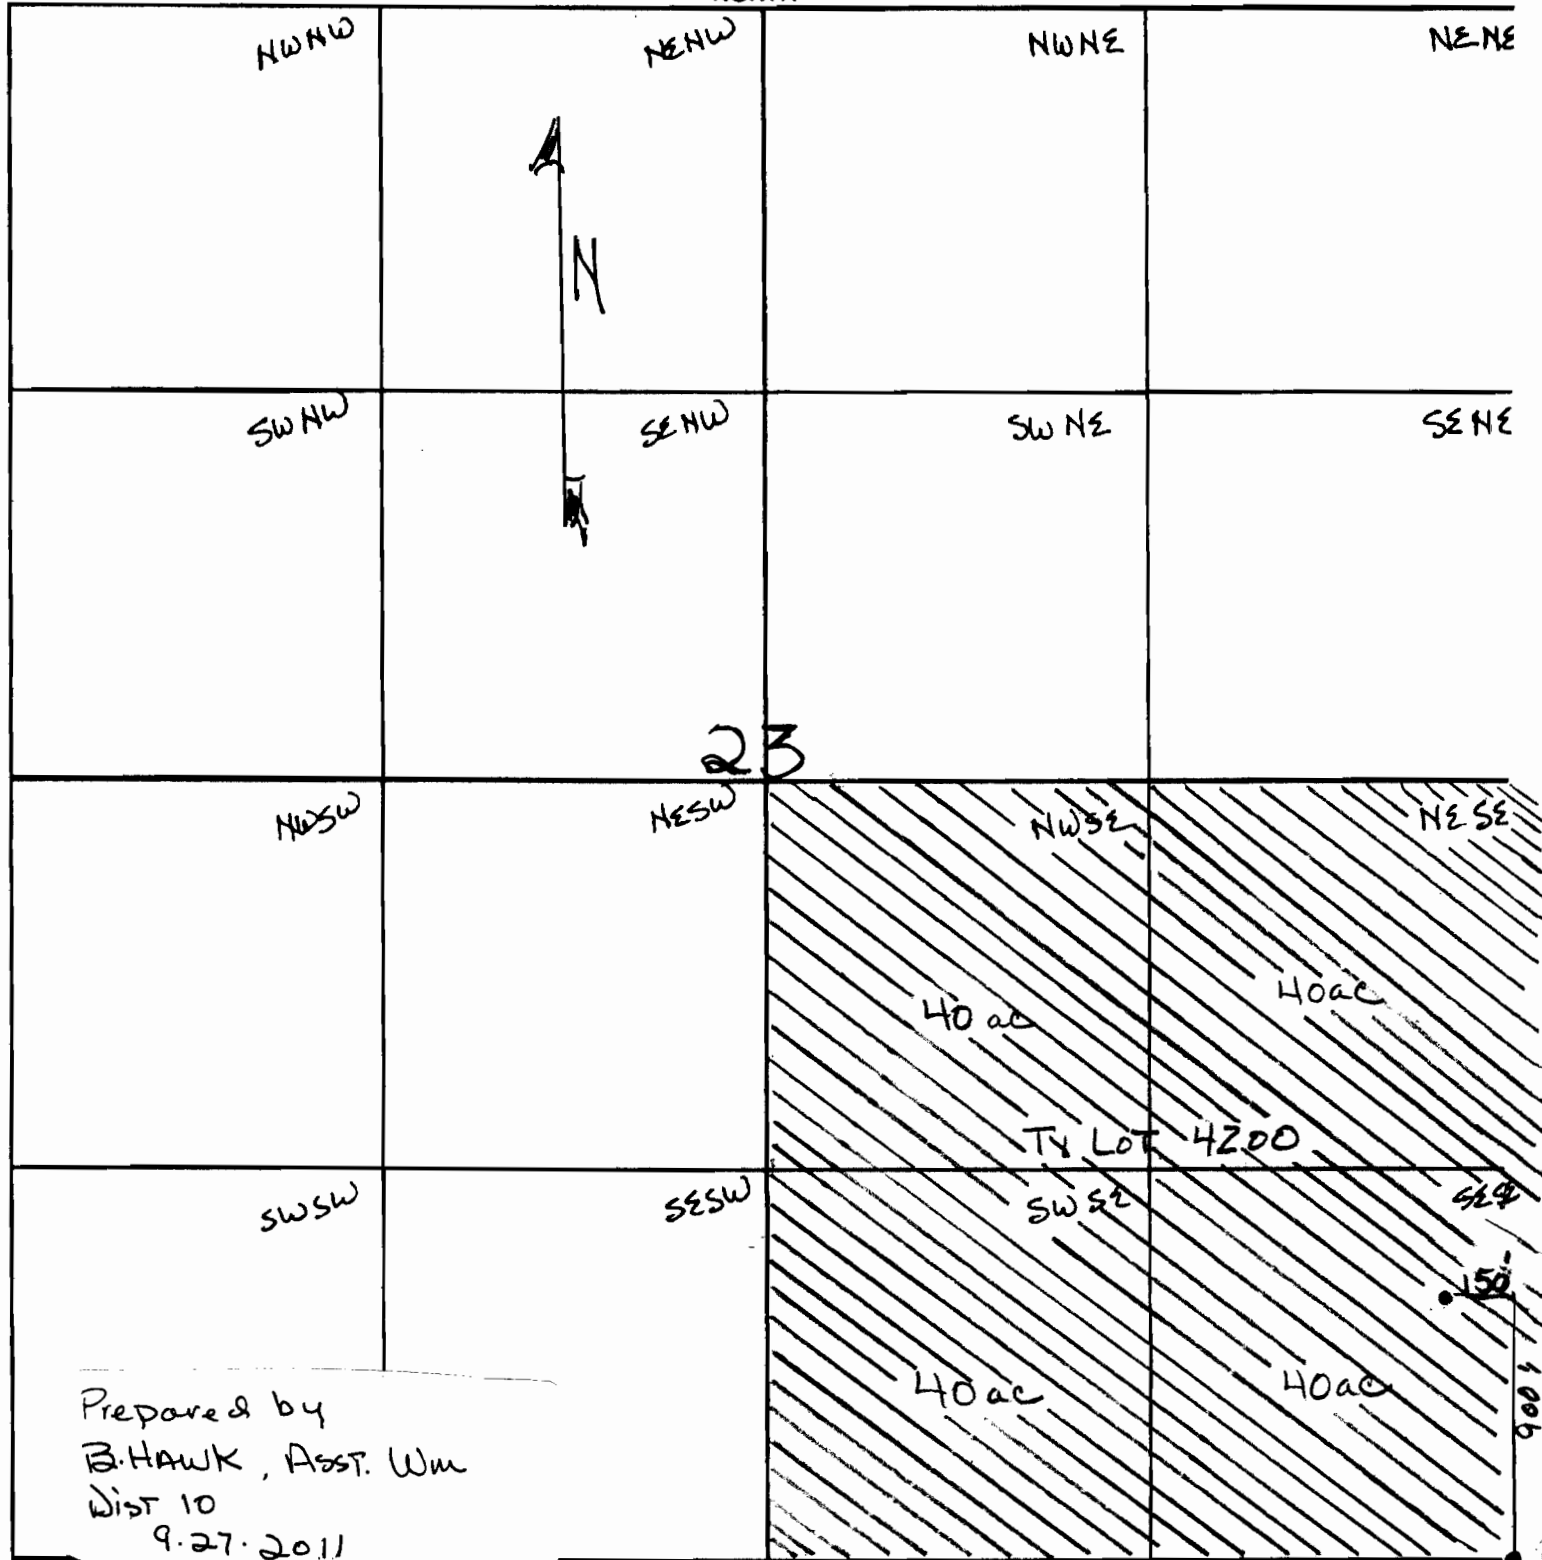

Prepared by
B. HAWK, Asst. Wm
Dist 10
9.27.2011

G-17489

4" = 1 mile