



# T. 1 N., R. 2 W., W.M.

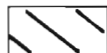

New irrigated acres

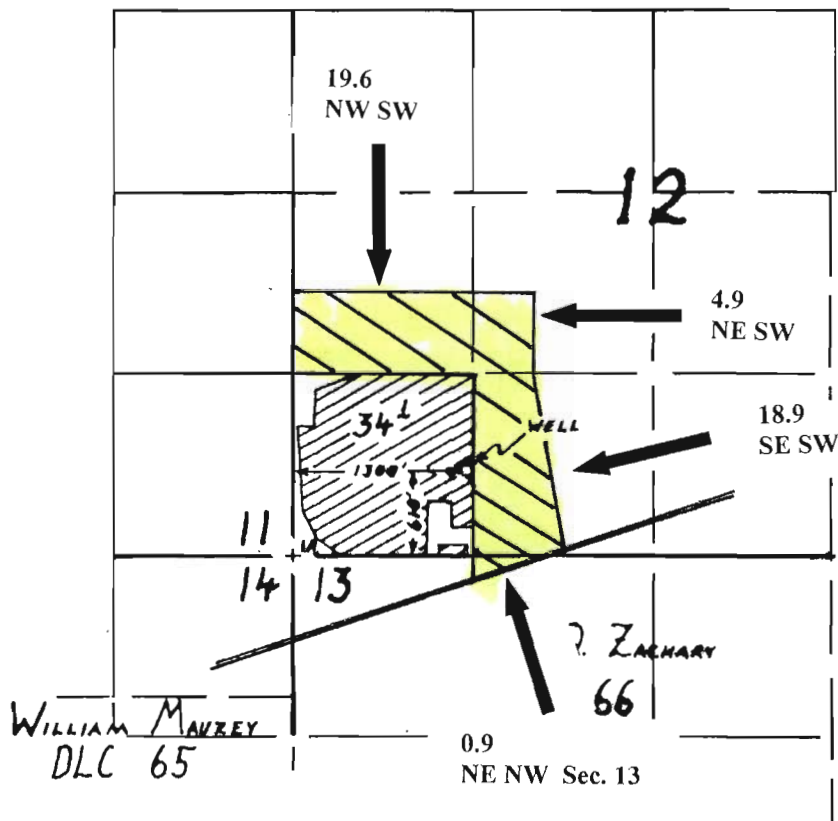

## FINAL PROOF SURVEY

UNDER

Application No. G-11636 Permit No. G-10766  
IN NAME OF

JEFF BODEN

Surveyed SEPTEMBER 6, 1992, by R.W. Klassen

**RECEIVED**

NOV 14 2011

WATER RESOURCES DEPT  
SALEM, OREGON

PT 5 W OF R/W 493

G-17504