


6-600
~~5-170~~

T. 1S., R. 38E., W. M.

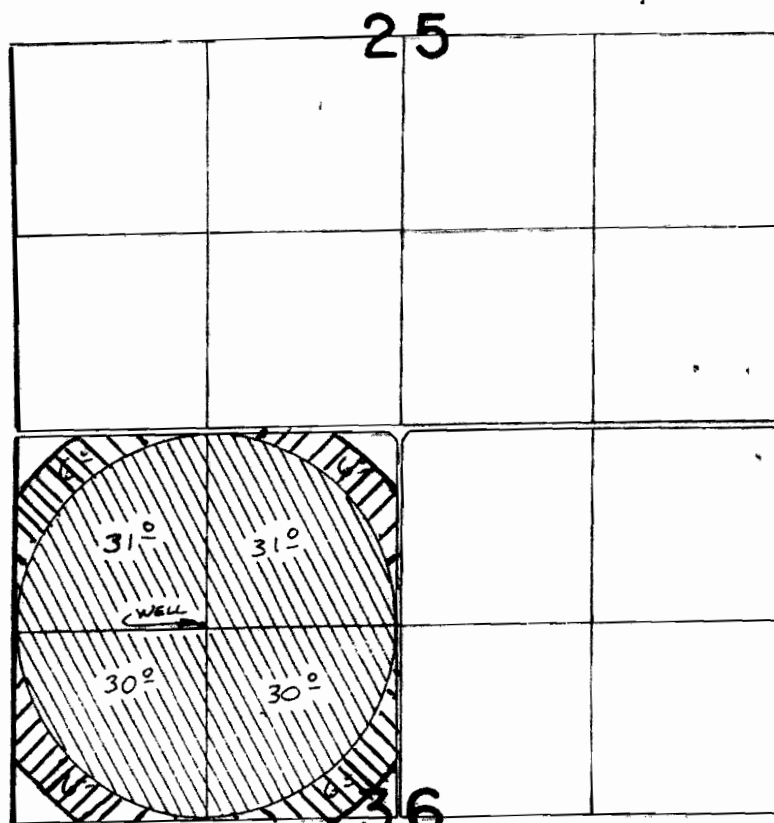

WELL LOCATED 1320'S & 1290'E FROM NW COR. SEC 36 T.1S. R.38E.

1
2

RECEIVED

NOV 23 2011

WATER RESOURCES DEPT
SALEM, OREGON

App No G.18981
Permit No G15644

G-17508


RECEIVED

APR 14 2003

WATER RESOURCES DEPT.
SALEM, OREGON

Scale 1" = 1320'

Arnoldus Groundwater Application Map
Township 1 South, Range 38 East, W.M.

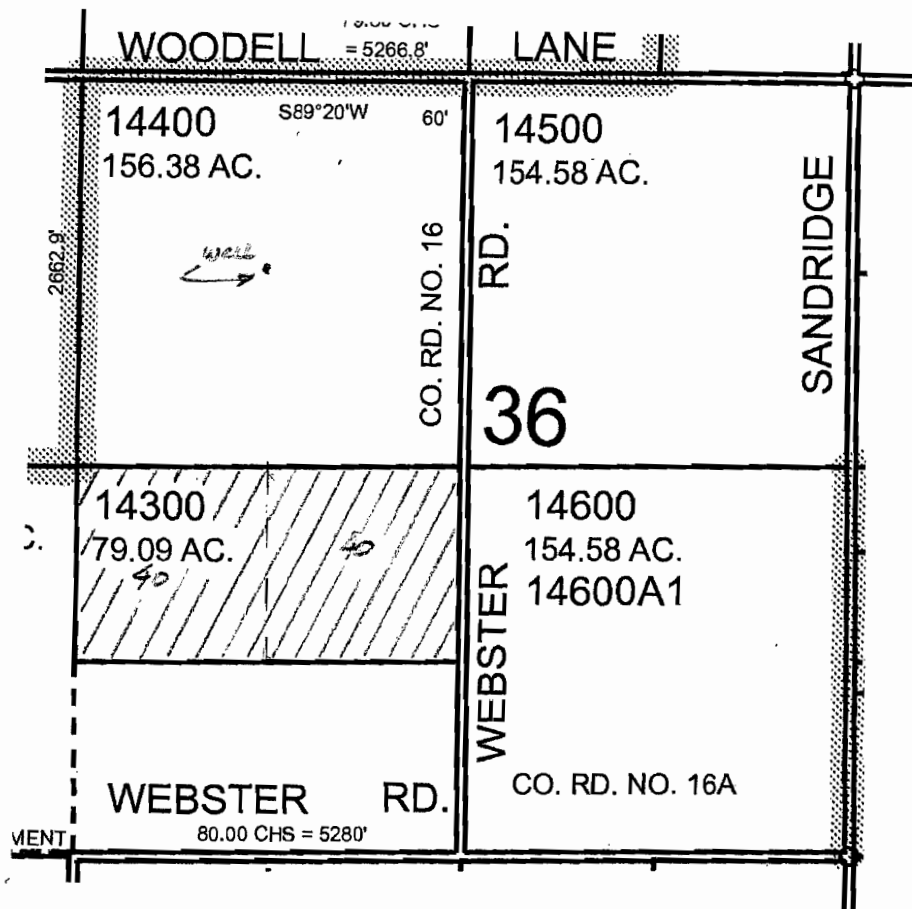

WELL LOCATED 1320' S + 1290' E FROM COR SEC 36 T1S. R38E

RECEIVED

NOV 3 3 2011


WATER RESOURCES DEPT
SALEM, OREGON

G-17508



Scale 1 inch = 1320 feet

Township 1 South, Range 38 East, W.M.

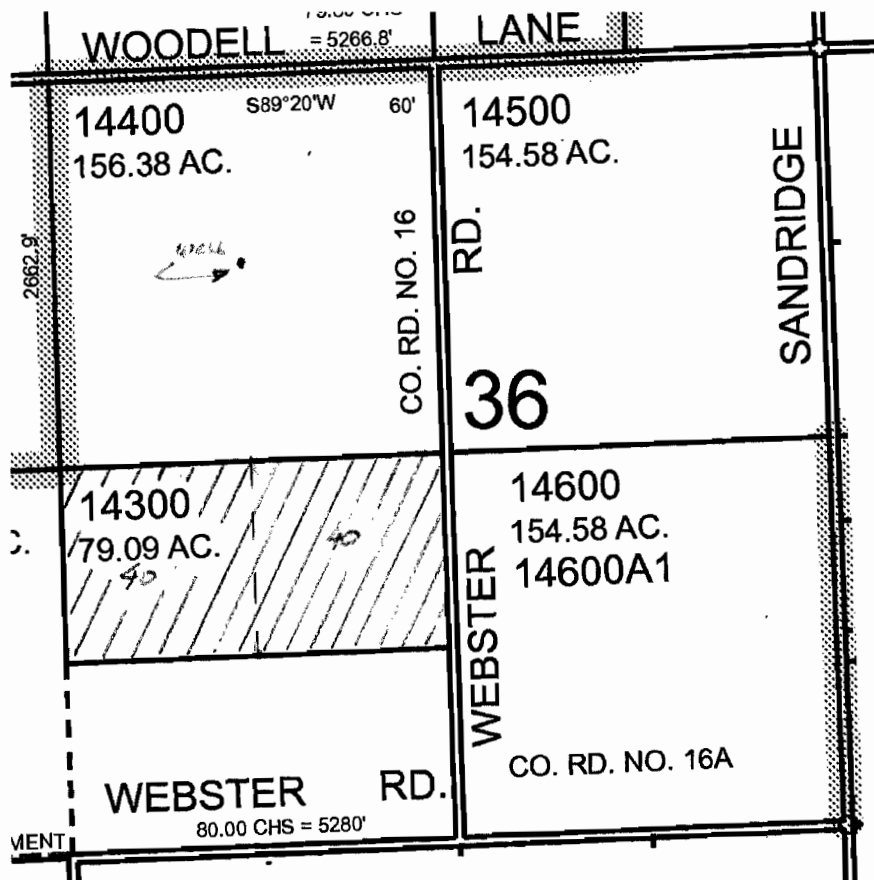


RECEIVED

NCV 3.3 2011

WATER RESOURCES DEPT
SALEM, OREGON

G-17508



Scale 1 inch = 1320 feet

EOT

EASTERN OREGON TITLE, INC.

1601 Adams Avenue, P.O. Box 1084

La Grande, OR 97850

Phone: (541) 963-8561 Fax: (541) 963-2391

TITLE INSURANCE

ESCROW CLOSING

ESCROW COLLECTION

THIS MAP IS FURNISHED ONLY AS A CONVIENCE IN LOCATING THE PROPERTY. THE COMPANY ASSUMES NO RESPONSIBILITY FOR ANY VARIATION THAT MAY BE DISCLOSED BY A SURVEY.

ORDER NO.: 11-21881

RECEIVED

NOV 2 2011

WATER RESOURCES DEPT
SALEM, OREGON

