


R-87770

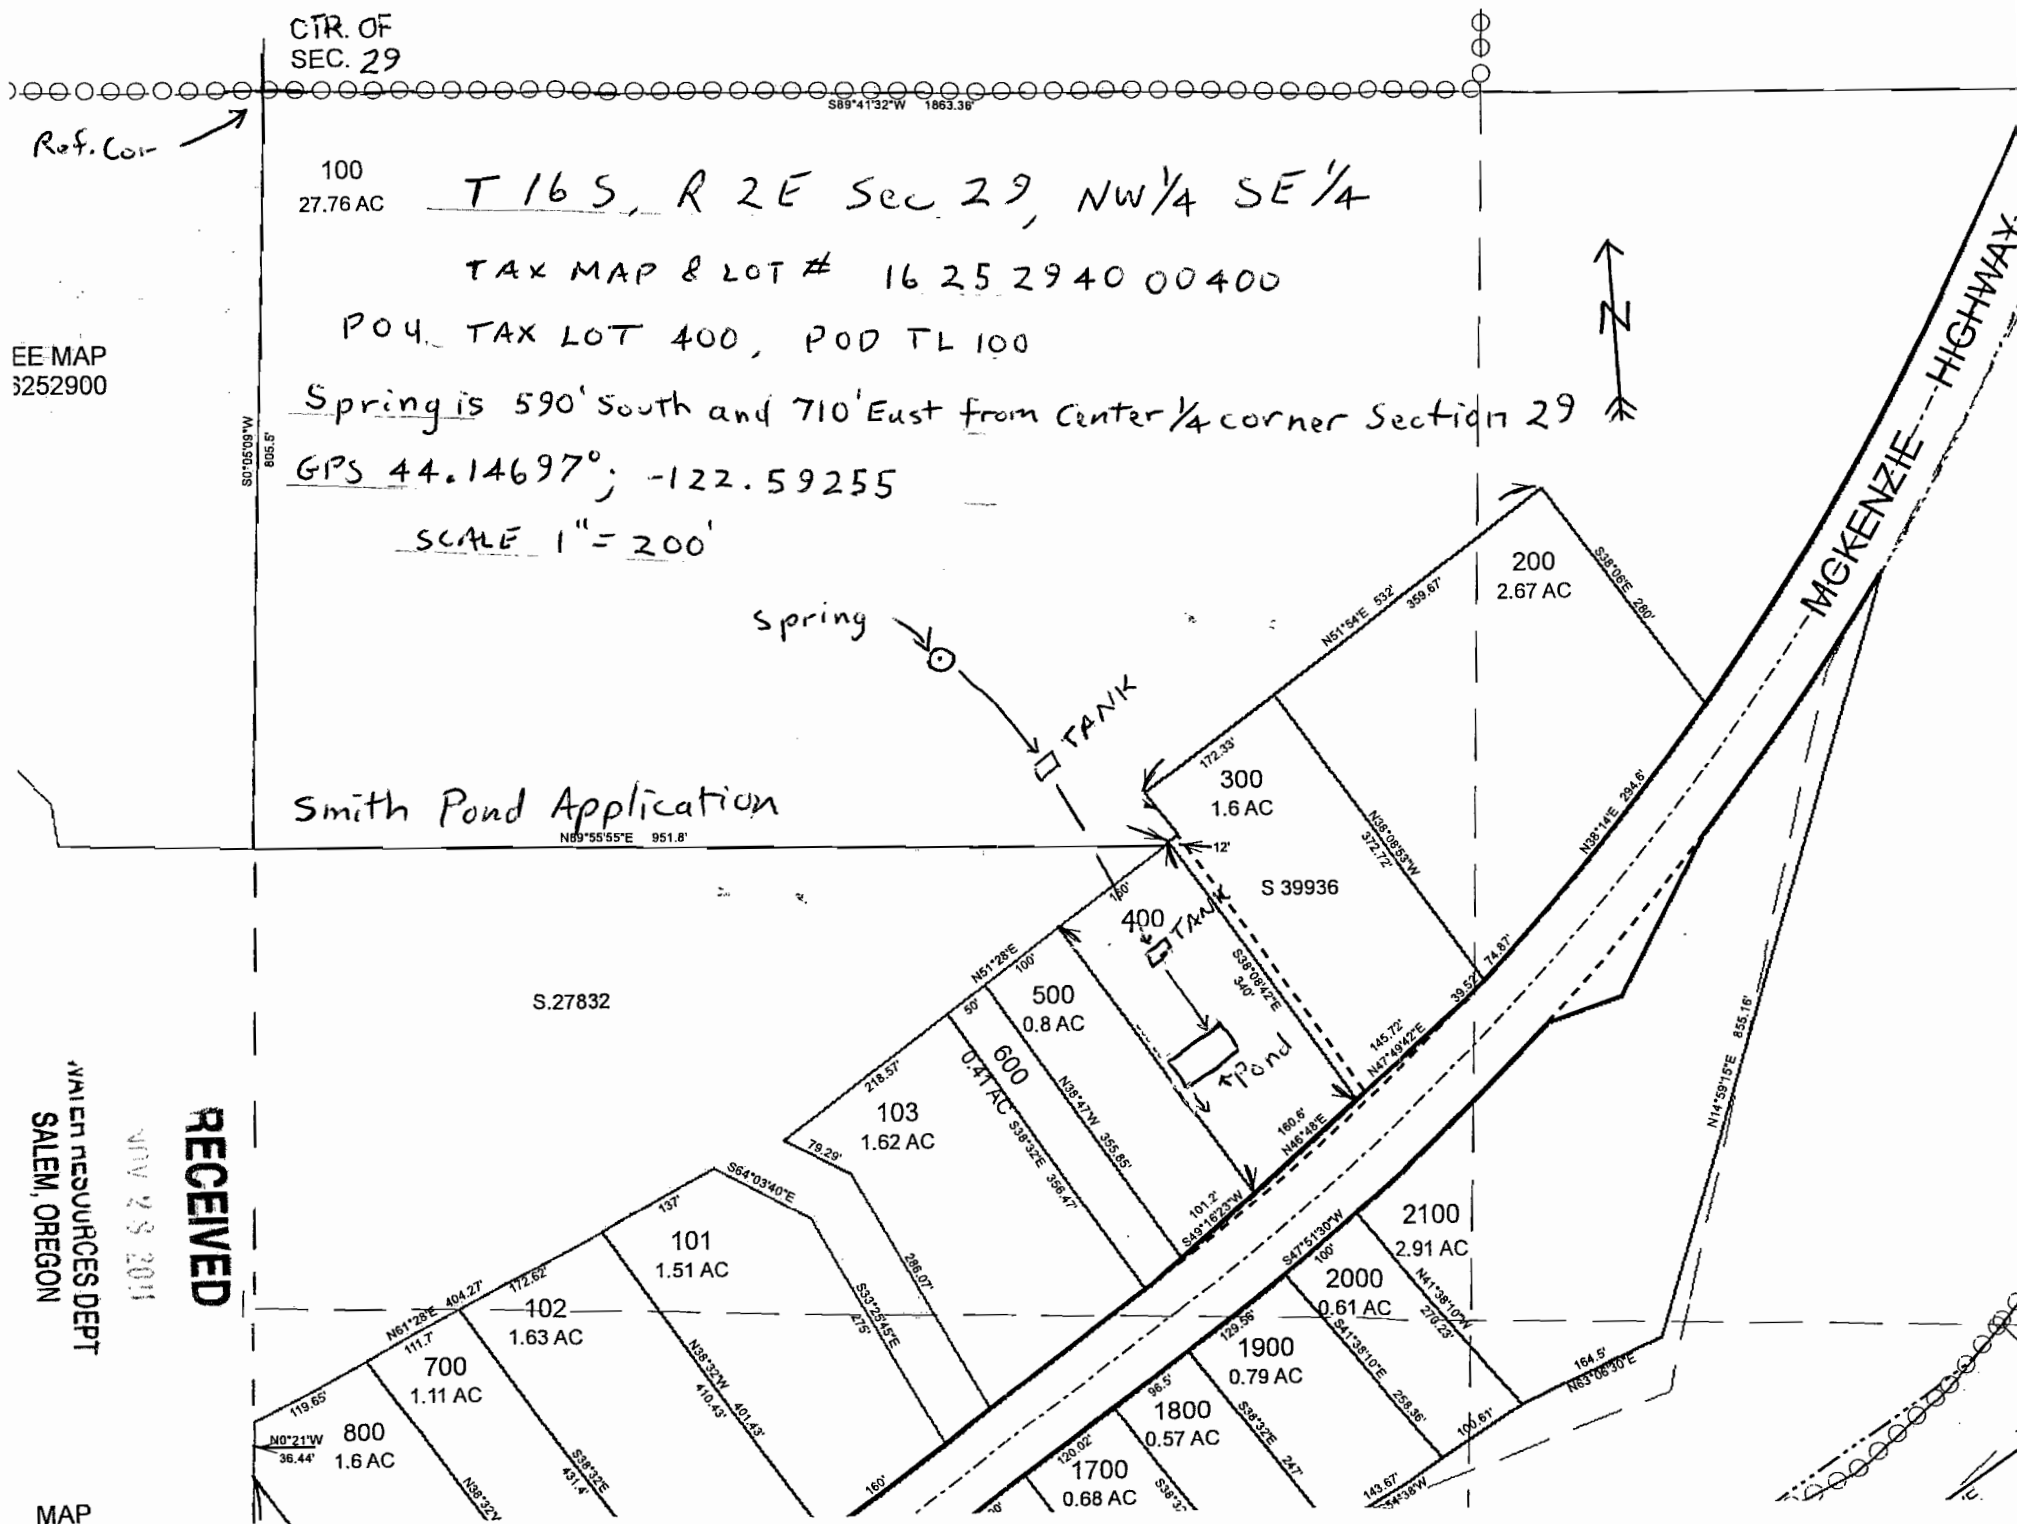

RECEIVED



SALEM, OREGON

MAP