


Prepared by:
Babe Hawk
West Water master
Dist. 10

SECTION PLAT

Section 31 Township 26S Range 33E
County of Harney State of Oregon

TX Lot 6400


NORTH

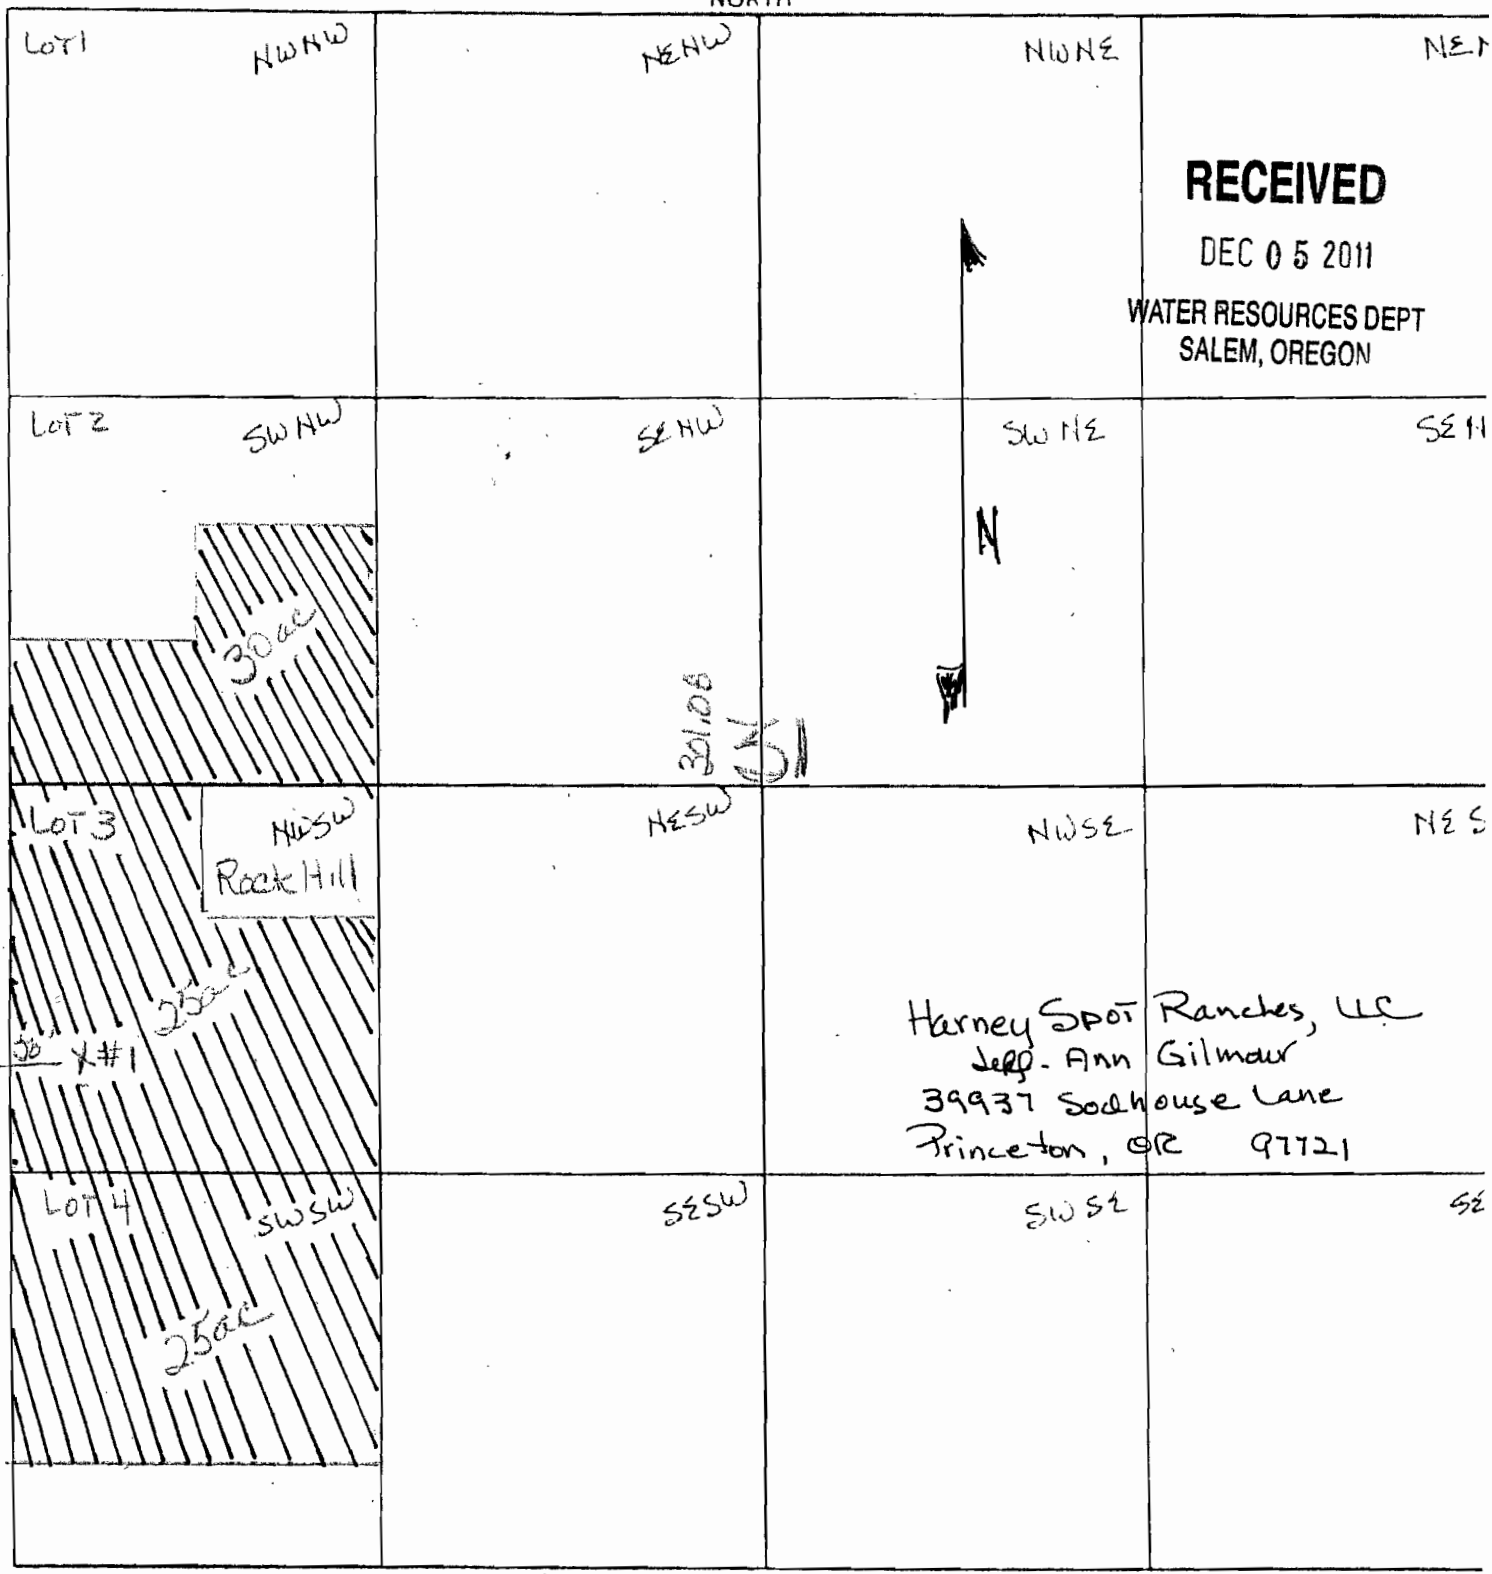

Reported by:
State of Oregon
1st. Watermaster
DIST 10

SECTION PLAT


Section 31 Township 26 S Range 33 E
County of Harney State of Oregon

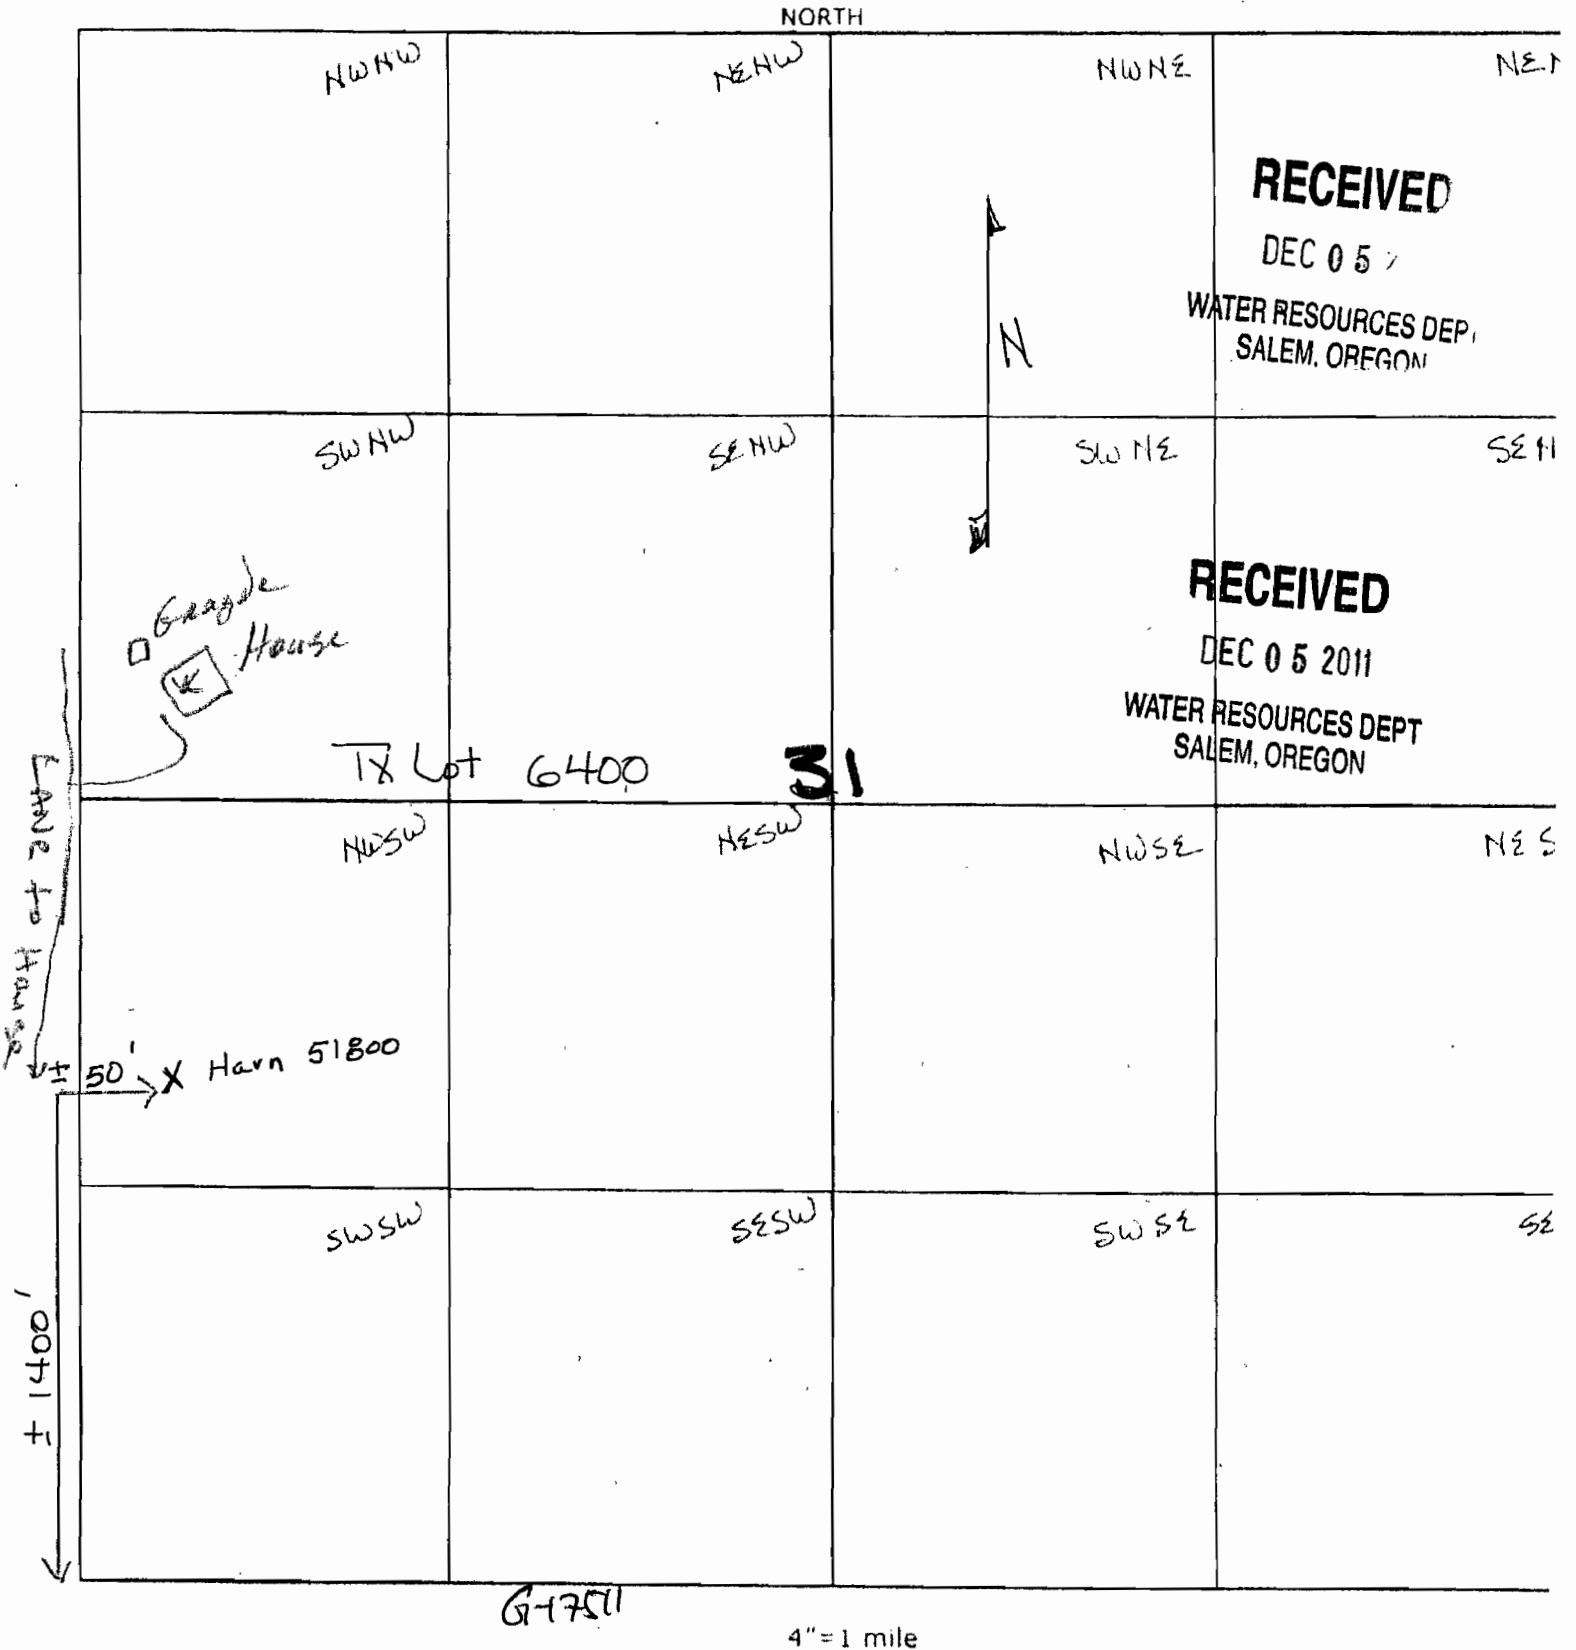

SECTION PLAT

Section 31 Township 26 S Range 33 E
 County of Harney State of Oregon

NORTH

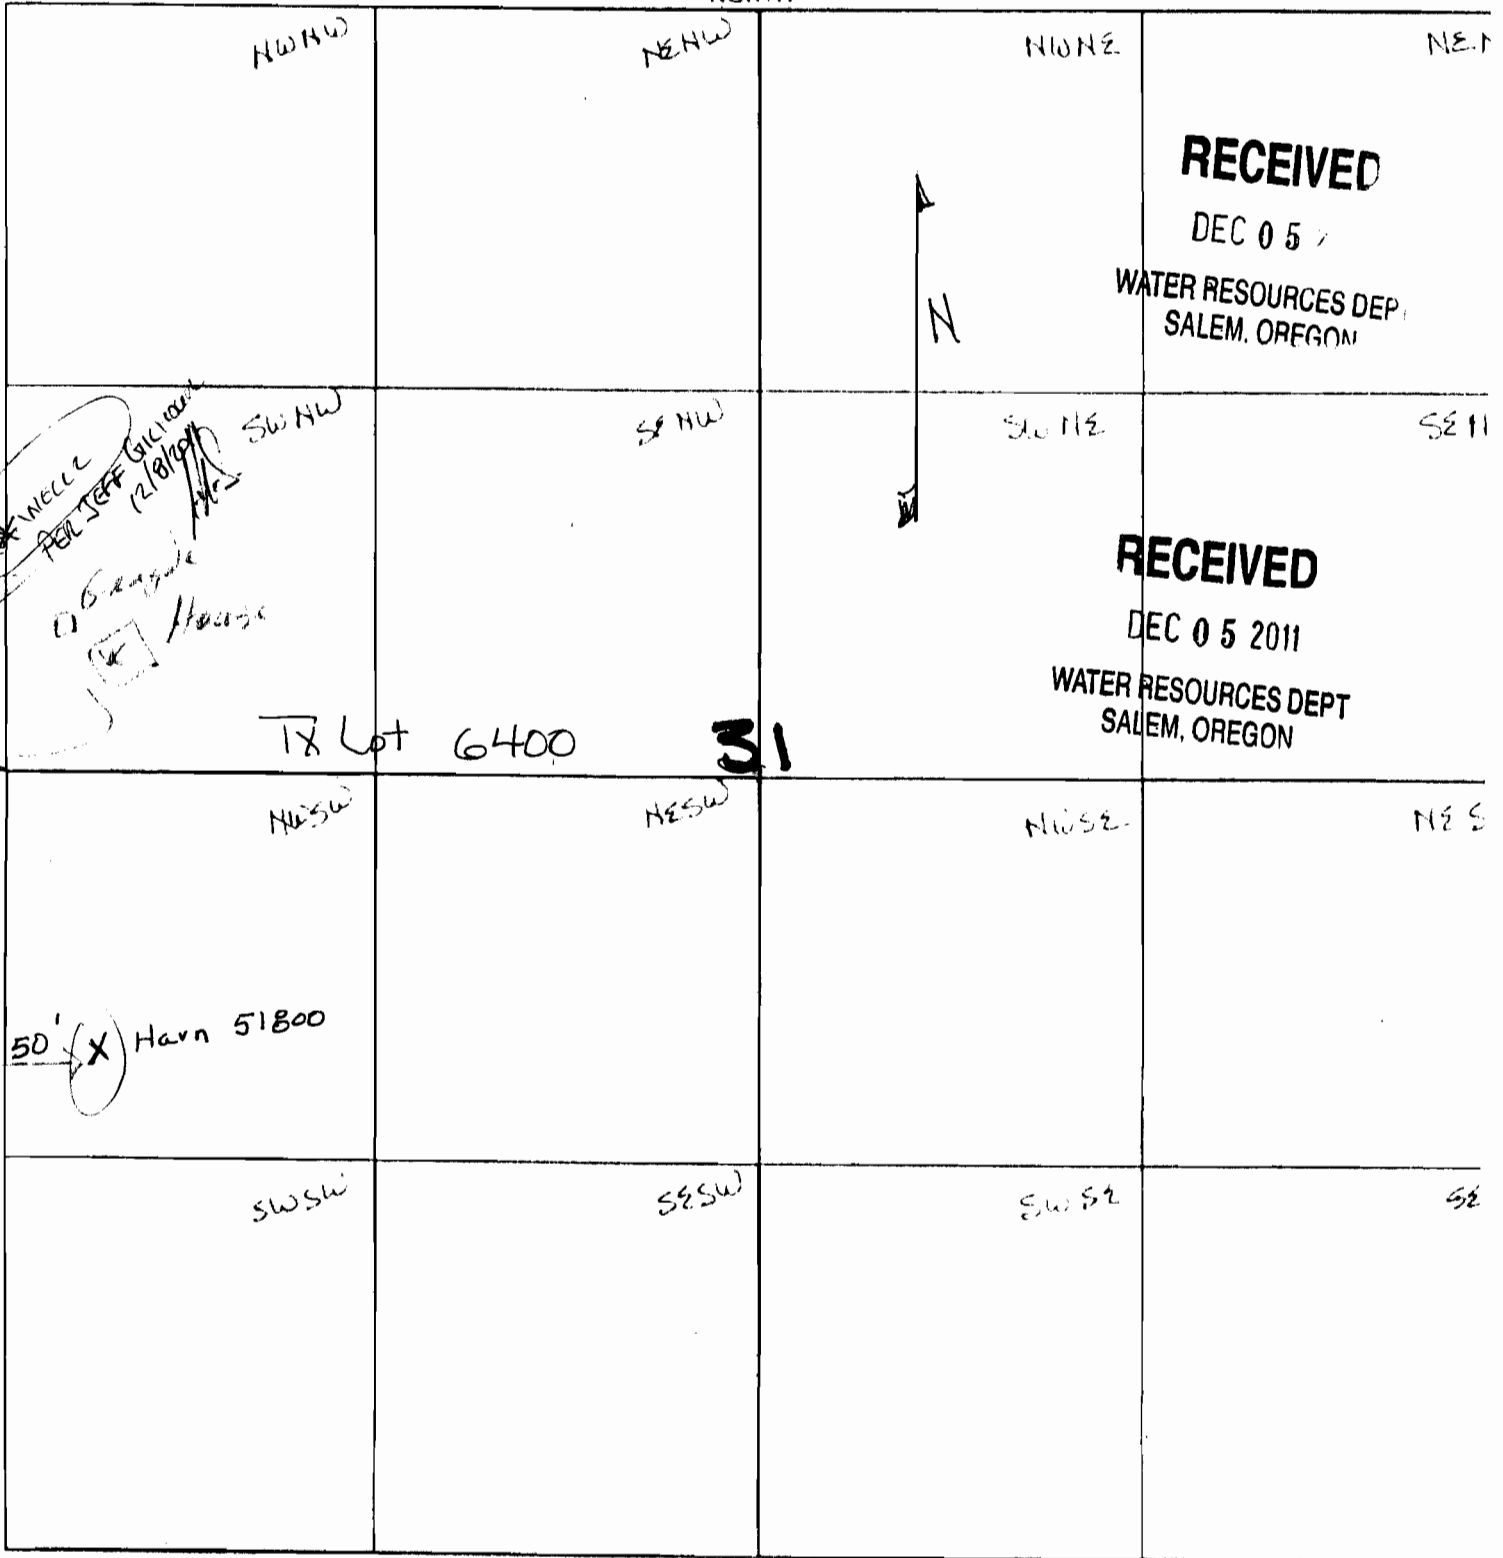

G-17511

4" = 1 mile

THIS MAP WAS PREPARED FOR
ASSESSMENT PURPOSE ONLY

T.26S. R.33E. W.M.
HARNEY COUNTY
1" = 2000'

26S 33E
& INDEX

SCALE IN FEET
0 2,000 4,000

RECEIVED

DEC 05

WATER RESOURCES DEPT
SALEM, OREGON

RECEIVED

DEC 05 2011

WATER RESOURCES DEPT
SALEM, OREGON

SEE MAP 26S 33E

LAKE

MALHEUR

SEE MAP
26S 33E 02

CANCELLED NO
2100M1
2100M2
2400M1
2500M1
2700
4300M1
5200M1
5300M2
5300M1
5400M1
5400M2
5300M1
6400M1
6500M1
7800 (2009)
101
500M1
500M2
500M3
500M4
500M5
500M6
500M7
500M8
500M9
500M10
500M11
500M12
500M13
500M14
500M15
601M1
603 (2009)
1900M1
1900M2
2000M1
2000M2

POR P.P.
99-08-107

SEE MAP 26S 34E

26 PARTITION
PLAT
08-12-235

SEE MAP
26S 33E 36

SEE MAP 27S 33E

PRINTED ON
May 27, 2009
26S 33E
& INDEX