


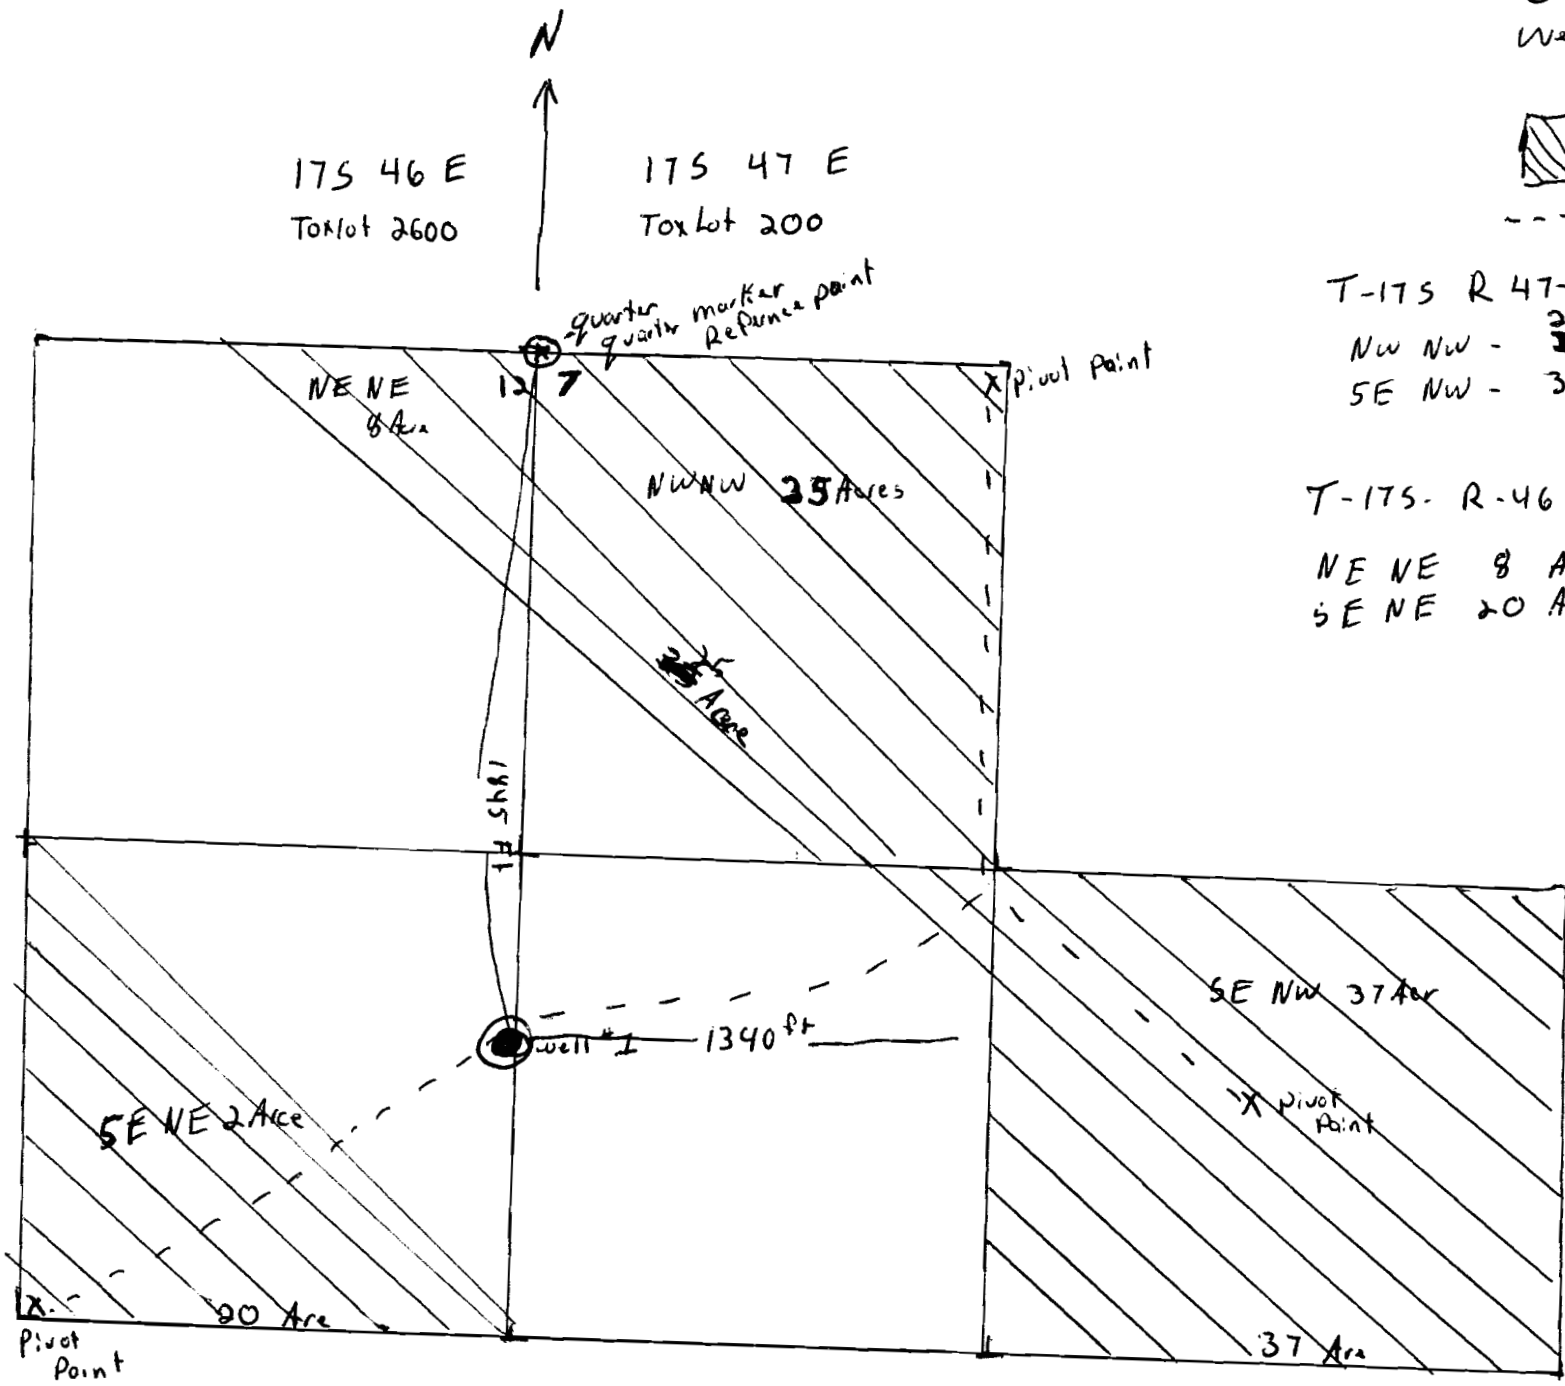
- ⊙ well
- ⊕ quarter quarter marker
- Well 1845 ft South of Reference point
-  Acres Irrigated
- Delivery pipe

17S 46 E
Tolot 2600

17S 47 E
Tolot 200

T-17S R 47-E Tolot 200
 NW NW - ~~35~~ 35 Acre
 SE NW - 37 Acre


T-17S R-46 E tololot 2000
 NE NE 8 Acre
 SE NE 20 Acre



RECEIVED

DEC 08 2011

WATER RESOURCES DEPT
SALEM, OREGON

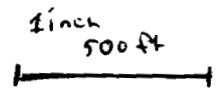


TOTAL 90 ACRES

WORK COPY

25
37
20
<hr/>
90 Acres


① well
 ② quarter quarter marker
 Well 1845' South of
 Reference point

 Acres Irrigated
 - - - - - Delivery pipe

T-175 R-47-E Taxlot 200
 NW NW - ~~25~~ 35 Acre Section 7
 SE NW - 37 Acre

T-175 R-46 E taxlot 2000
 SECTION 12
 NE NE 8 Acre
 SE NE 20 Acre

WELL LOCATED FROM NE CORNER
 SECTION 12
 1845 FEET SOUTH

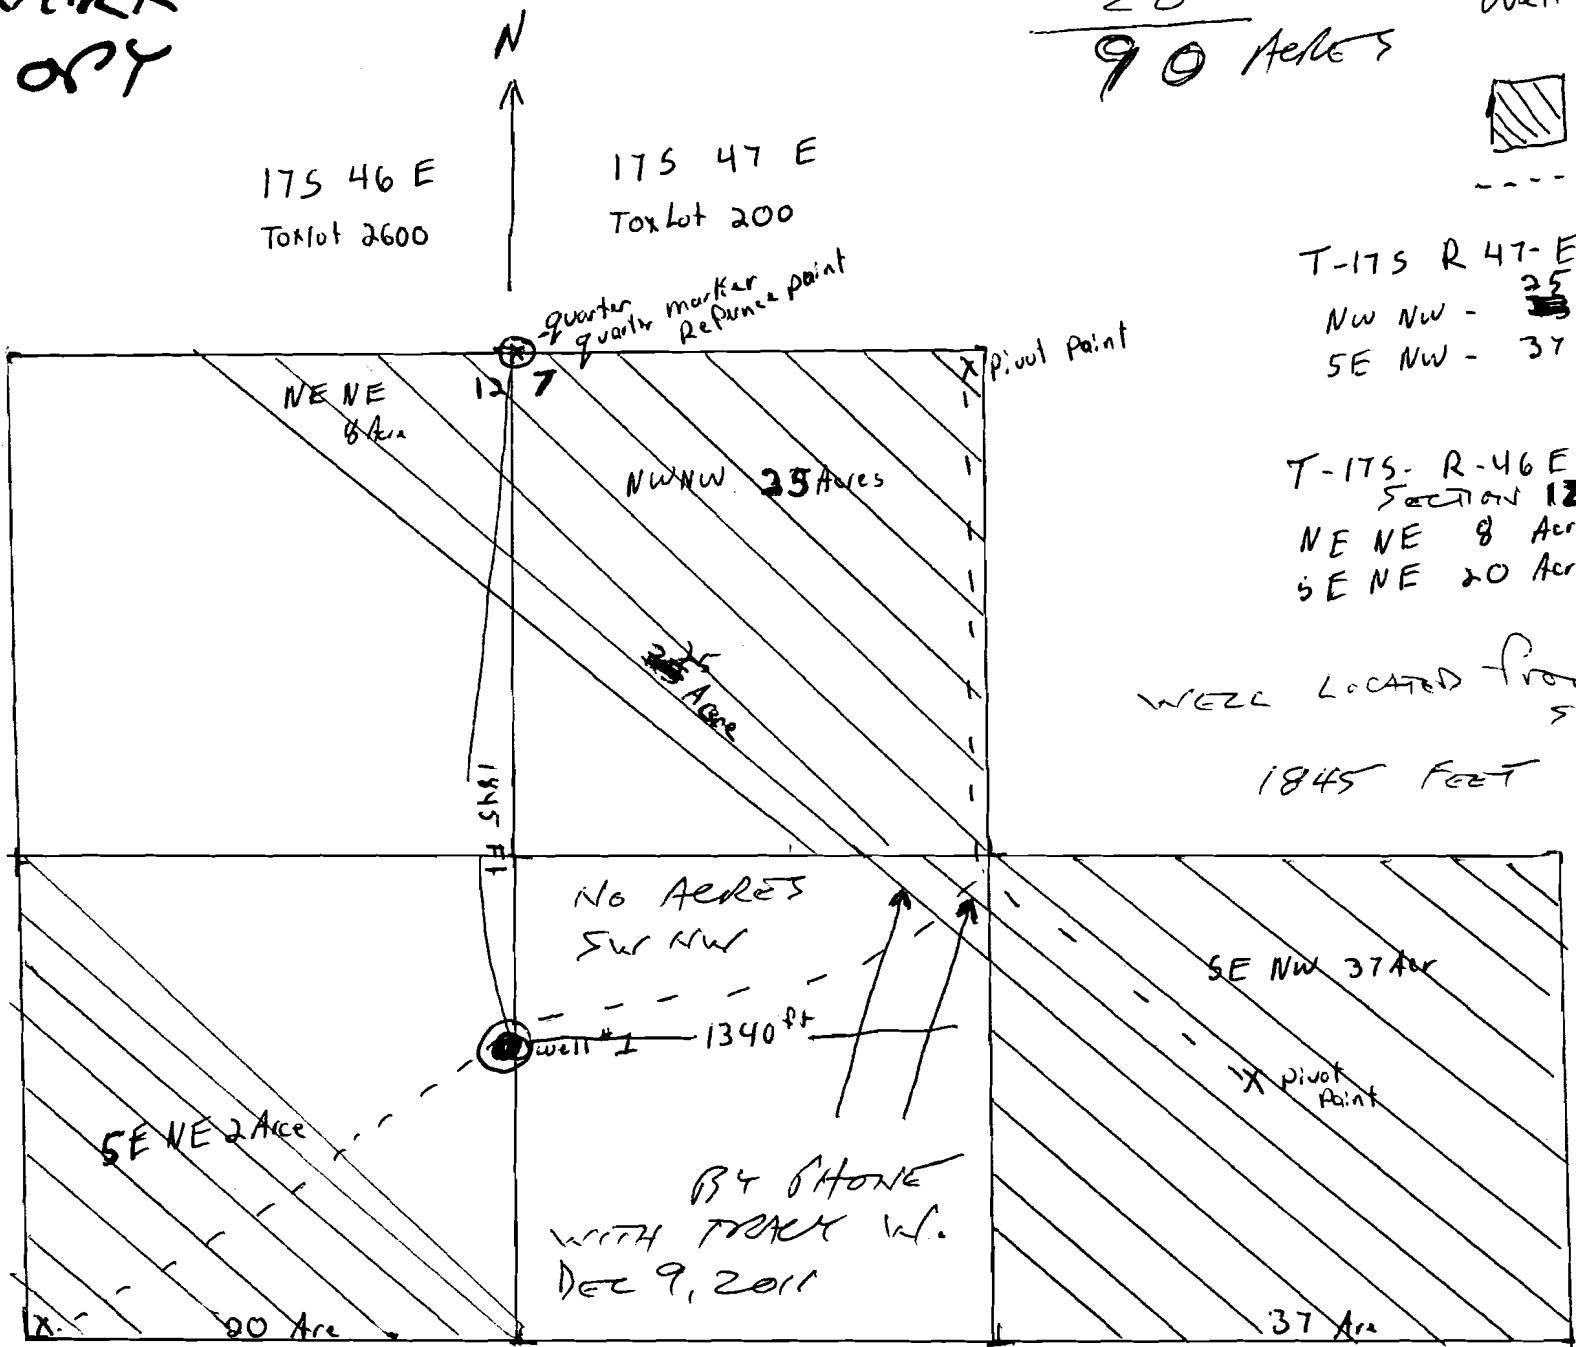

BY PHONE
 WITH TRACK W.
 DEC 9, 2011

DISREGARD SMALL
 LINES IN CORNER

RECEIVED
 DEC 08 2011
 WATER RESOURCES DEPT
 SALEM, OREGON

