SECTION

1 inch = 1320

North

TOWNSHIP 1 North, RANGE 5 East, W. M.

Tax Lot 600 and 100

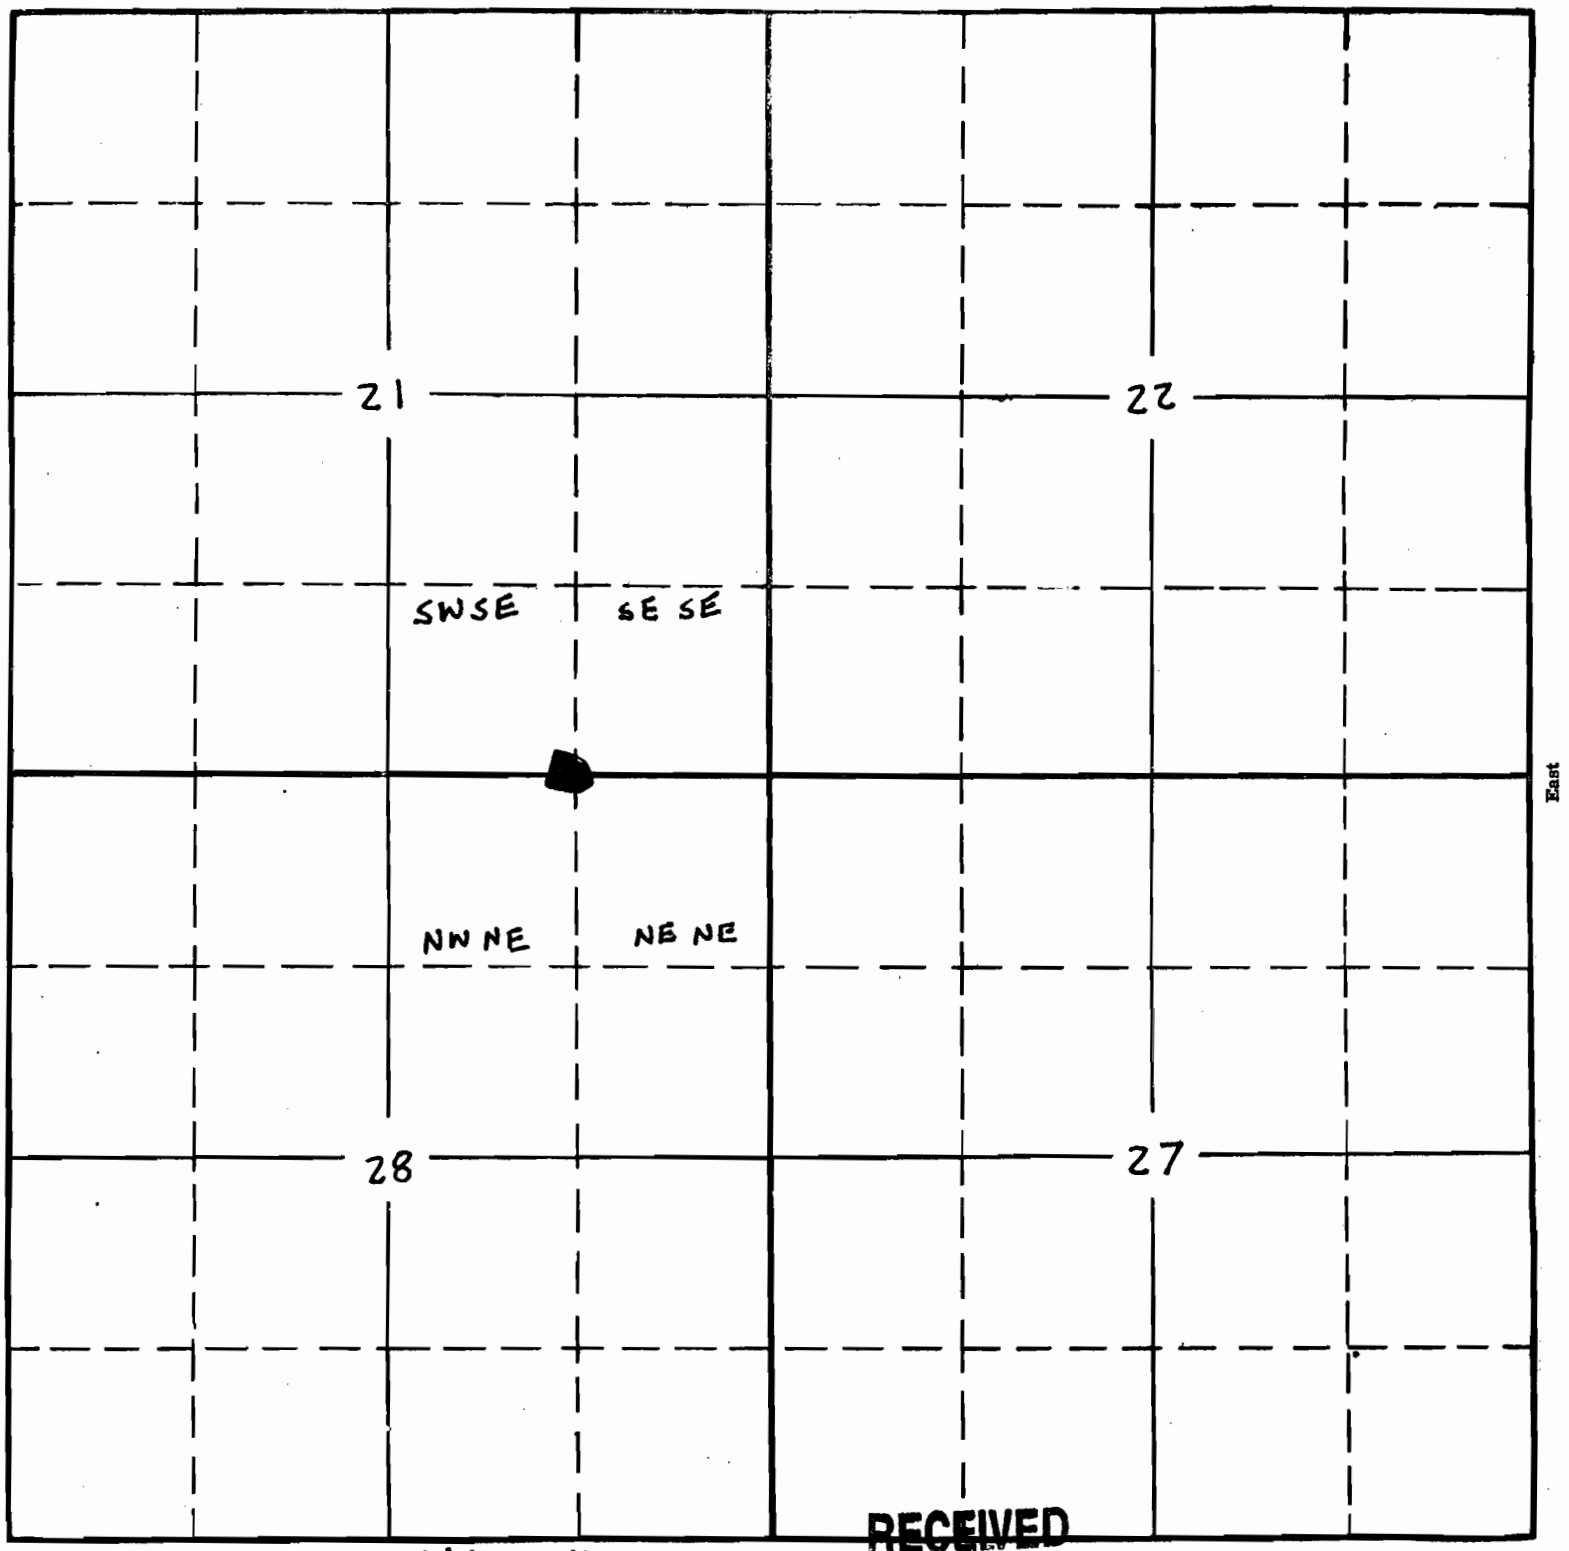

MAP OK

Dam Loc
70' North
1445' West
from SE corner
Section 21

Scott D Wellman
11/29/2011

R-87773

RECEIVED
DEC 15 2011
WATER RESOURCES DEPT
SALEM, OREGON

APPLICATION No.
PERMIT No.

MAP OK
11-23-2011