0649

CLAIM OF BENEFICIAL USE MAP
FOR
KAWONU ACRES, LLC.
LOCATED IN
NW 1/4 SEC. 14, T. 16 S., R. 5 W., W.M.
IN THE
LANE COUNTY, OREGON

DECEMBER 16, 2011

PERMIT No. G-16444
APPLICATION No. G-16996

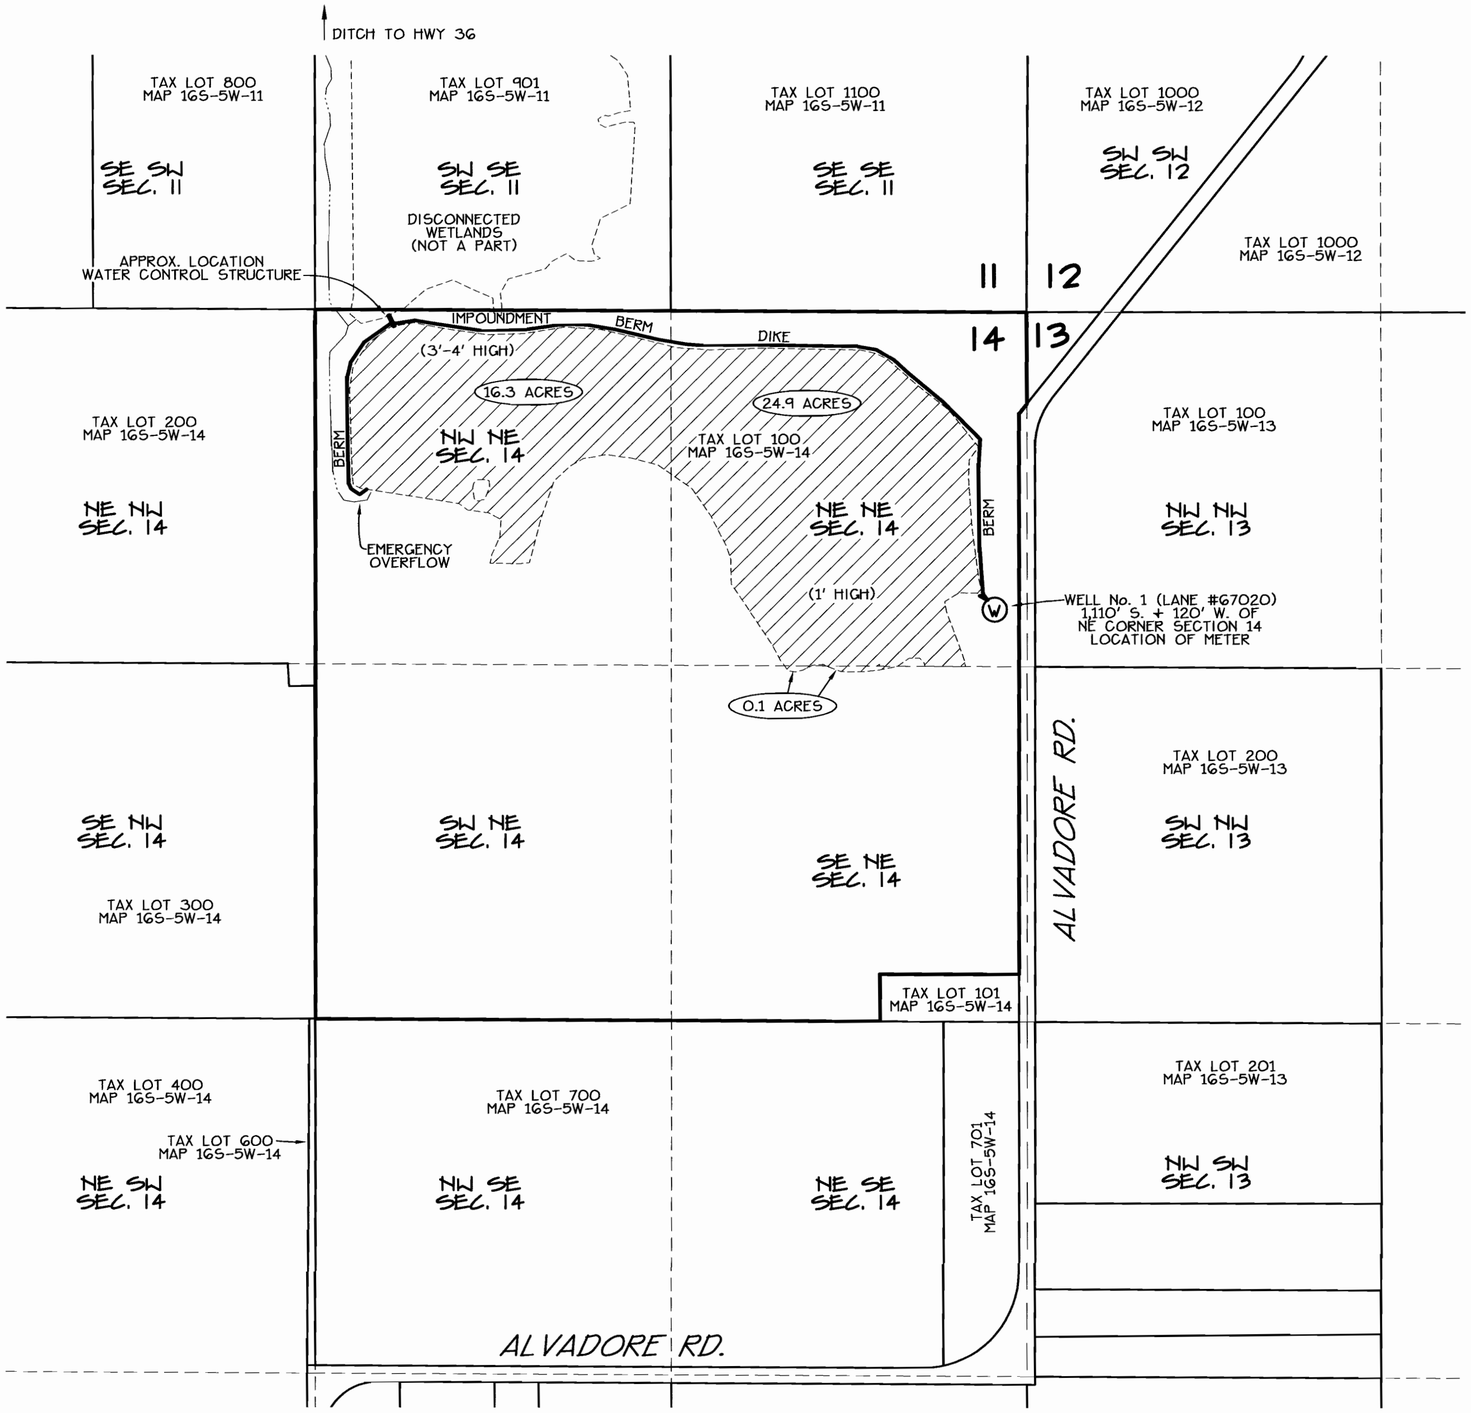

N
W E
S

0 200 400 800 FT.
SCALE: 1" = 400'

PERMITTEE/OWNER:
KAWONU ACRES, LLC.
34033 MOUNT TOM DR.
HARRISBURG, OR 97446
AGENT: DALE BERGEY

SITE ADDRESS:
NONE ASSIGNED

TAX LOT:
TAX LOT 100
MAP 16S-5W-14

PRIORITY DATE:
JANUARY 18, 2008

LEGEND:
(W) WELL No. 1 (LANE #67020) 1,110' S. + 120' W. OF NE COR. SEC. 14
WETLAND ENHANCEMENT AREA UNDER IRRIGATION 41.3 ACRES

Certified Water Right Examiner #203
Jack R. Burrell
Jack R. Burrell
May 30, 1989
STATE OF OREGON

RENEWAL DATE 12/31/11

COBU MAP # 0649

DISCLAIMER:
THIS MAP IS NOT INTENDED TO PROVIDE LEGAL DIMENSIONS OR LOCATIONS OF PROPERTY OWNERSHIP LINES

K&D
K & D ENGINEERING, Inc.
276 N.W. Hickory Street P.O. Box 725
Albany, Oregon 97321
(541) 928-2583

Date: 12/16/2011 Time: 10:46
Scale: 1=400(PS)
File: dwg\2011\11-131\11-131cobu.dwg (Ian)

SHEET 1 OF 1