

RECEIVED

SEP 07 2011

WATER RESOURCES DEPT
SALEM, OREGONFINAL PROOF SURVEY MAP
T30S, R36E, WM

SCALE 1" = 2000'

HARNEY COUNTY

FINAL PROOF SURVEY
UNDER

Application No. R-80954 Permit No. R-12693

IN NAME OF


John R. Atkinson, et al

Surveyed August 7, 2011 by M E Farr

MAP PREPARED FOR:

NORTHWEST FARM CREDIT SERVICES, FLCA
JOHN R. ATKINSON & DONNA M. ATKINSON
RONALD D. ATKINSON & BONNIE A. ATKINSON
JOHN R. ATKINSON, Trustee of the
JOHN R. and DONNA M. ATKINSON TRUST
DONNA M. ATKINSON, Trustee of the
JOHN R. and DONNA M. ATKINSON TRUST
2823 NW KLINE STREET
ROSEBURG, OR 97471


THIS IS A LOCATION MAP FOR A FINAL PROOF
SURVEY. THIS MAP IS FOR THE PURPOSE OF
IDENTIFYING THE LOCATION OF THE WATER RIGHT
ONLY AND IS NOT INTENDED TO PROVIDE LEGAL
DIMENSIONS OR LOCATIONS OF PROPERTY
OWNERSHIP LINES.

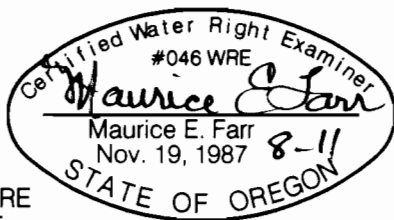

MAP PREPARED BY:
MAURICE E FARR, CWRE
395 NE KIRBY AVENUE
ROSEBURG, OR 97470

EXPIRES 12-31-11

POD 1 is 540 ft S and 3520 ft E from NW COR SEC 9
in Township 30 South, Range 36 East, W.M.

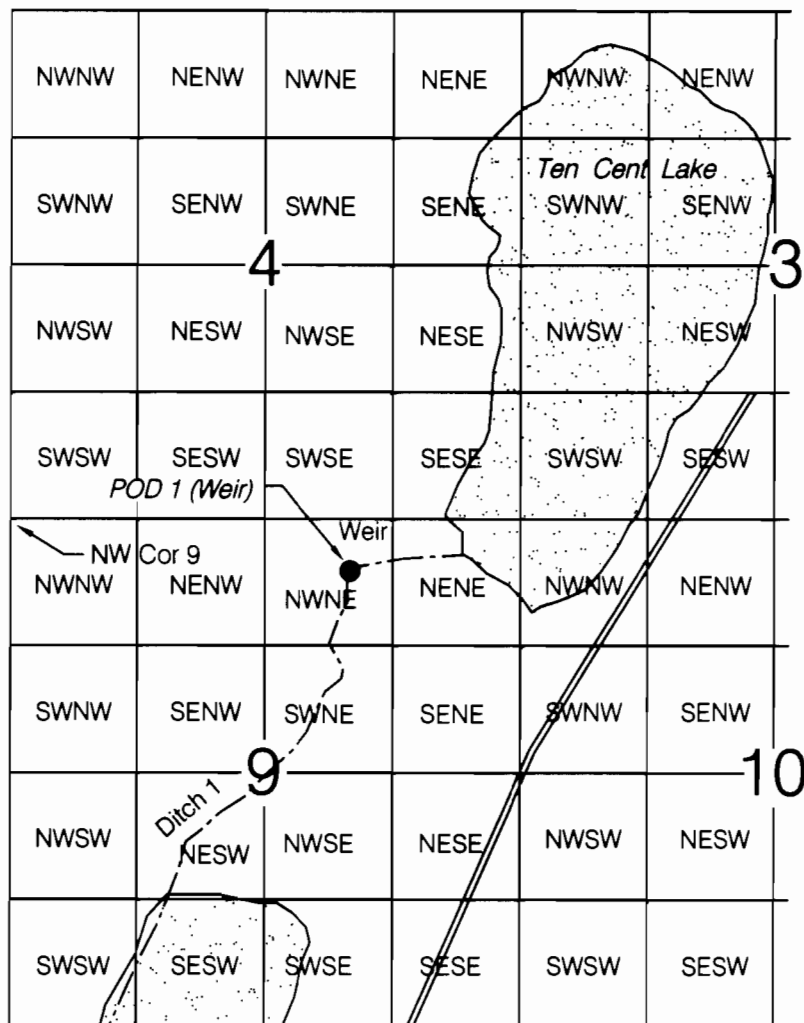**LEGEND**

- Existing natural lake
- POD #n
- Stream
- Open supply ditch
- Applicant Property Line

