


RECEIVED

JAN 23 2012

WATER RESOURCES DEPT  
SALEM, OREGON

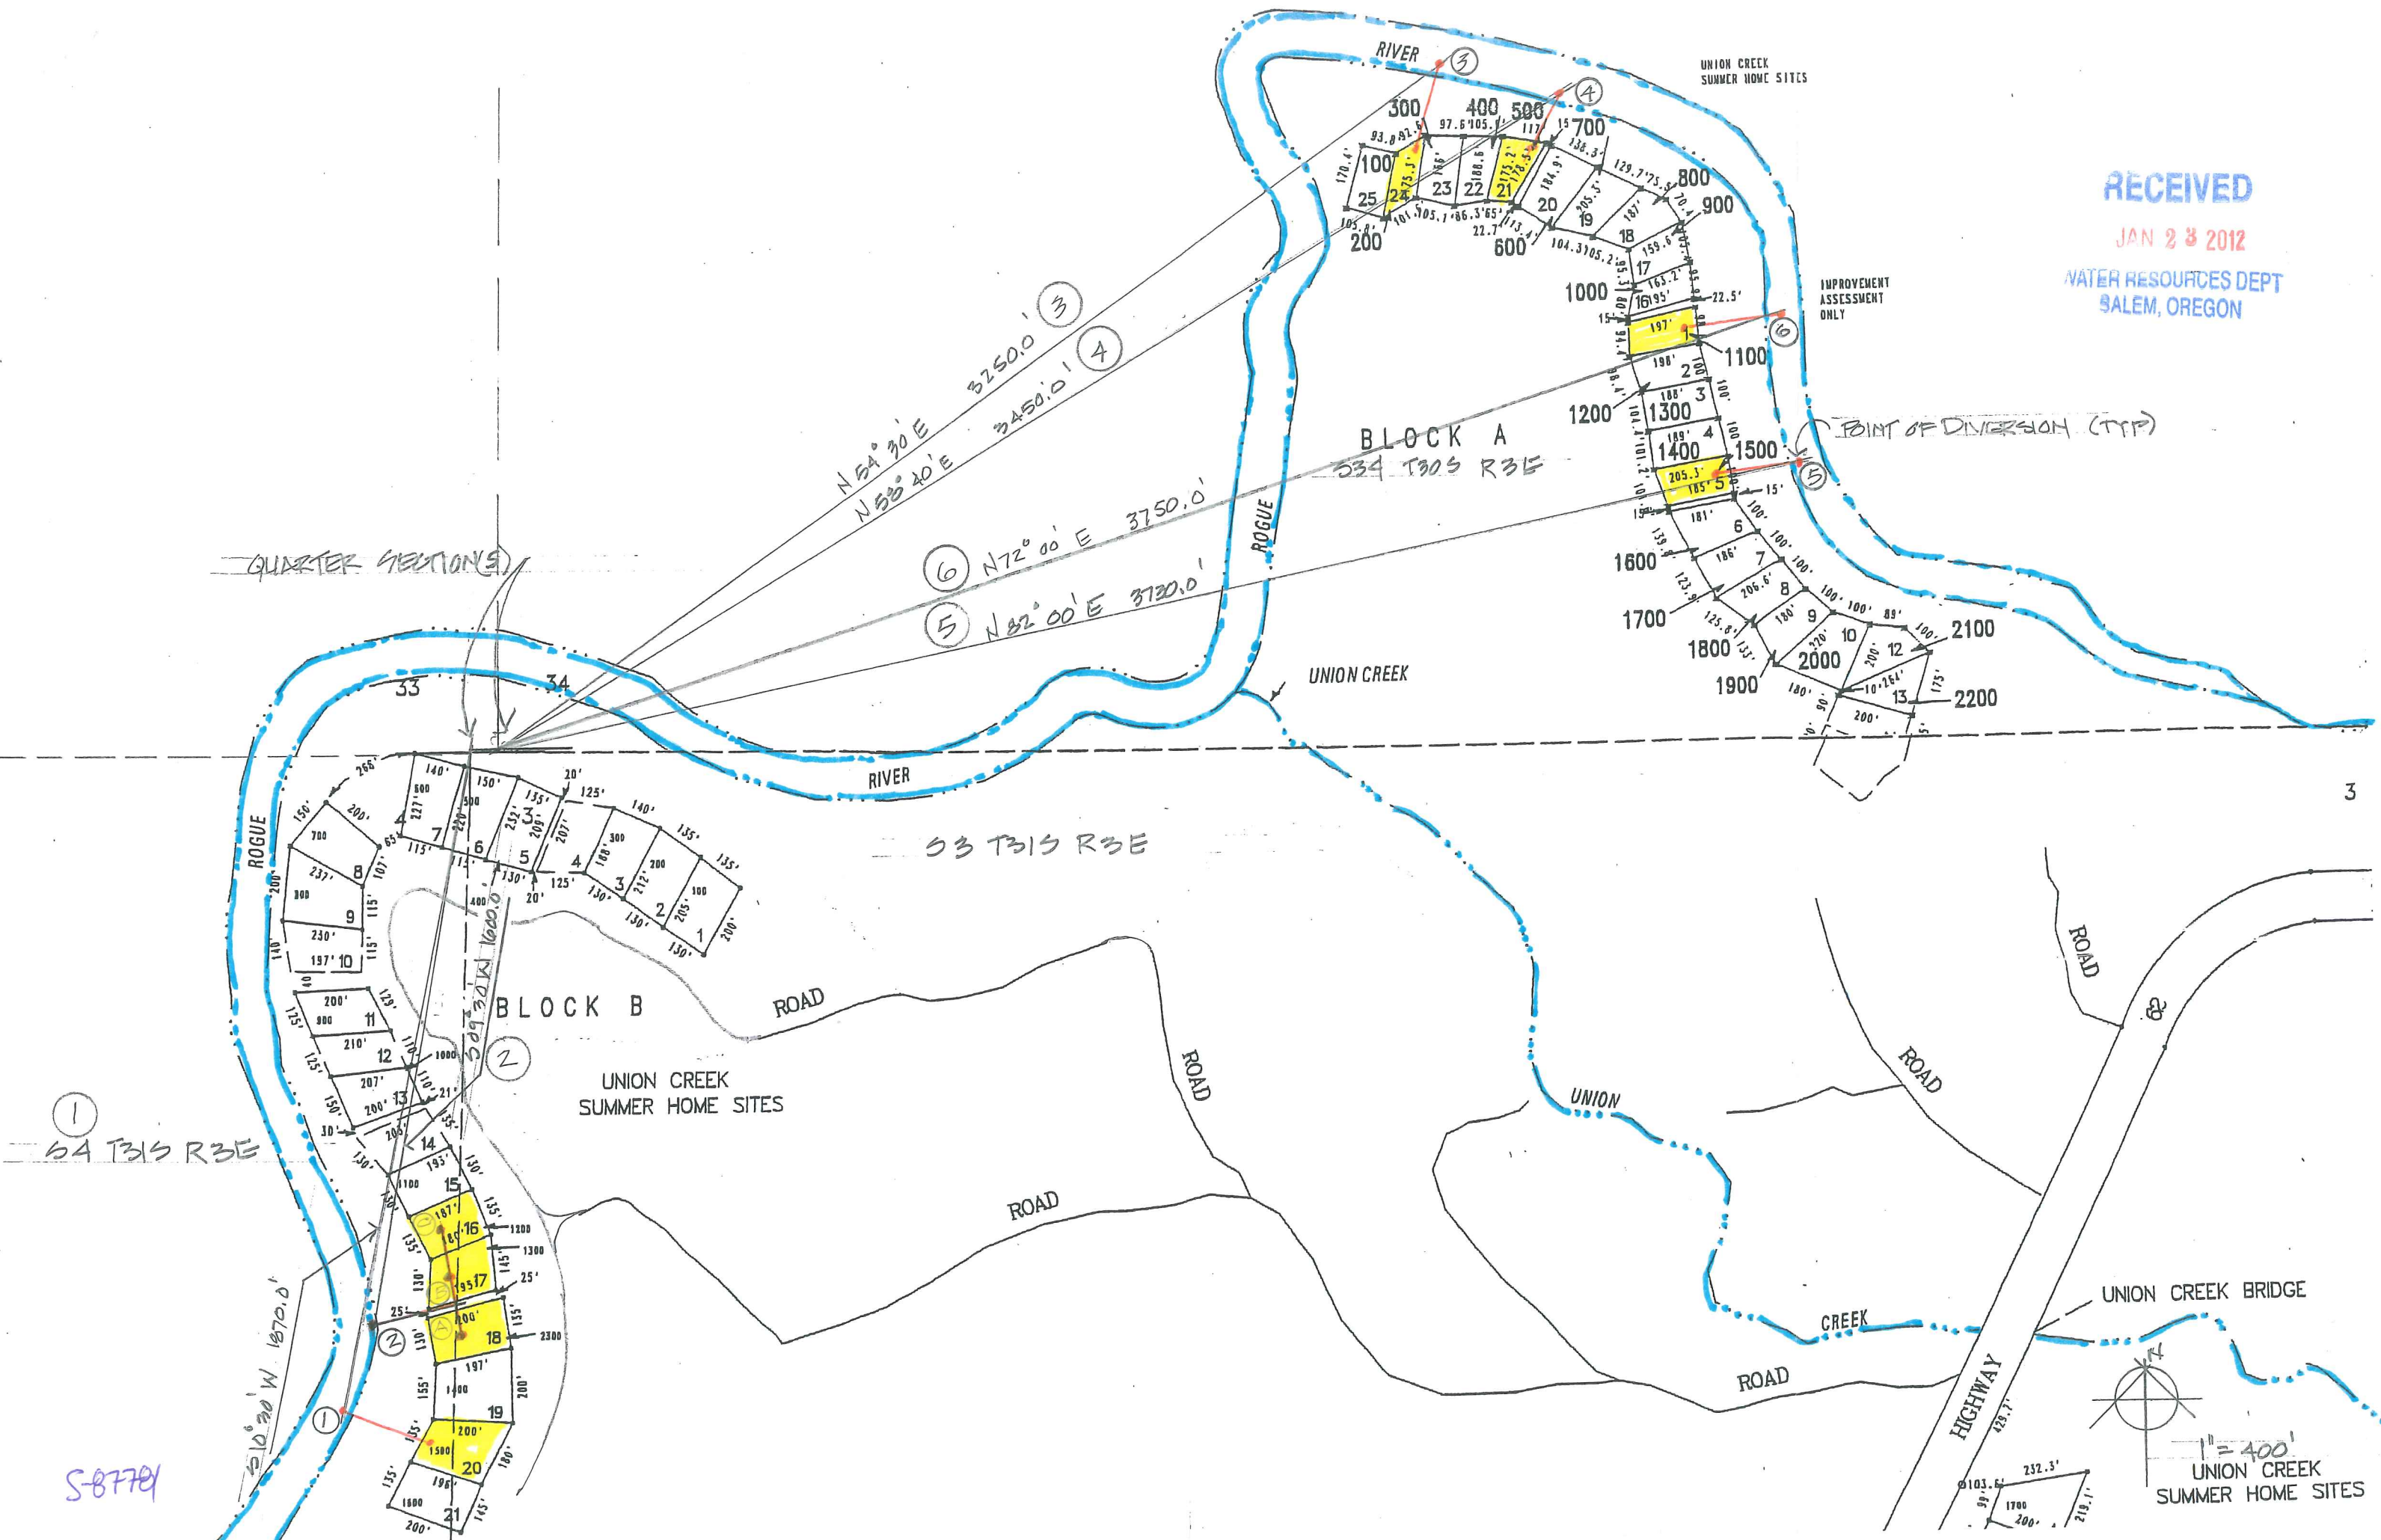

S-87701

1" = 400'  
UNION CREEK  
SUMMER HOME SITES