


T. 31 S. R. 8 E. W. M.


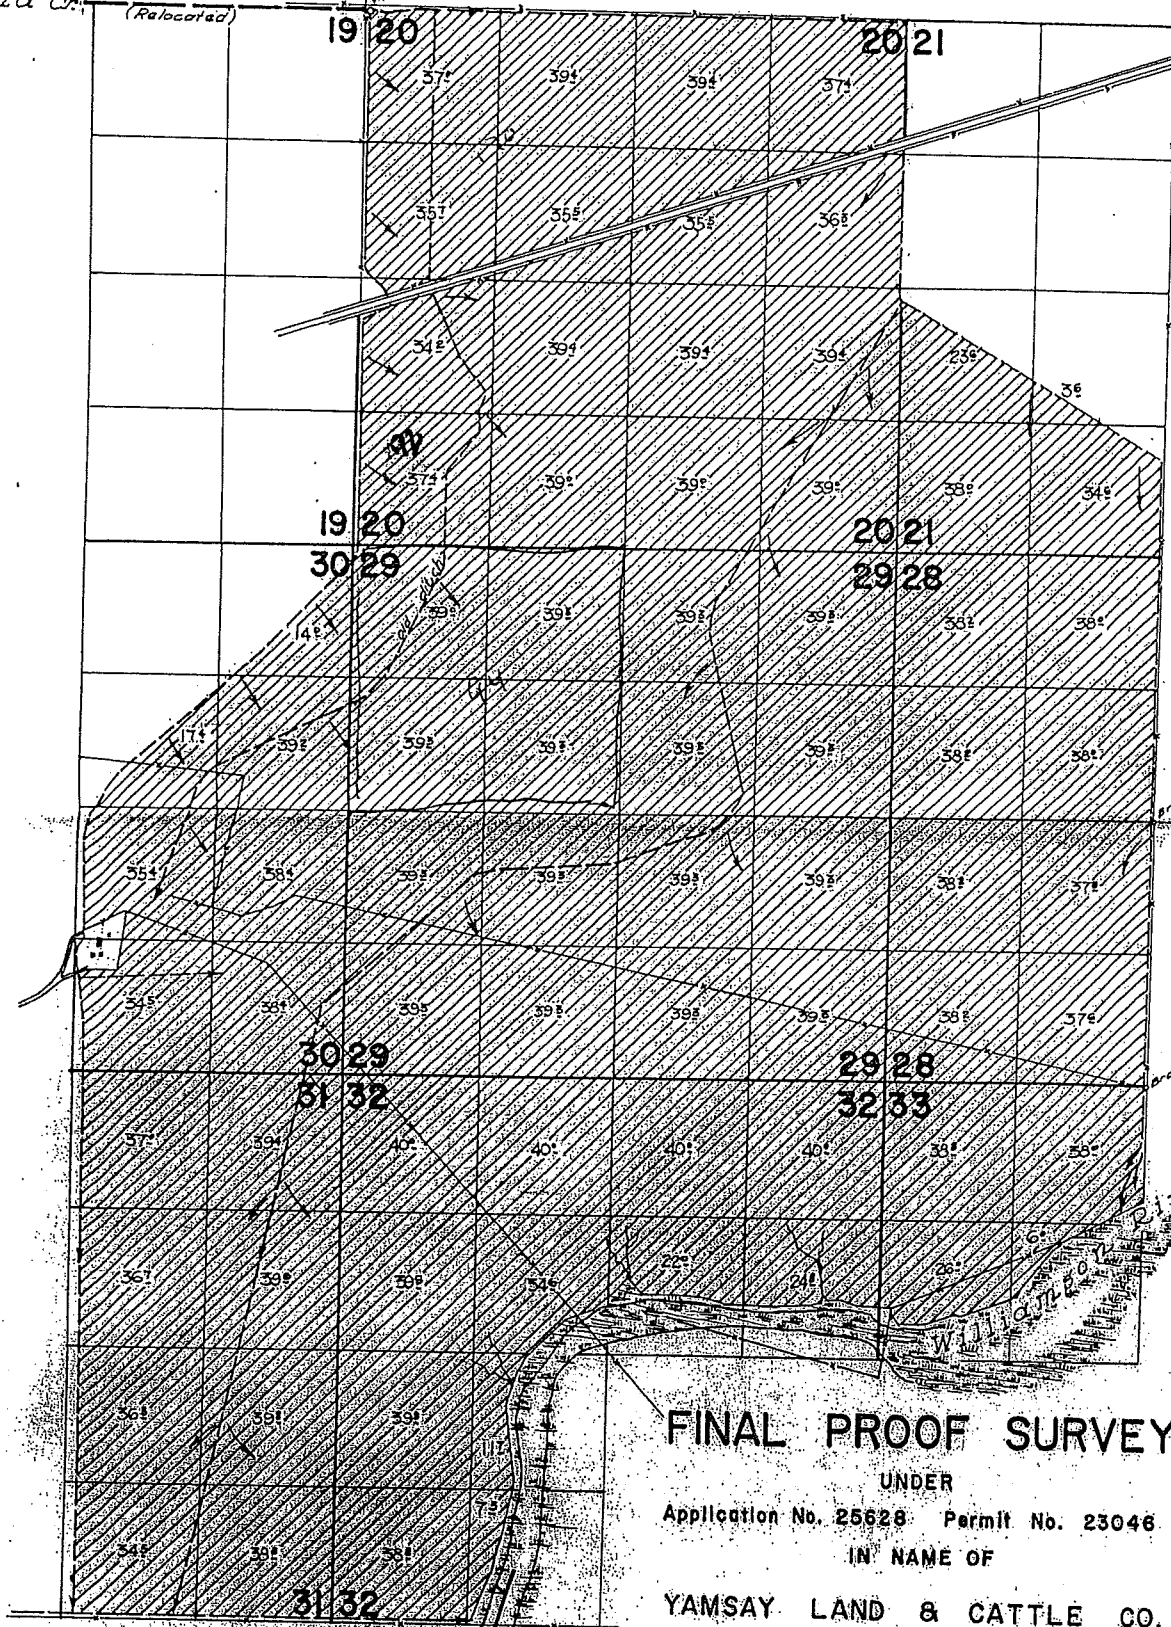

FINAL PROOF SURVEY

UNDER

Application No. 25628 Permit No. 23046

IN NAME OF

YAMSAY LAND & CATTLE CO.

Surveyed August 17-18, 1962 by *[Signature]*

CLAIM # 18 PAGE # 0025
 KLAMATH ADJUDICATION

1962-W