


SECTION 36 T.20S. R.46E. W.M.
MALHEUR COUNTY

Approximate Scale 1" = 660'

Well is located
2,742' south & 100' east
From NW corner of SEC. 36

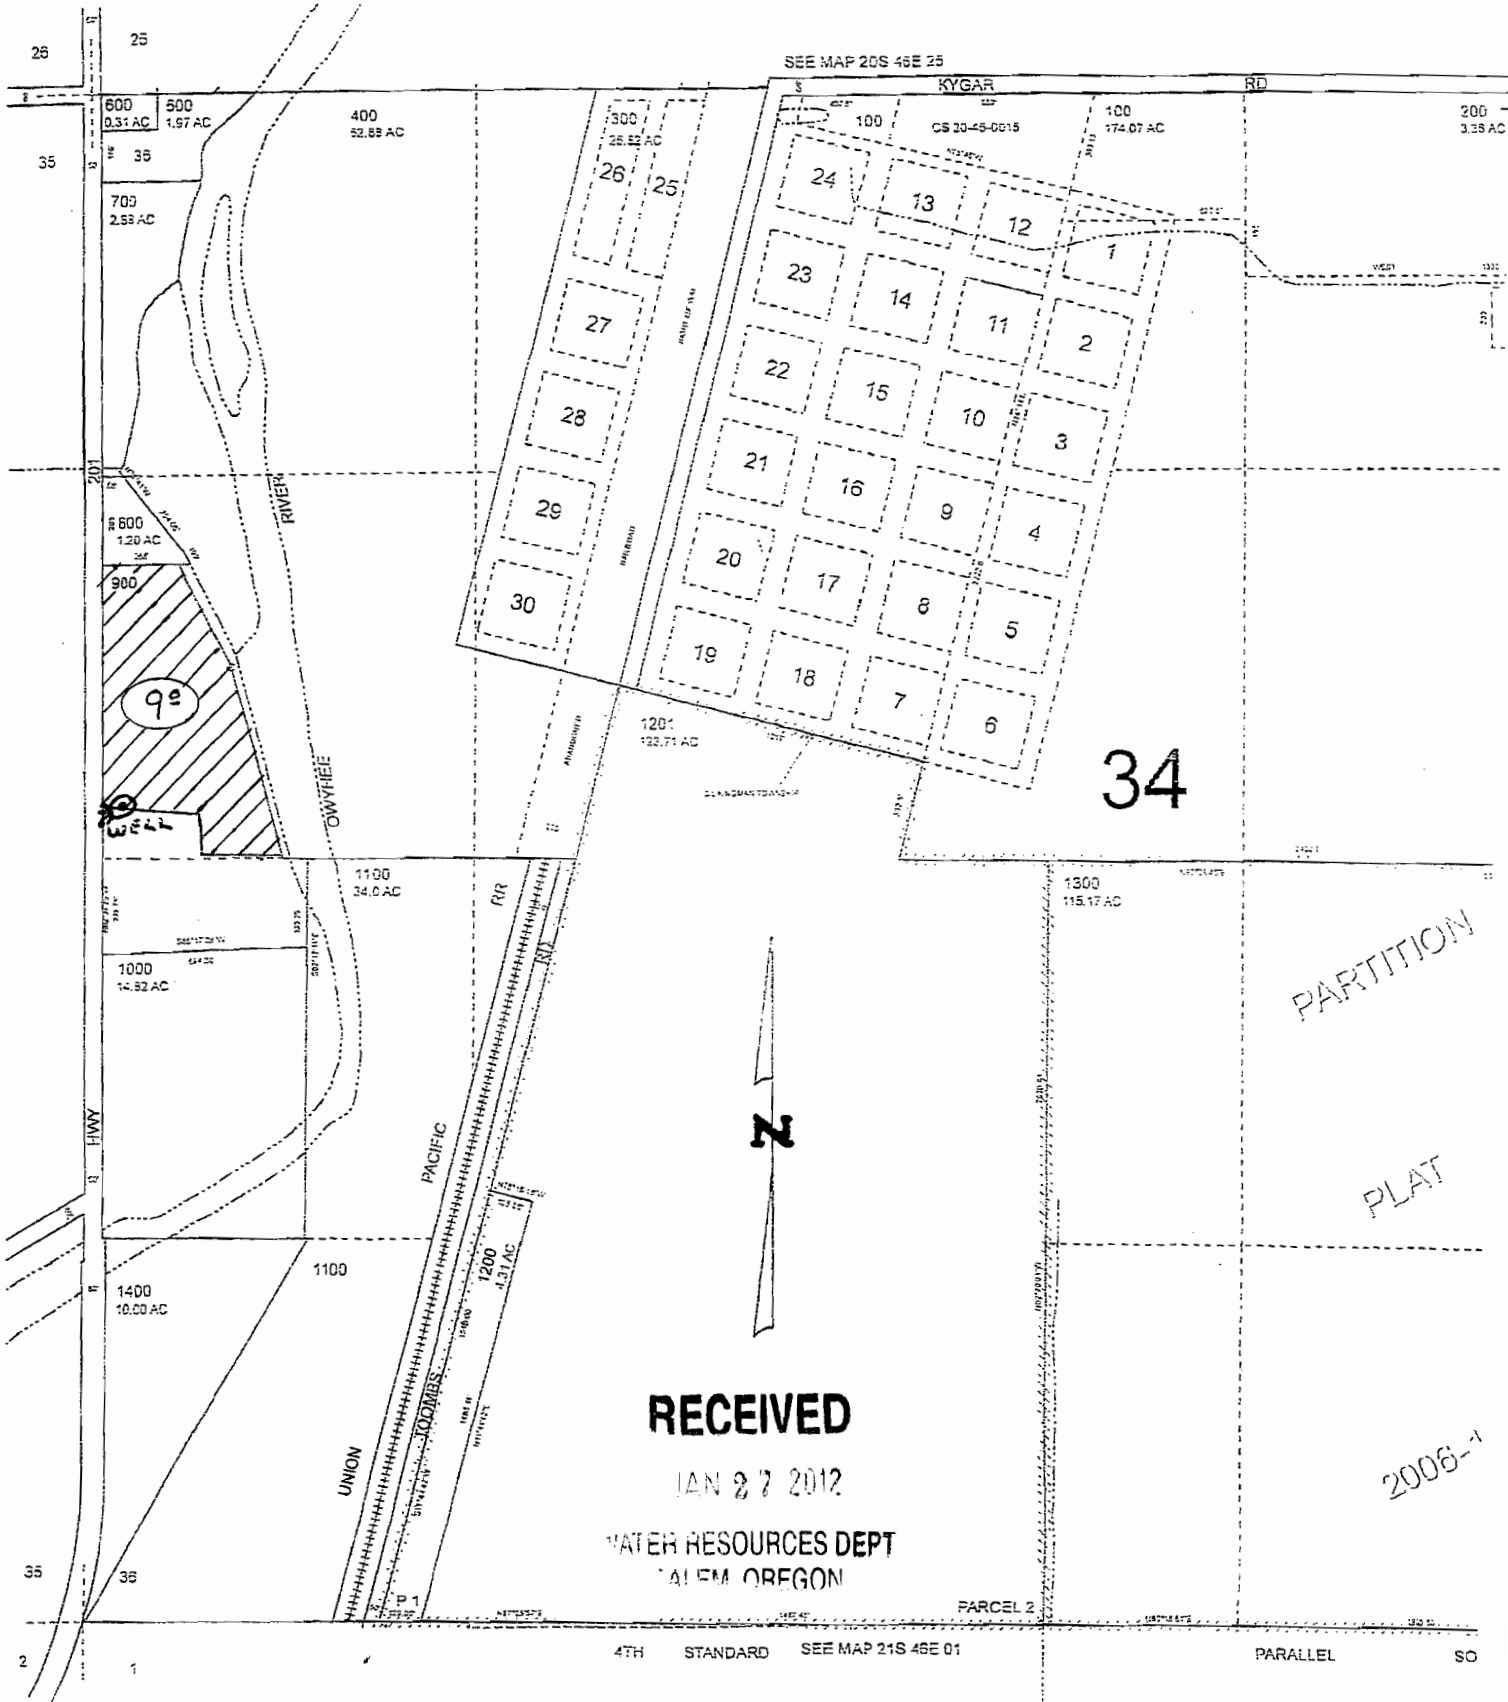

G-17529