



CLAIM OF BENEFICIAL USE MAP
FOR
MARTIN + TAMARIA SUING
IN THE
NW 1/4, NE 1/4, AND SE 1/4
OF SEC 11, T. 12 S., R. 1 W., W.M.
LINN COUNTY, OREGON

JANUARY 20, 2012

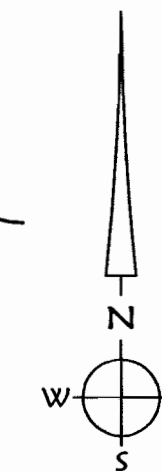

0 200 400 800 FT.
SCALE: 1" = 400'

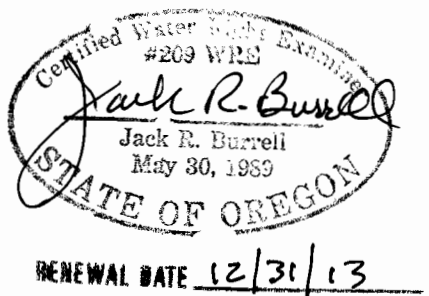

PERMIT TO STORE THE PUBLIC WATERS
APPLICATION R-79645
PERMIT R-12191

PERMIT TO APPROPRIATE THE PUBLIC WATERS
APPLICATION S-79646
PERMIT 53196

OWNER/PERMITTEE:
MARTIN J. AND TAMARIA SUING
32861 MOUNT PLEASANT RD.
LEBANON, OREGON 97355

TAX LOTS:
T.L. 200, 300, 400, 500, 501, 800,
1000, 1001 (12-1W-11)

TIES FROM N.E. CORNER OF SECTION 11


	SOUTH	WEST
POND No. 1	1263'	2609'
POND No. 2	2308'	2285'
POND No. 3	2535'	3255'

LEGEND:


- DITCH/CREEK
- EXISTING STRUCTURE

DISCLAIMER:


THIS MAP IS NOT INTENDED TO PROVIDE LEGAL
DIMENSIONS OR LOCATIONS OF PROPERTY
OWNERSHIP LINES.

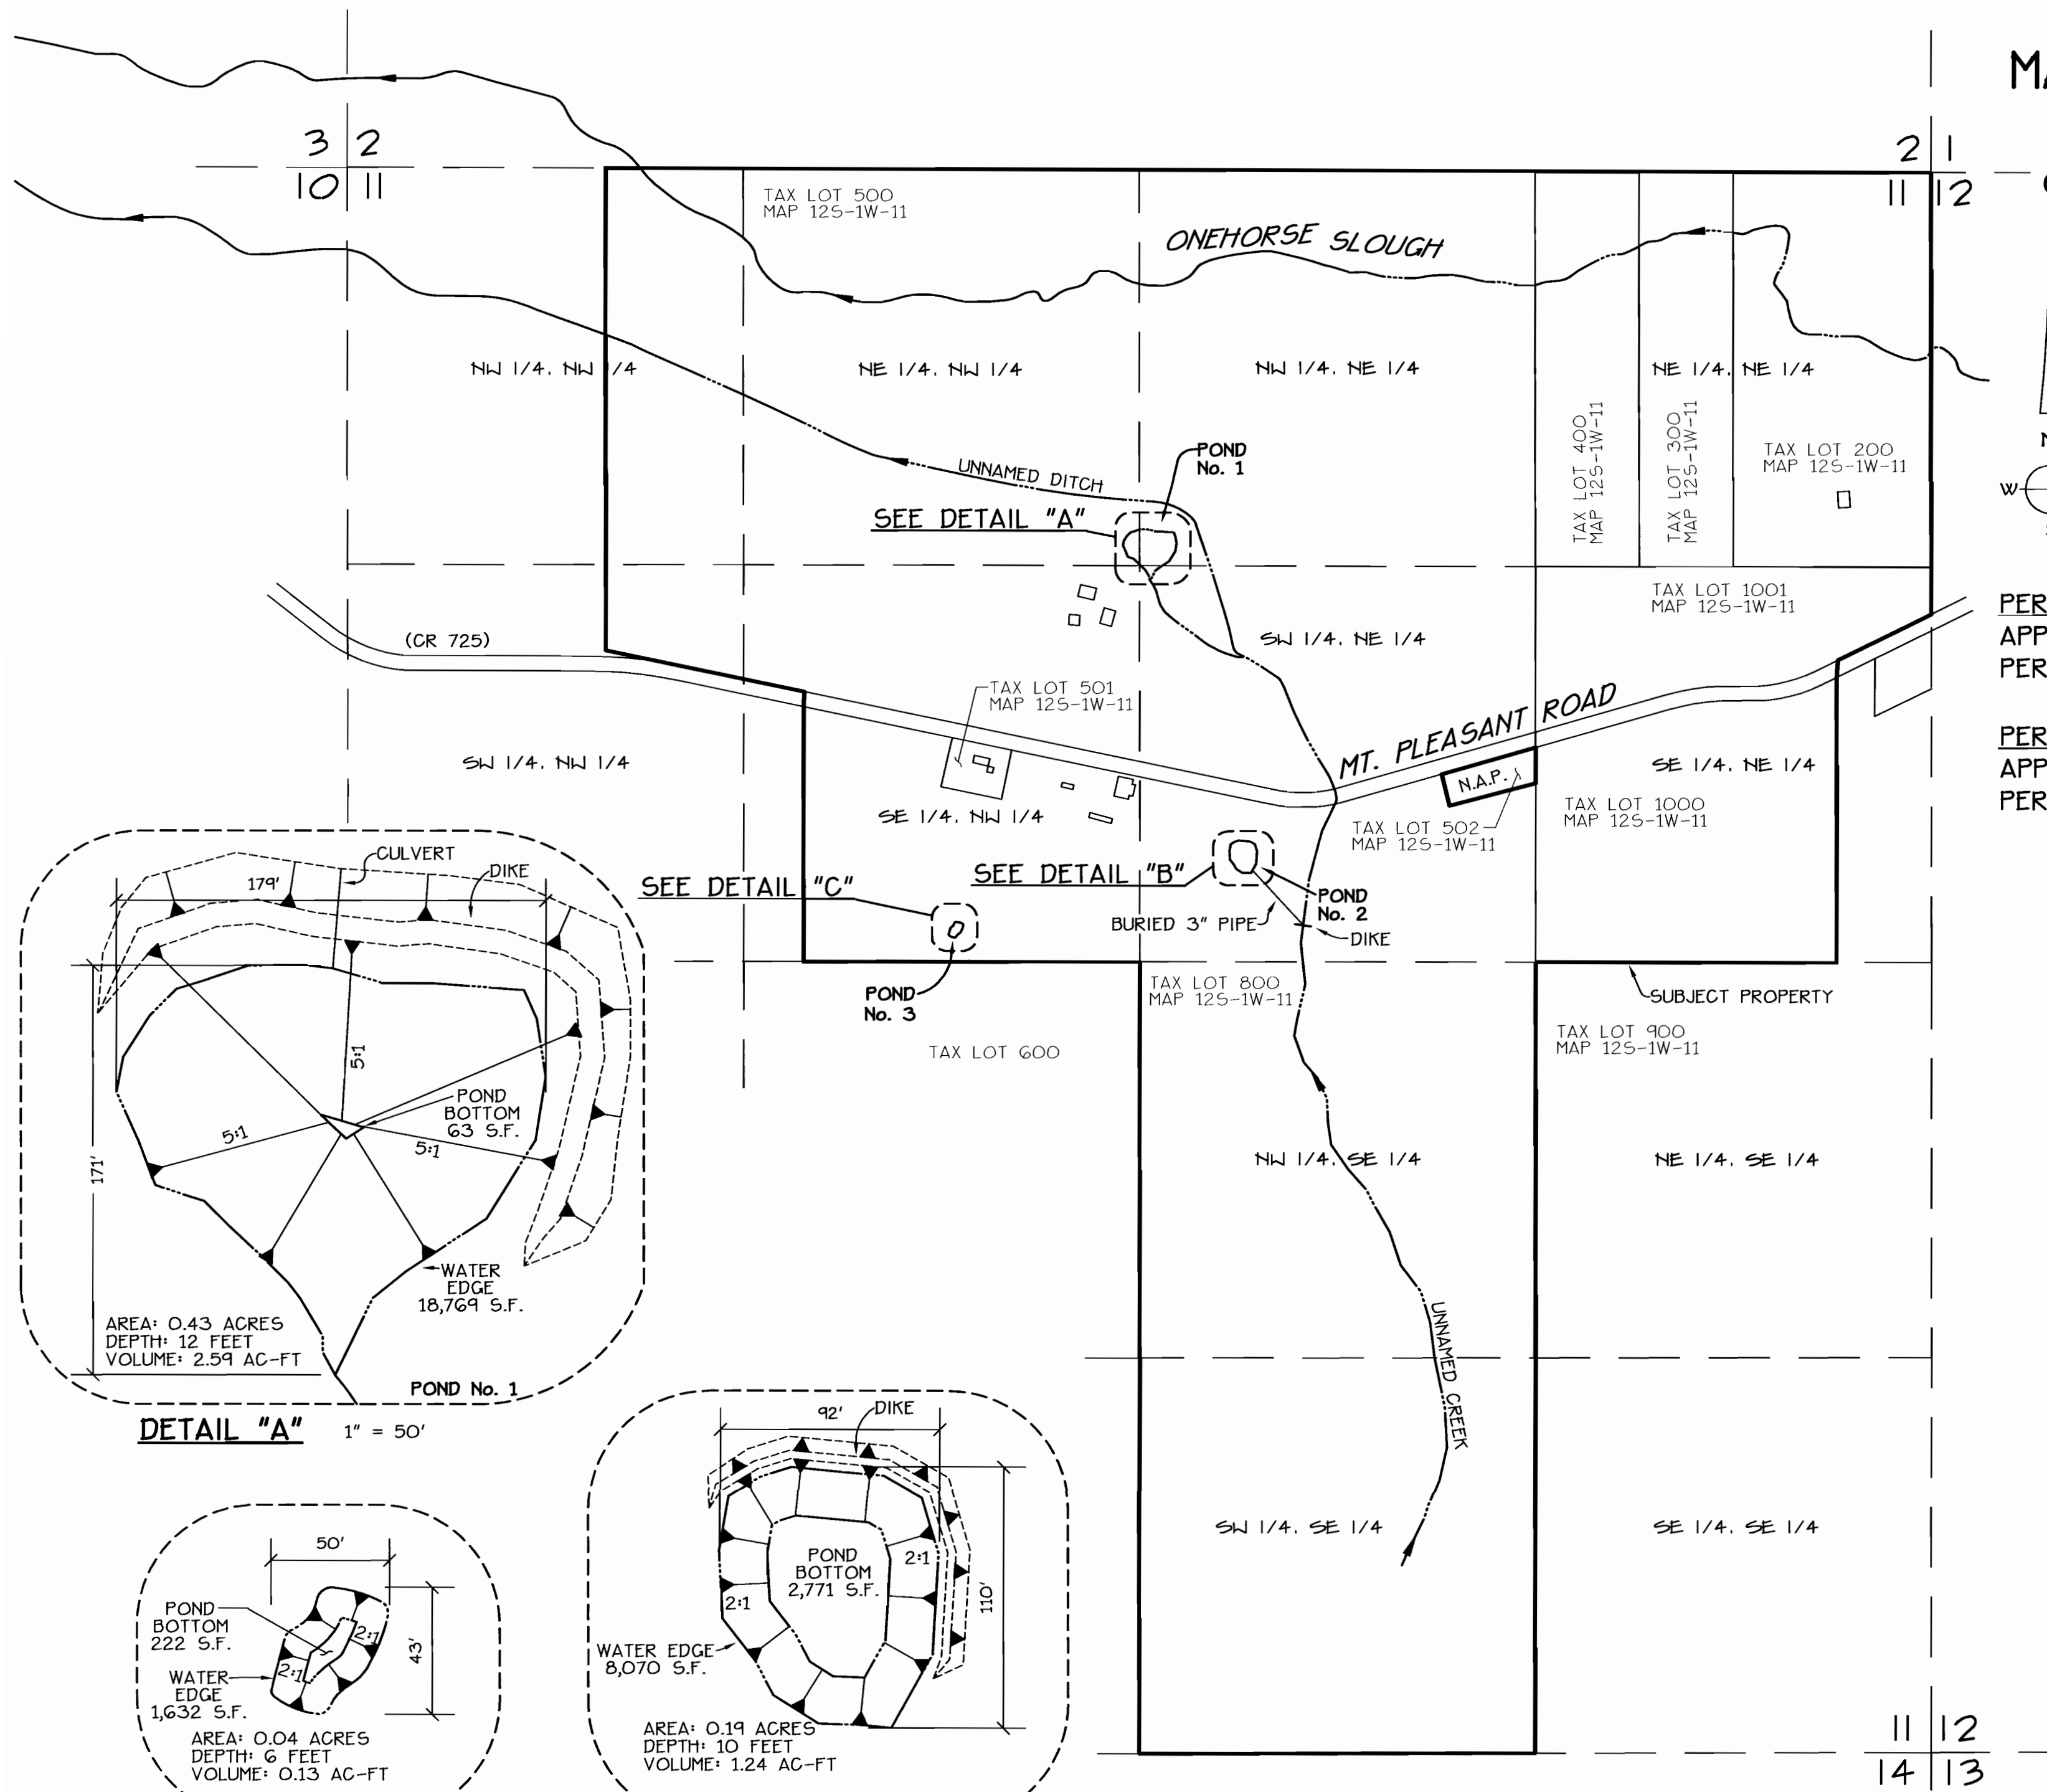


DETAIL "A" 1" = 50'

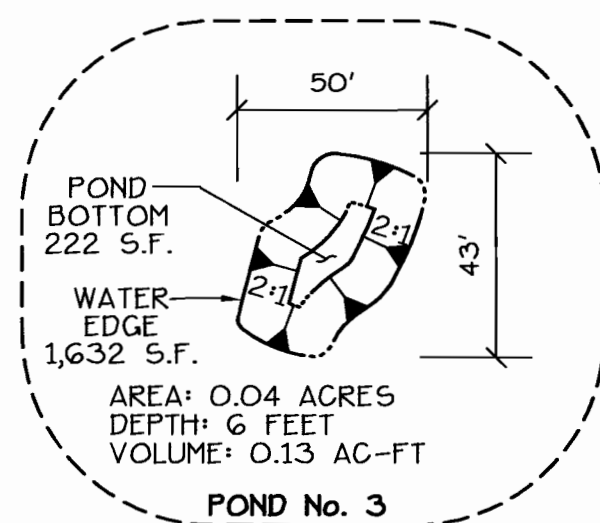

DETAIL "C" 1" = 50'

 

DETAIL "B" 1" = 50'

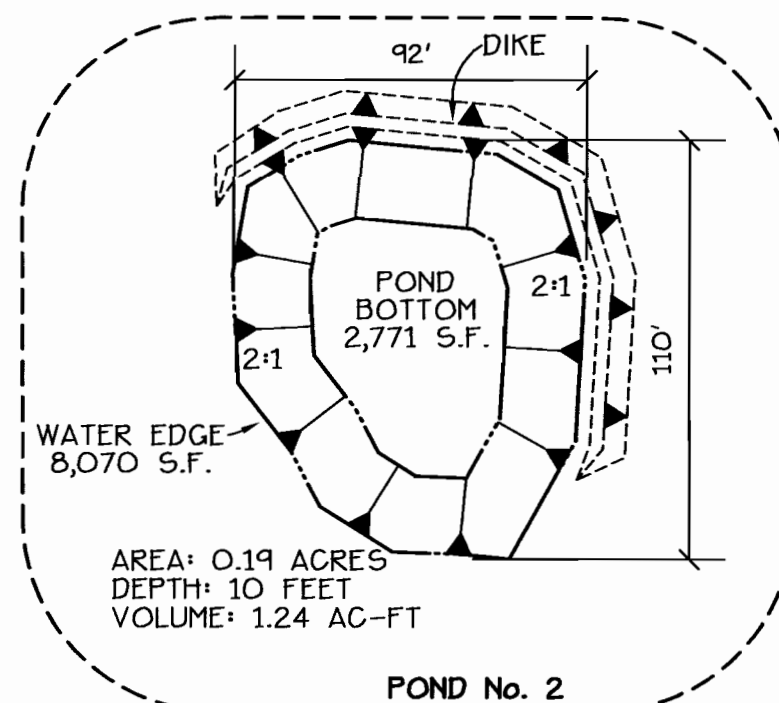

K & D

K & D ENGINEERING, Inc.
276 N.W. Hickory Street P.O. Box 725
Albany, Oregon 97321
(541) 928-2583

Date: 1/20/2012 Time: 16:19
Scale: 1=400
File: dwg\1994\94-191\94191-cobu.DWG (lan)

COBU MAP # 0653