
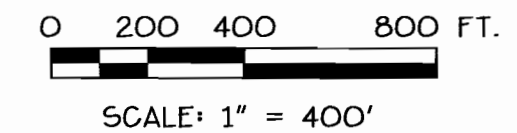


IN THE
NW 1/4, NE 1/4, AND SE 1/4
OF SEC 11, T. 12 S., R. 1 W., W.M.
LINN COUNTY, OREGON

Certified Water Right Examination
#209 WRS
Jack R. Burrell
Jack R. Burrell
May 30, 1989
STATE OF OREGON
RENEWAL DATE 12/31/13

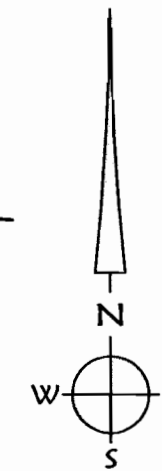

PERMIT TO APPROPRIATE THE PUBLIC WATERS
APPLICATION 5-79646
PERMIT 53196

MARTIN J. AND TAMARIA SUING
32861 MOUNT PLEASANT RD.
LEBANON, OREGON 97355

T.L. 200, 300, 400, 500, 501, 800,
1000, 1001 (12-1W-11)

	<u>SOUTH</u>	<u>WEST</u>
POND No. 1	1263'	2609'
POND No. 2	2308'	2285'
POND No. 3	2535'	3255'

 DITCH/CREEK

 EXISTING STRUCTURE

THIS MAP IS NOT INTENDED TO PROVIDE LEGAL
DIMENSIONS OR LOCATIONS OF PROPERTY
OWNERSHIP LINES.



K & D ENGINEERING, Inc.
276 N.W. Hickory Street P.O. Box 725
Albany, Oregon 97321
(541) 928-2583

Scale: 1=400

File: dwg\1994\94-191\94191-cobu.DWG (lan)

11	12
14	13

COBU MAP # 0653