


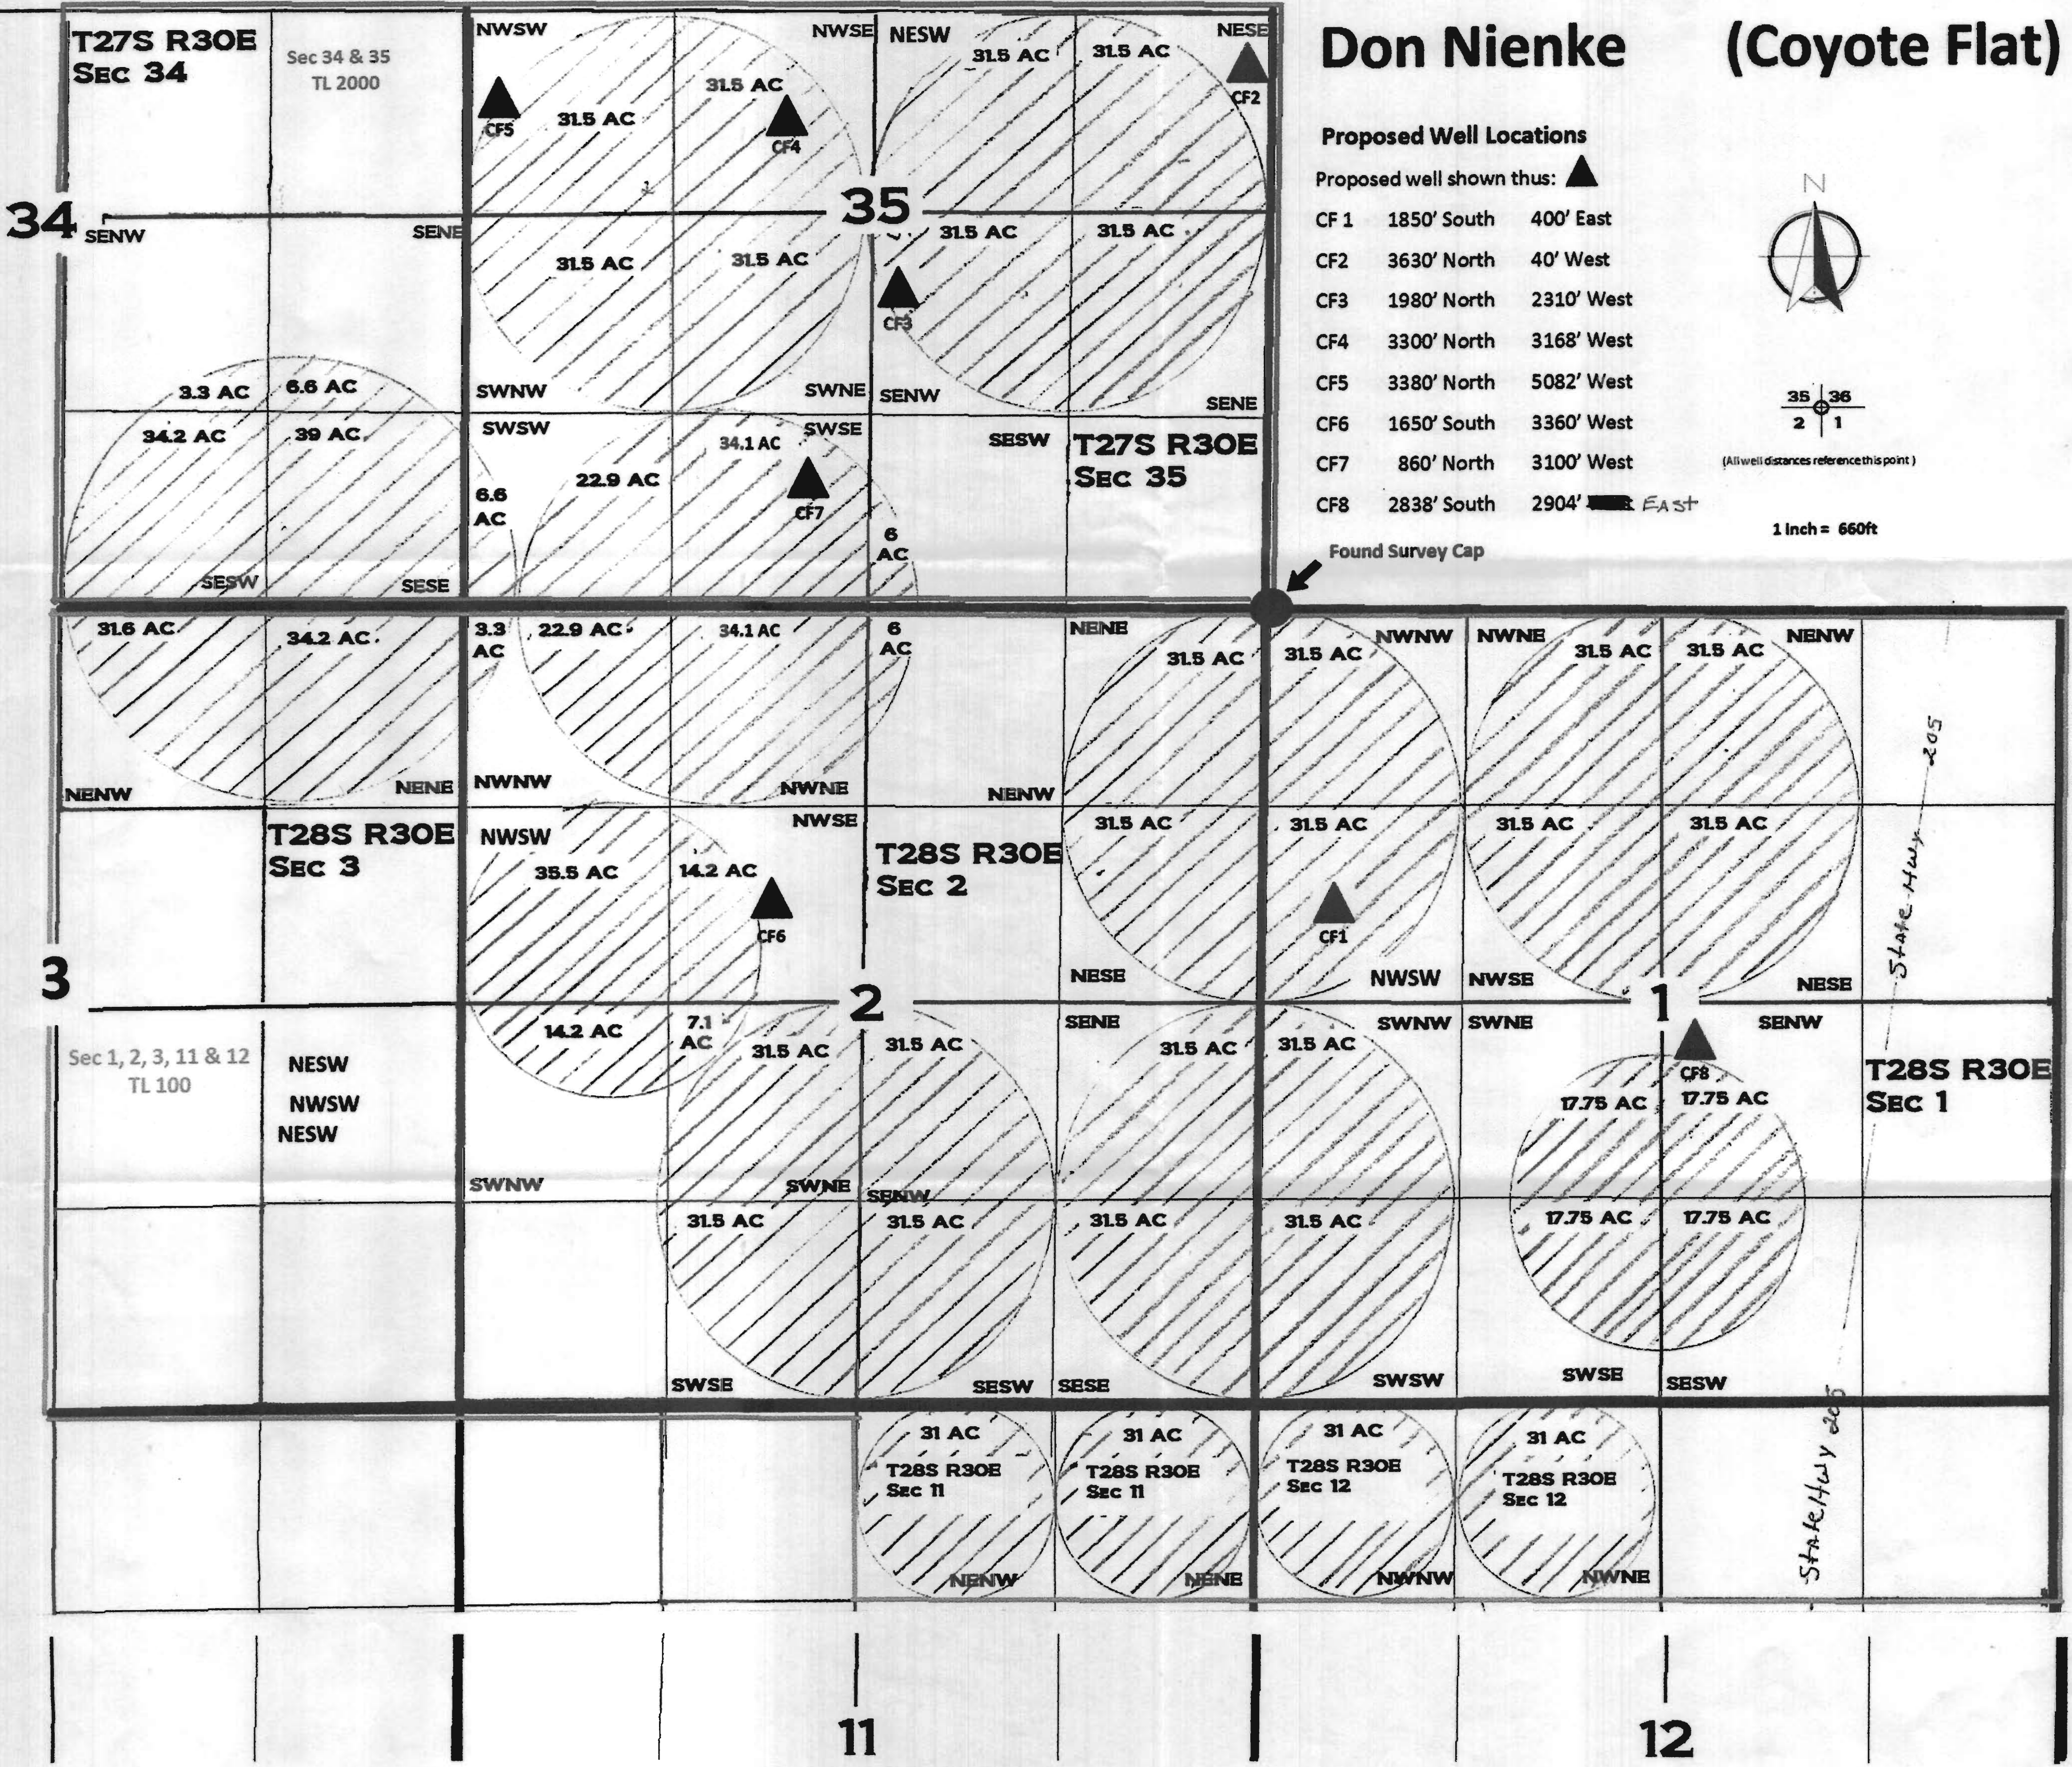

Don Nienke (Coyote Flat)

Proposed Well Locations

Proposed well shown thus: ▲

- | | | |
|------|-------------|------------|
| CF 1 | 1850' South | 400' East |
| CF 2 | 3630' North | 40' West |
| CF 3 | 1980' North | 2310' West |
| CF 4 | 3300' North | 3168' West |
| CF 5 | 3380' North | 5082' West |
| CF 6 | 1650' South | 3360' West |
| CF 7 | 860' North | 3100' West |
| CF 8 | 2838' South | 2904' East |



1 inch = 660ft

RECEIVED

FEB 9 2012

WATER RESOURCES DEPT
SALEM, OREGON

G-7831