


MAP TO ACCOMPANY CLAIM OF BENEFICIAL USE

SECTIONS 17, 18, 19, 20, 21, 28 & 29
TOWNSHIP 35 SOUTH, RANGE 21 EAST, W.M.
LAKE COUNTY, OREGON

APPLICATION NO. R-70484
PERMIT NO. R-11347

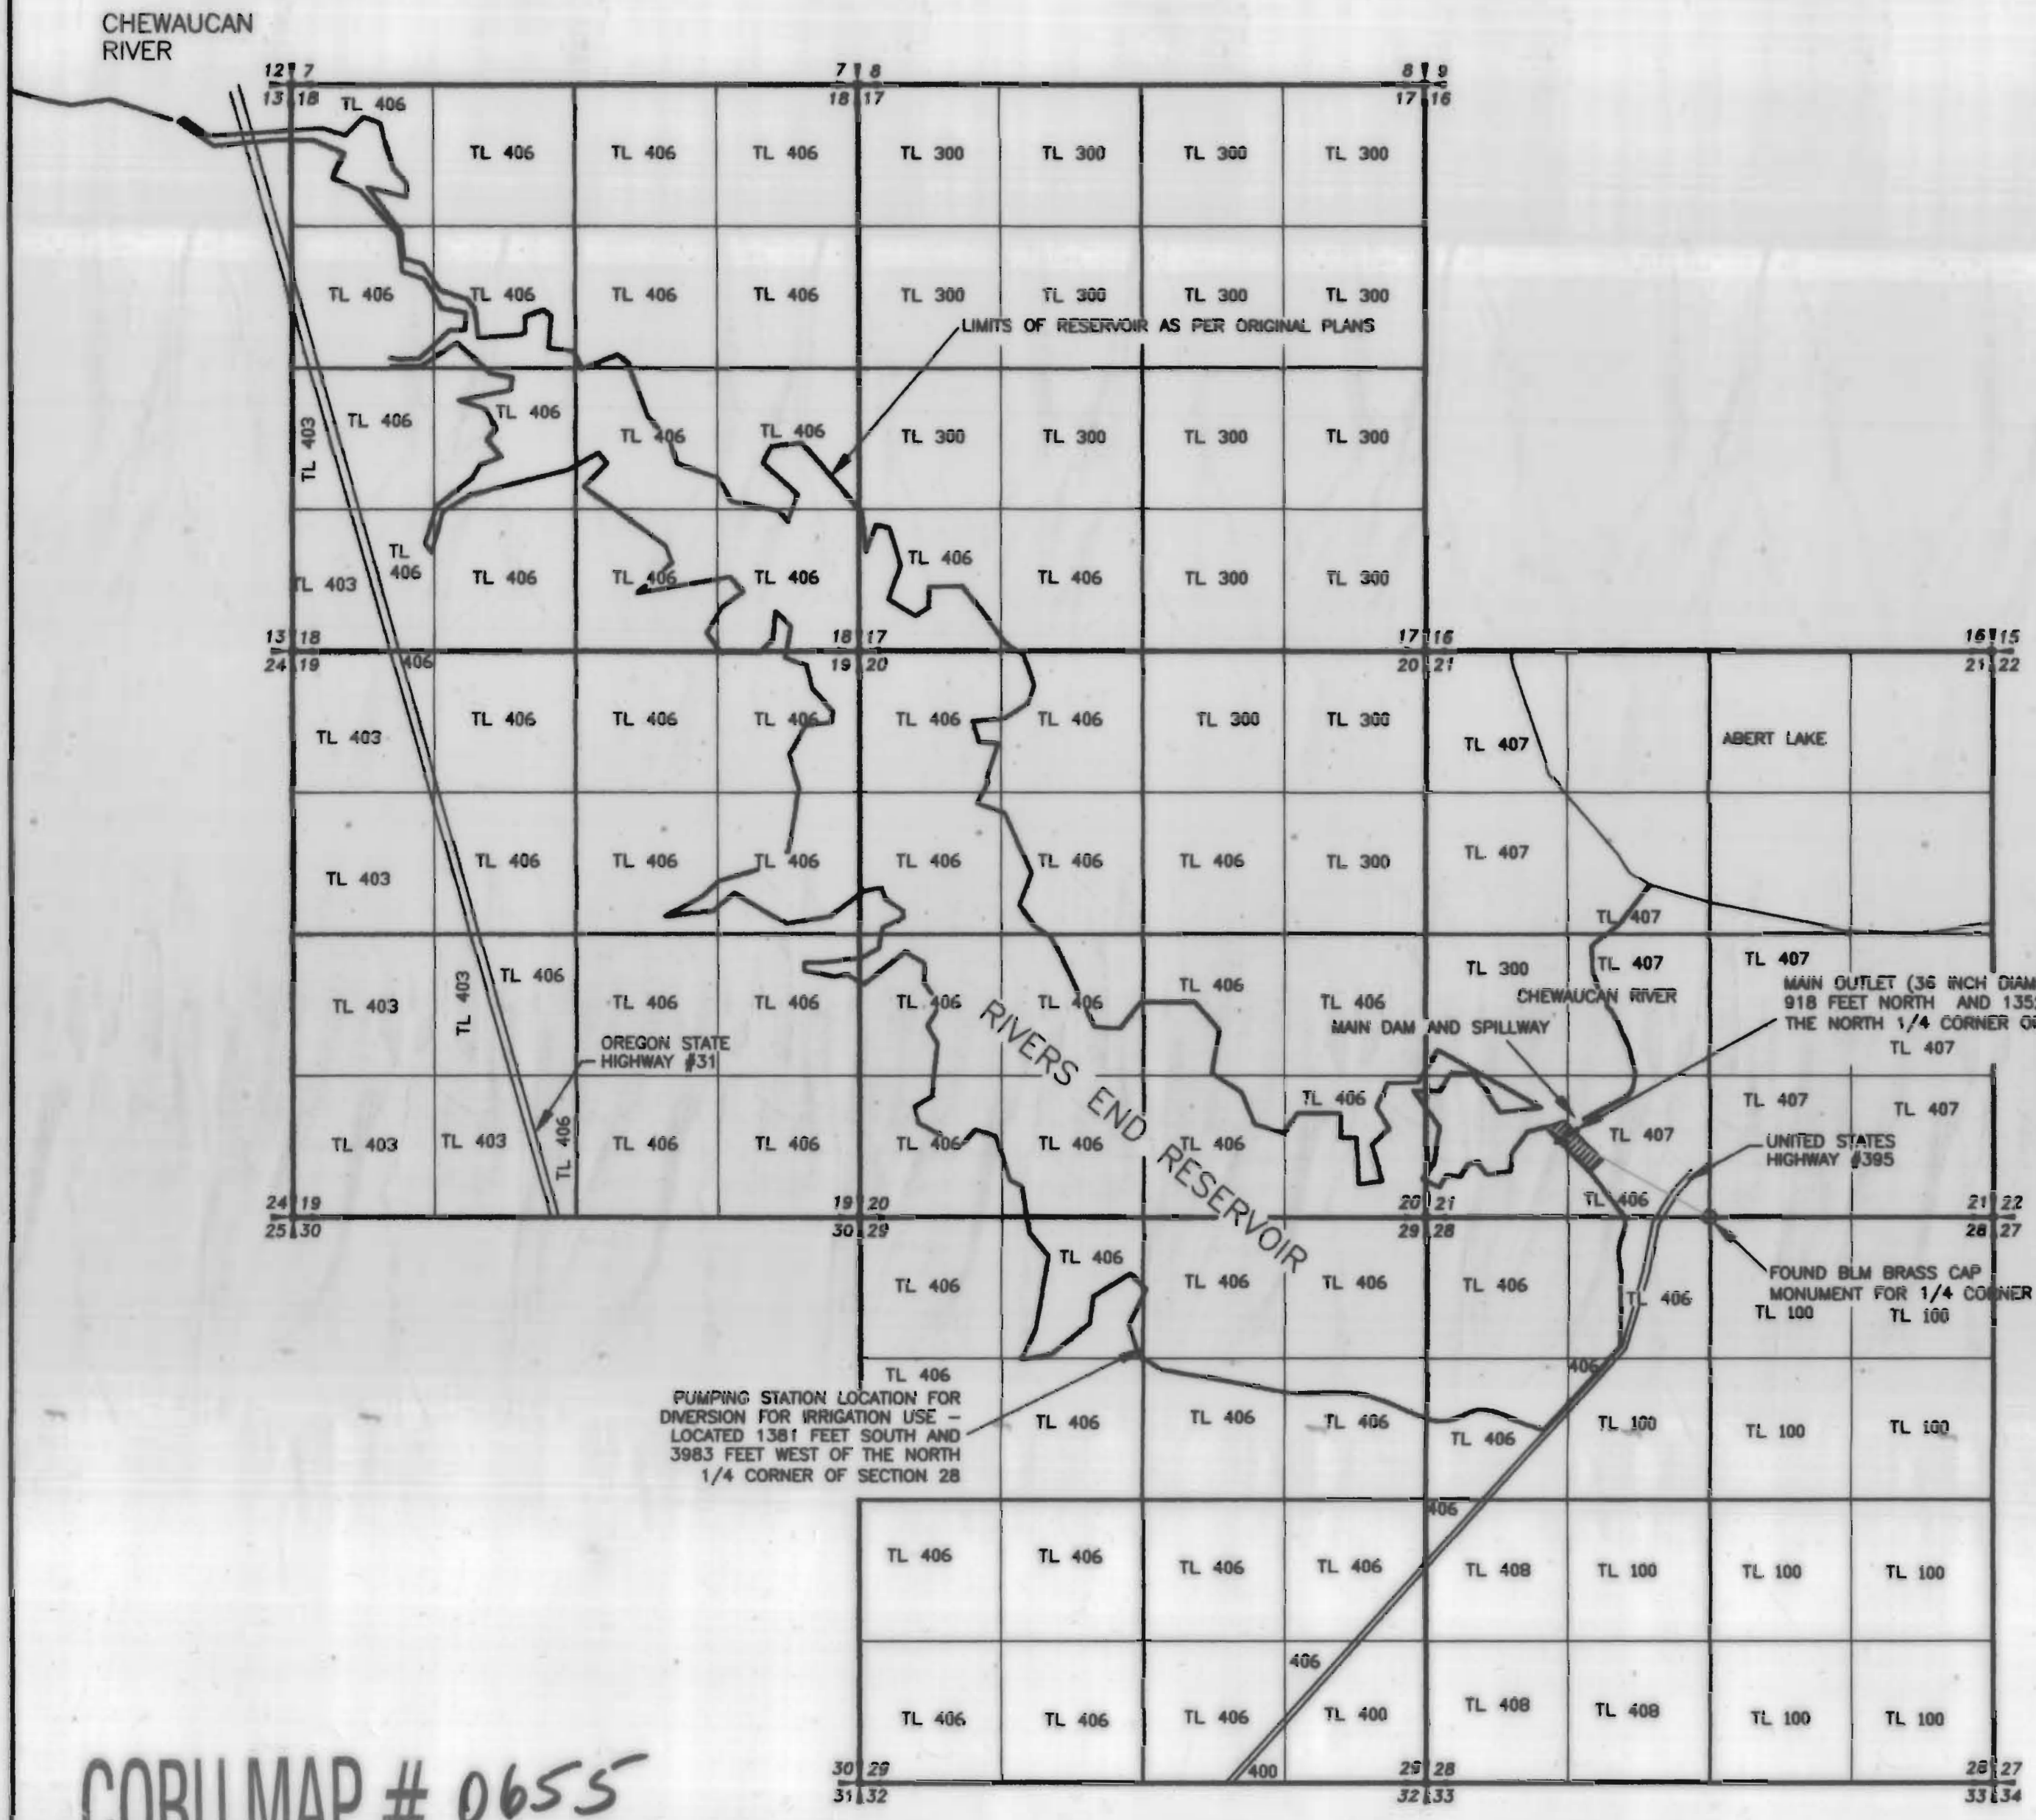


SPILLWAY CREST OF RESERVOIR AT ELEVATION 4280
RESERVOIR CAPACITY 1839 ACRE-FEET
RESERVOIR AREA (FULL) 650 ACRES

CREST ELEVATION VERIFIED IN FIELD
CAPACITY AND AREA AS PER CONSTRUCTION PLANS

RECEIVED
FEB 10 2012
WATER RESOURCES DEPT
SALEM, OREGON

LEGEND

- SECTION LINE
- 1/4 SECTION LINE
- 1/16 SECTION LINE

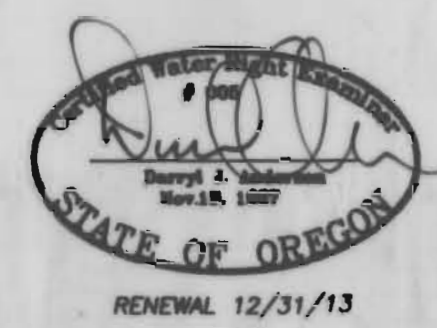

NOTE: PREPARATION OF THIS MAP IS FOR IDENTIFYING PROPOSED WATER RIGHTS ONLY. IT HAS NO INTENT TO PROVIDE LOCATIONS OR DIMENSIONS OF PROPERTY BOUNDARIES.

COBU MAP # 0655

PREPARED FOR:
WAYNE CLARK
68 LEVERONI COURT SUITE 200
NOVATO, CA 94949

PREPARED BY:
ANDERSON ENGINEERING & SURVEYING, INC.
P.O. BOX 28
LAKEVIEW, OREGON 97630
(541) 947-4407
FAX 947-2321

DATE: SEPT 2011 DWG. FILE: 2009-081
JOB NO.: 2009-081 SHEET 1 OF 1