


# T38S R5W

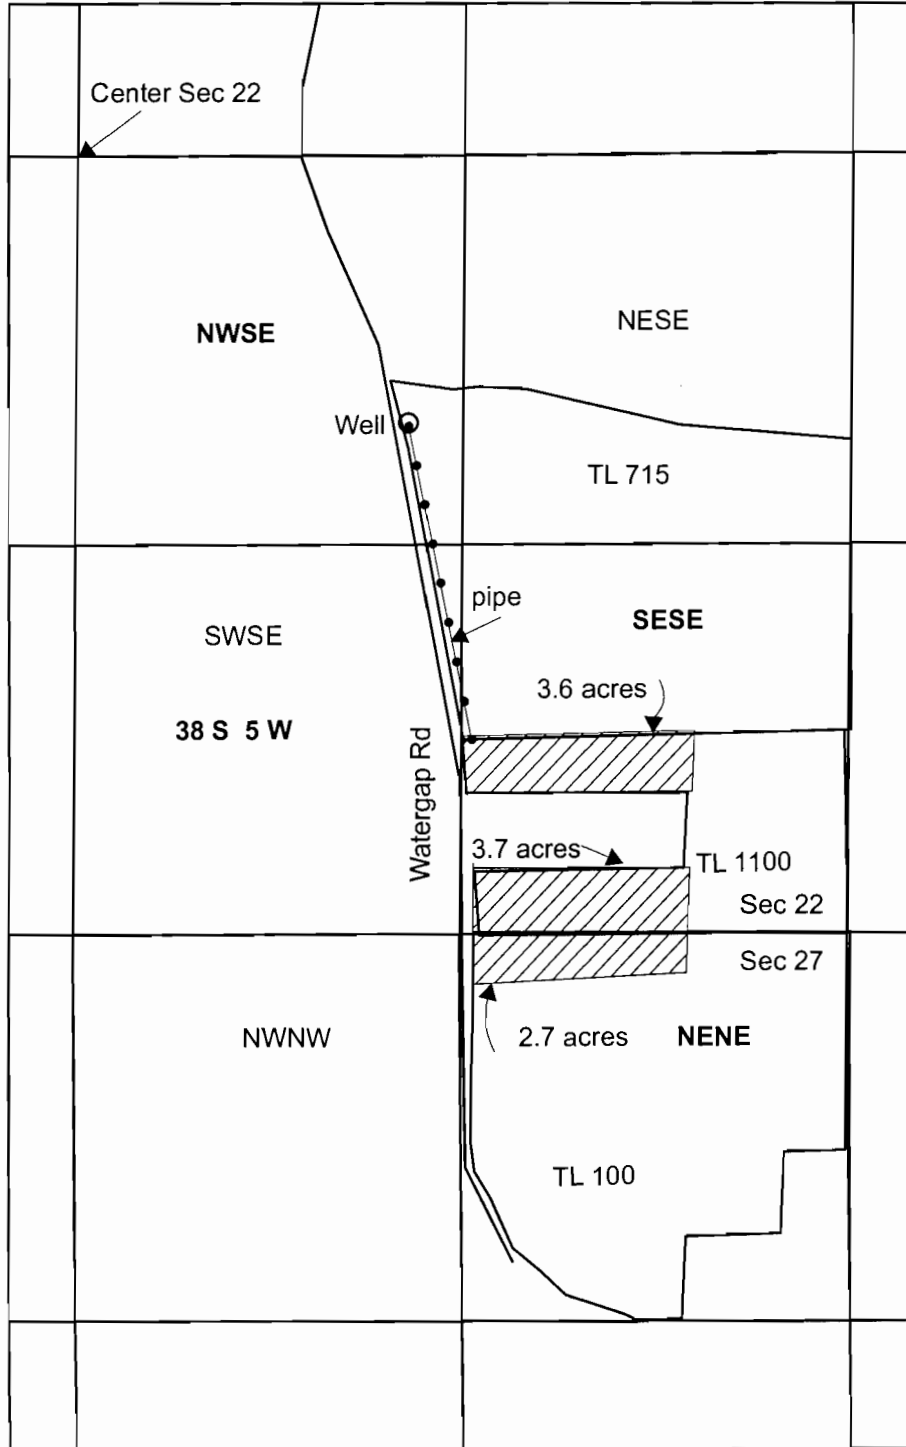

Well is located  
906 ft south  
and 1140 ft east  
from center of Sec 22



1 inch = 660 feet

G-17537

**RECEIVED**

FEB 21 2012

WATER RESOURCES DEPT  
SALEM, OREGON