


Water Right Application Map

T 12 S. R 15 E Section 33 WM

x-MAP made
by District 11
Watermaster, Jeremy
Giffin.

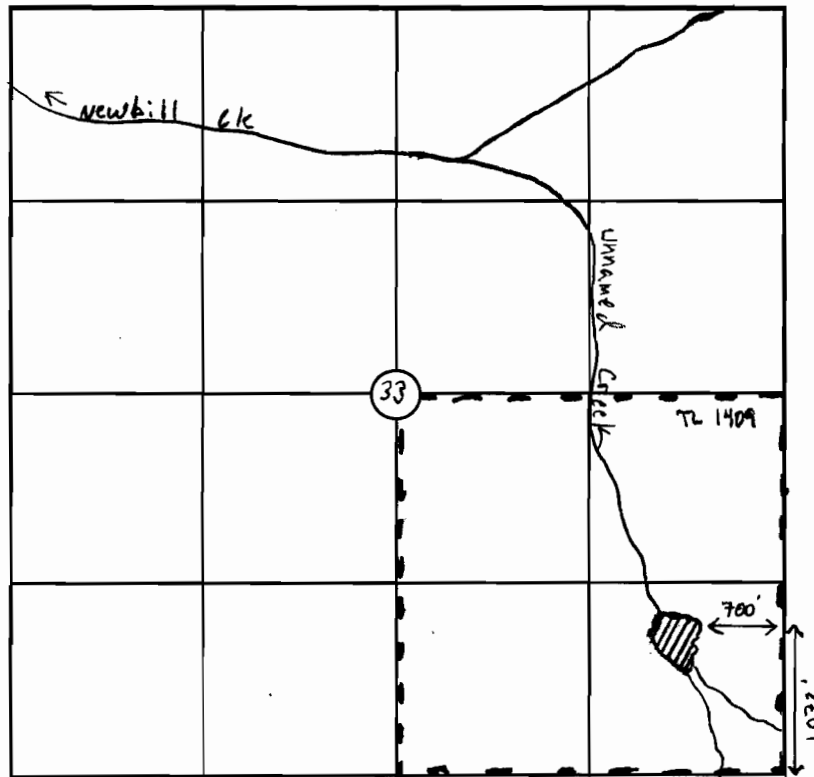

-Area to be
inundated

1 inch = 1320 feet

0 0.125 0.25 0.5
Miles

DAM

~~Well~~ Location: 1,072 Feet (N, S)

and 700 Feet (E, W) of SE Corner
of Section 33, of Township 12 South,
Range 15 East, W.M.

Applicaion Map
IN NAME OF:

Date: _____

Staff Initials: _____

RECEIVED


MAR 28 2012

WATER RESOURCES DEPT
SALEM, OREGON



R-87790

SKETCH OF POND:

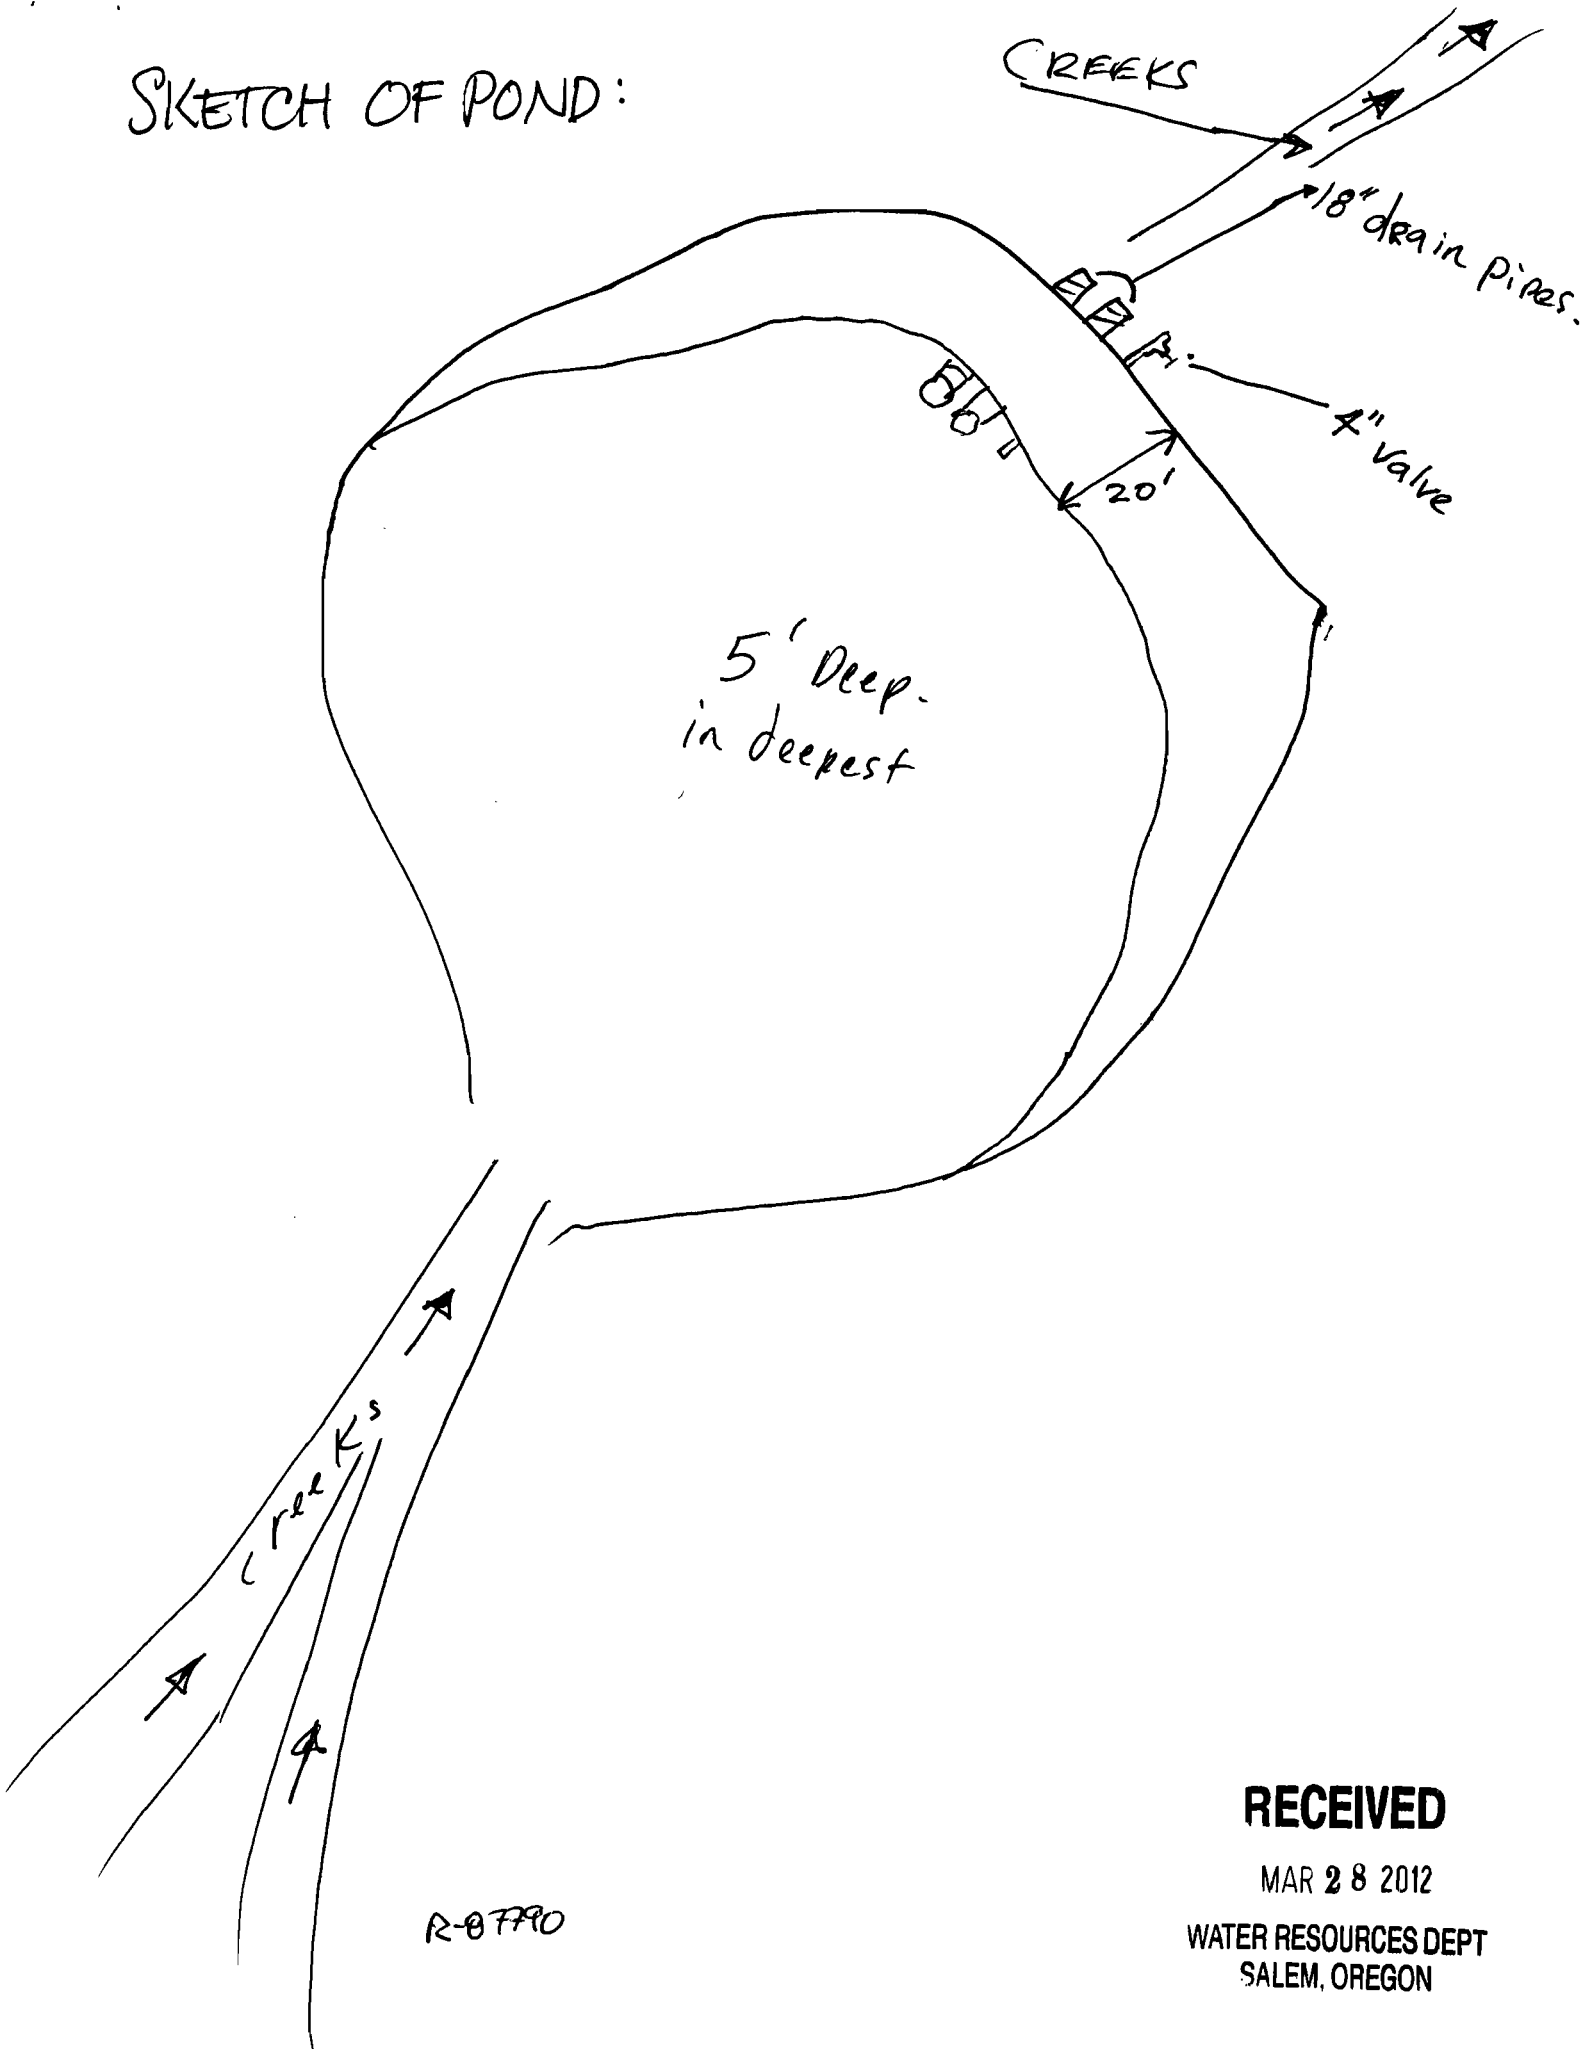


R-07790

RECEIVED

MAR 28 2012

WATER RESOURCES DEPT
SALEM, OREGON

If the diversion involves a dam, use this space for sketches of the diversion (e.g. cross-section of the dam with its dimensions, dimension and placement of outlet pipe, means of passing live flow outside of the authorized storage season, and means for providing fish passage).

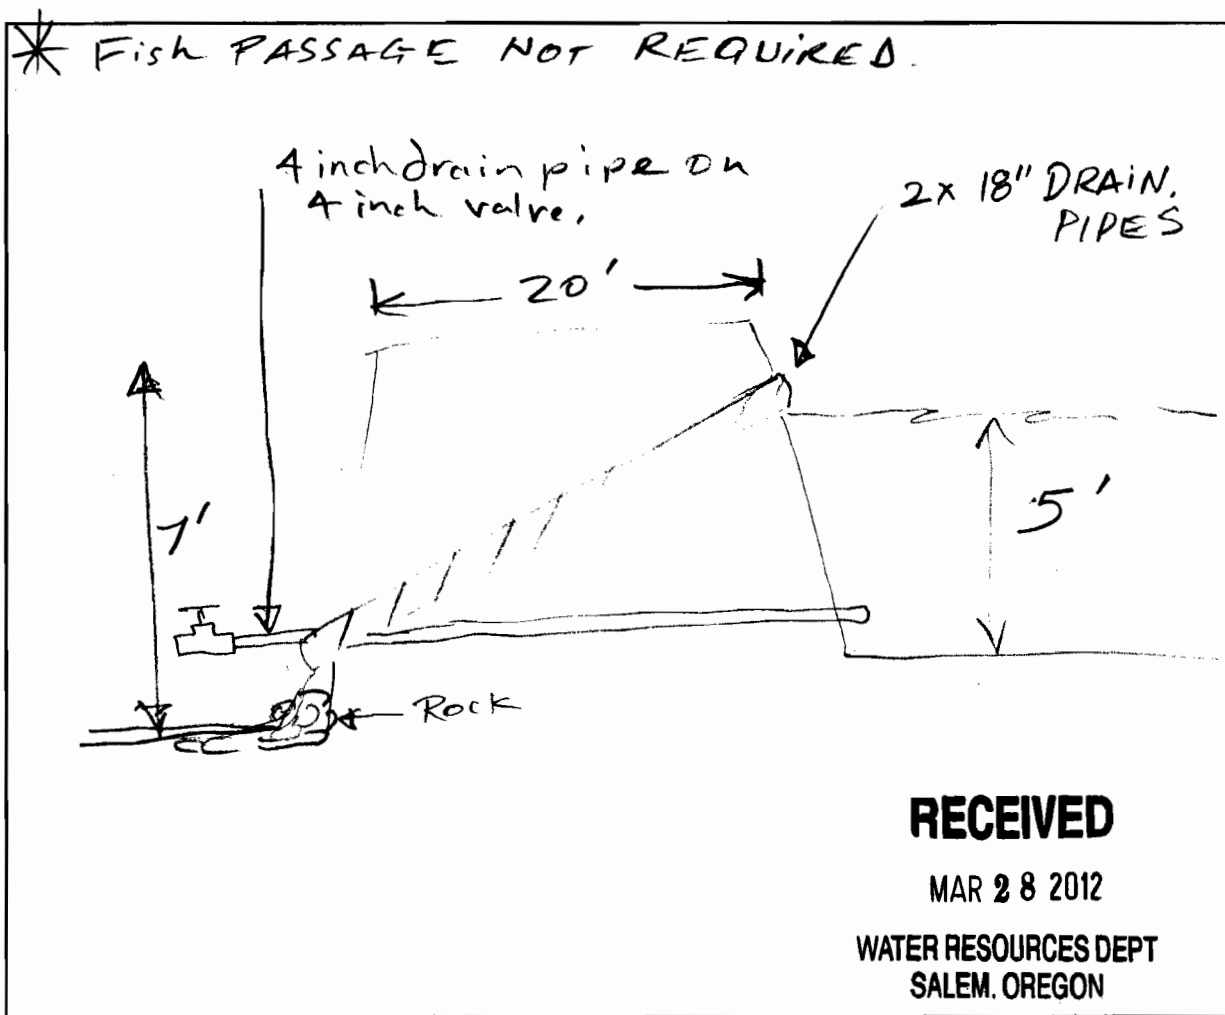

R-87790