



35 2W 14

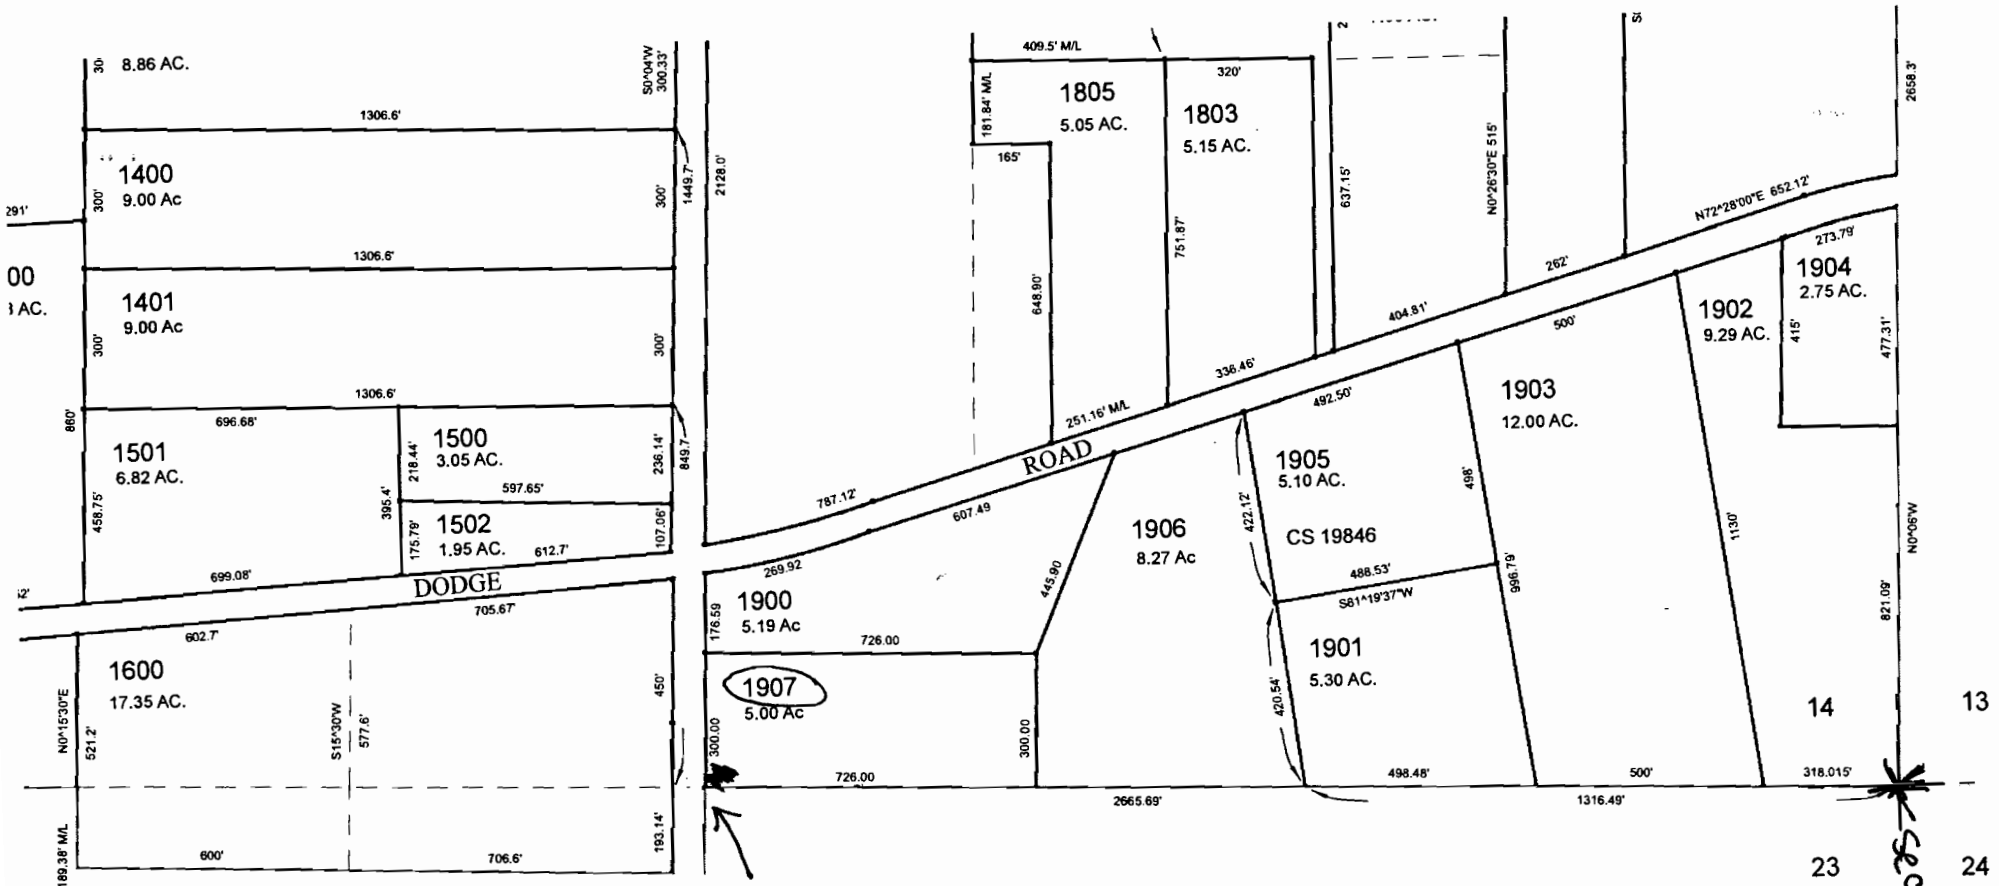

SEE MAP 35 2W 23

2,665.69' East

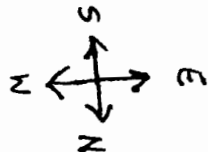

RECEIVED
 APR 12 2012
 WATER RESOURCES DEPT
 SALEM, OREGON

Section Corner


1342-9-2

RECEIVED

APR 1 2012

WATER RESOURCES DEPT
SALEM, OREGON

35 2W 14

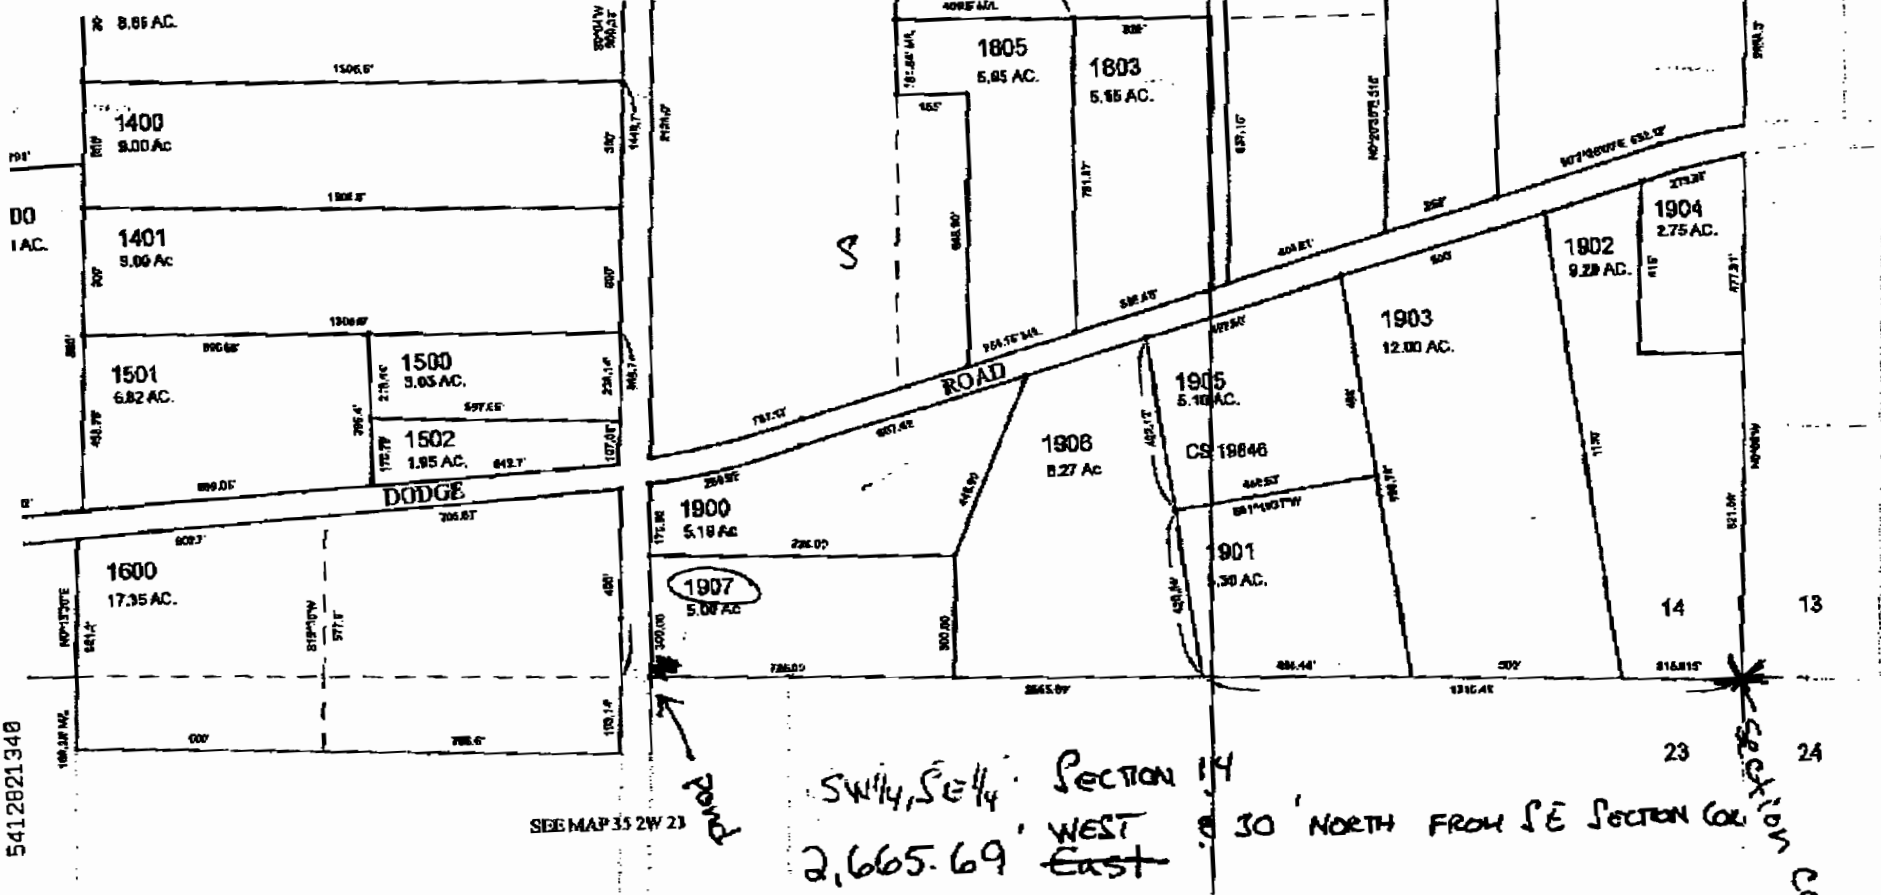

R-877A

JACKSON COUNTY

INFORMATION TECHNOLOGY

Map Maker Application

Front Counter Legend

Tax Lot Outlines

Tax Lot Outlines (orange color for Aerial)

Tax Lot Numbers

Section Outlines

Assessment Maintenance Areas

1

2

3

4N

4S

5

6

Public Lands by Agency

BLM

BUREAU OF RECLAMATION

CITY

CORPS OF ENGINEERS

COUNTY

CRATER LAKE NATIONAL PARK

IRRIGATION DISTRICTS

OTHER FEDERAL

REGIONAL

STATE

USFS

RECEIVED

APR 12 2012

WATER RESOURCES DEPT
SALEM, OREGON

359
2W
SECTION 14

RECEIVED

MAY 18 2011

WATER RESOURCES DEPT
SALEM, OREGON




JACKSON COUNTY
Oregon

This map is based on a digital database compiled by Jackson County from a variety of sources. Jackson County cannot accept responsibility for errors, omissions, or positional accuracy. There are no warranties, expressed or implied.

800

269ft

Created with MapMaker Map created on 2/11/2011 10:23:31 AM using web.jacksoncounty.org

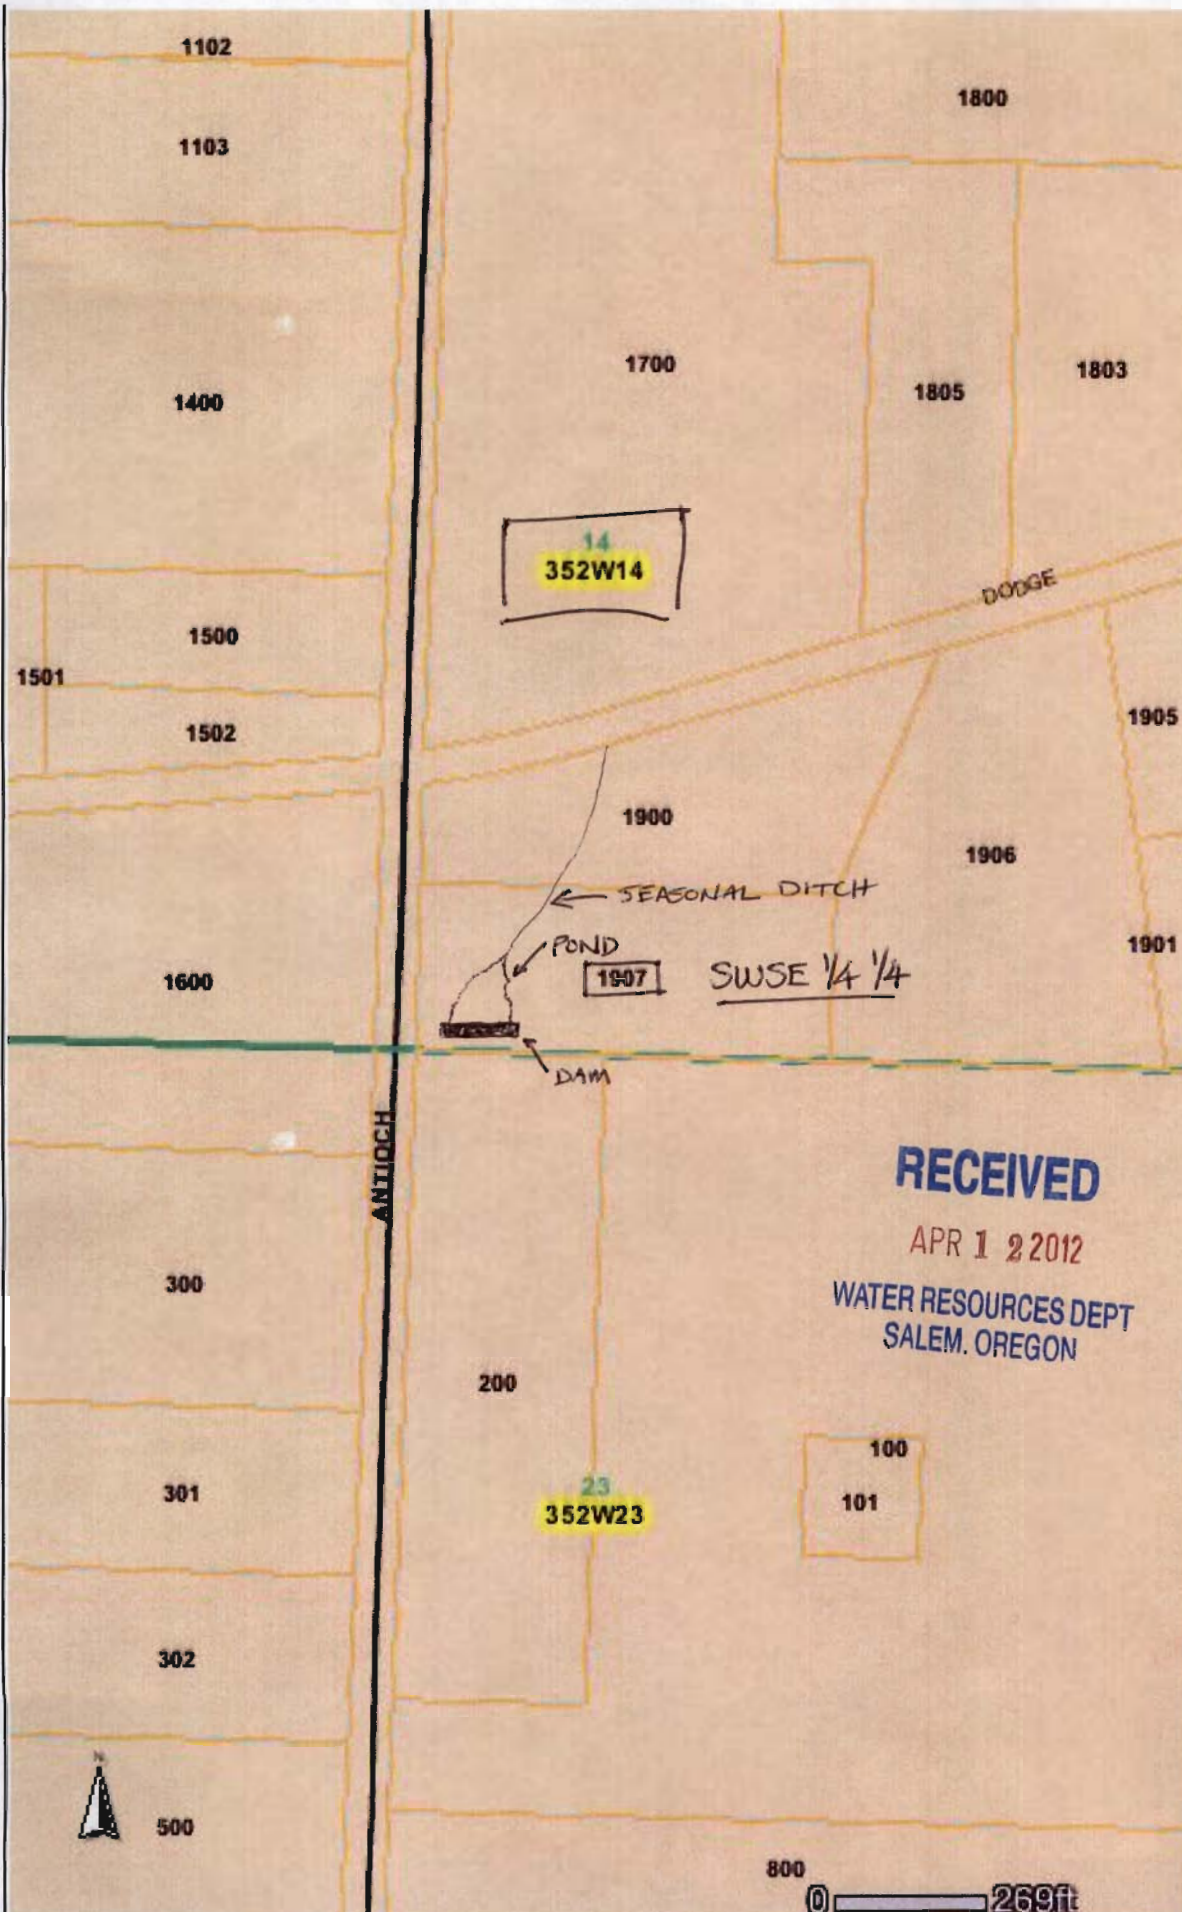

JACKSON COUNTY

INFORMATION TECHNOLOGY

Map Maker Application

Front Counter Legend

- Tax Lot Outlines
- Tax Lot Outlines (orange color for Aerial)
- Section Outlines
- Assessment Maintenance Areas
- 1
- 2
- 3
- 4N
- 4S
- 5
- 6
- Public Lands by Agency

- BLM
- BUREAU OF RECLAMATION
- CITY
- CORPS OF ENGINEERS
- COUNTY
- CRATER LAKE NATIONAL PARK
- IRRIGATION DISTRICTS
- OTHER FEDERAL
- REGIONAL
- STATE
- USFS

35S
2W
SECTION 14

RECEIVED

MAY 18 2011

WATER RESOURCES DEPT
SALEM, OREGON



JACKSON COUNTY
Oregon

This map is based on a digital database compiled by Jackson County From a variety of sources. Jackson County cannot accept responsibility for errors, omissions, or positional accuracy. There are no warranties, expressed or implied.

Created with MapMaker

Map created on 2/11/2011 9:39:45 AM using web.jacksoncounty.org



RECEIVED

APR 12 2012

WATER RESOURCES DEPT
SALEM, OREGON

352W25

1079ft

R-87797