

THIS MAP WAS PREPARED FOR
ASSESSMENT PURPOSE ONLY


SECTION 25 T.08S. R.38E. W.M.
BAKER COUNTY

1"=400'

Application Map
IN the Name of Richard Haines


08S 38E 25
& INDEX

SEE MAP 08S 38E 24

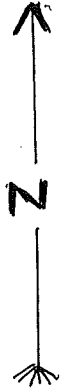

24

19

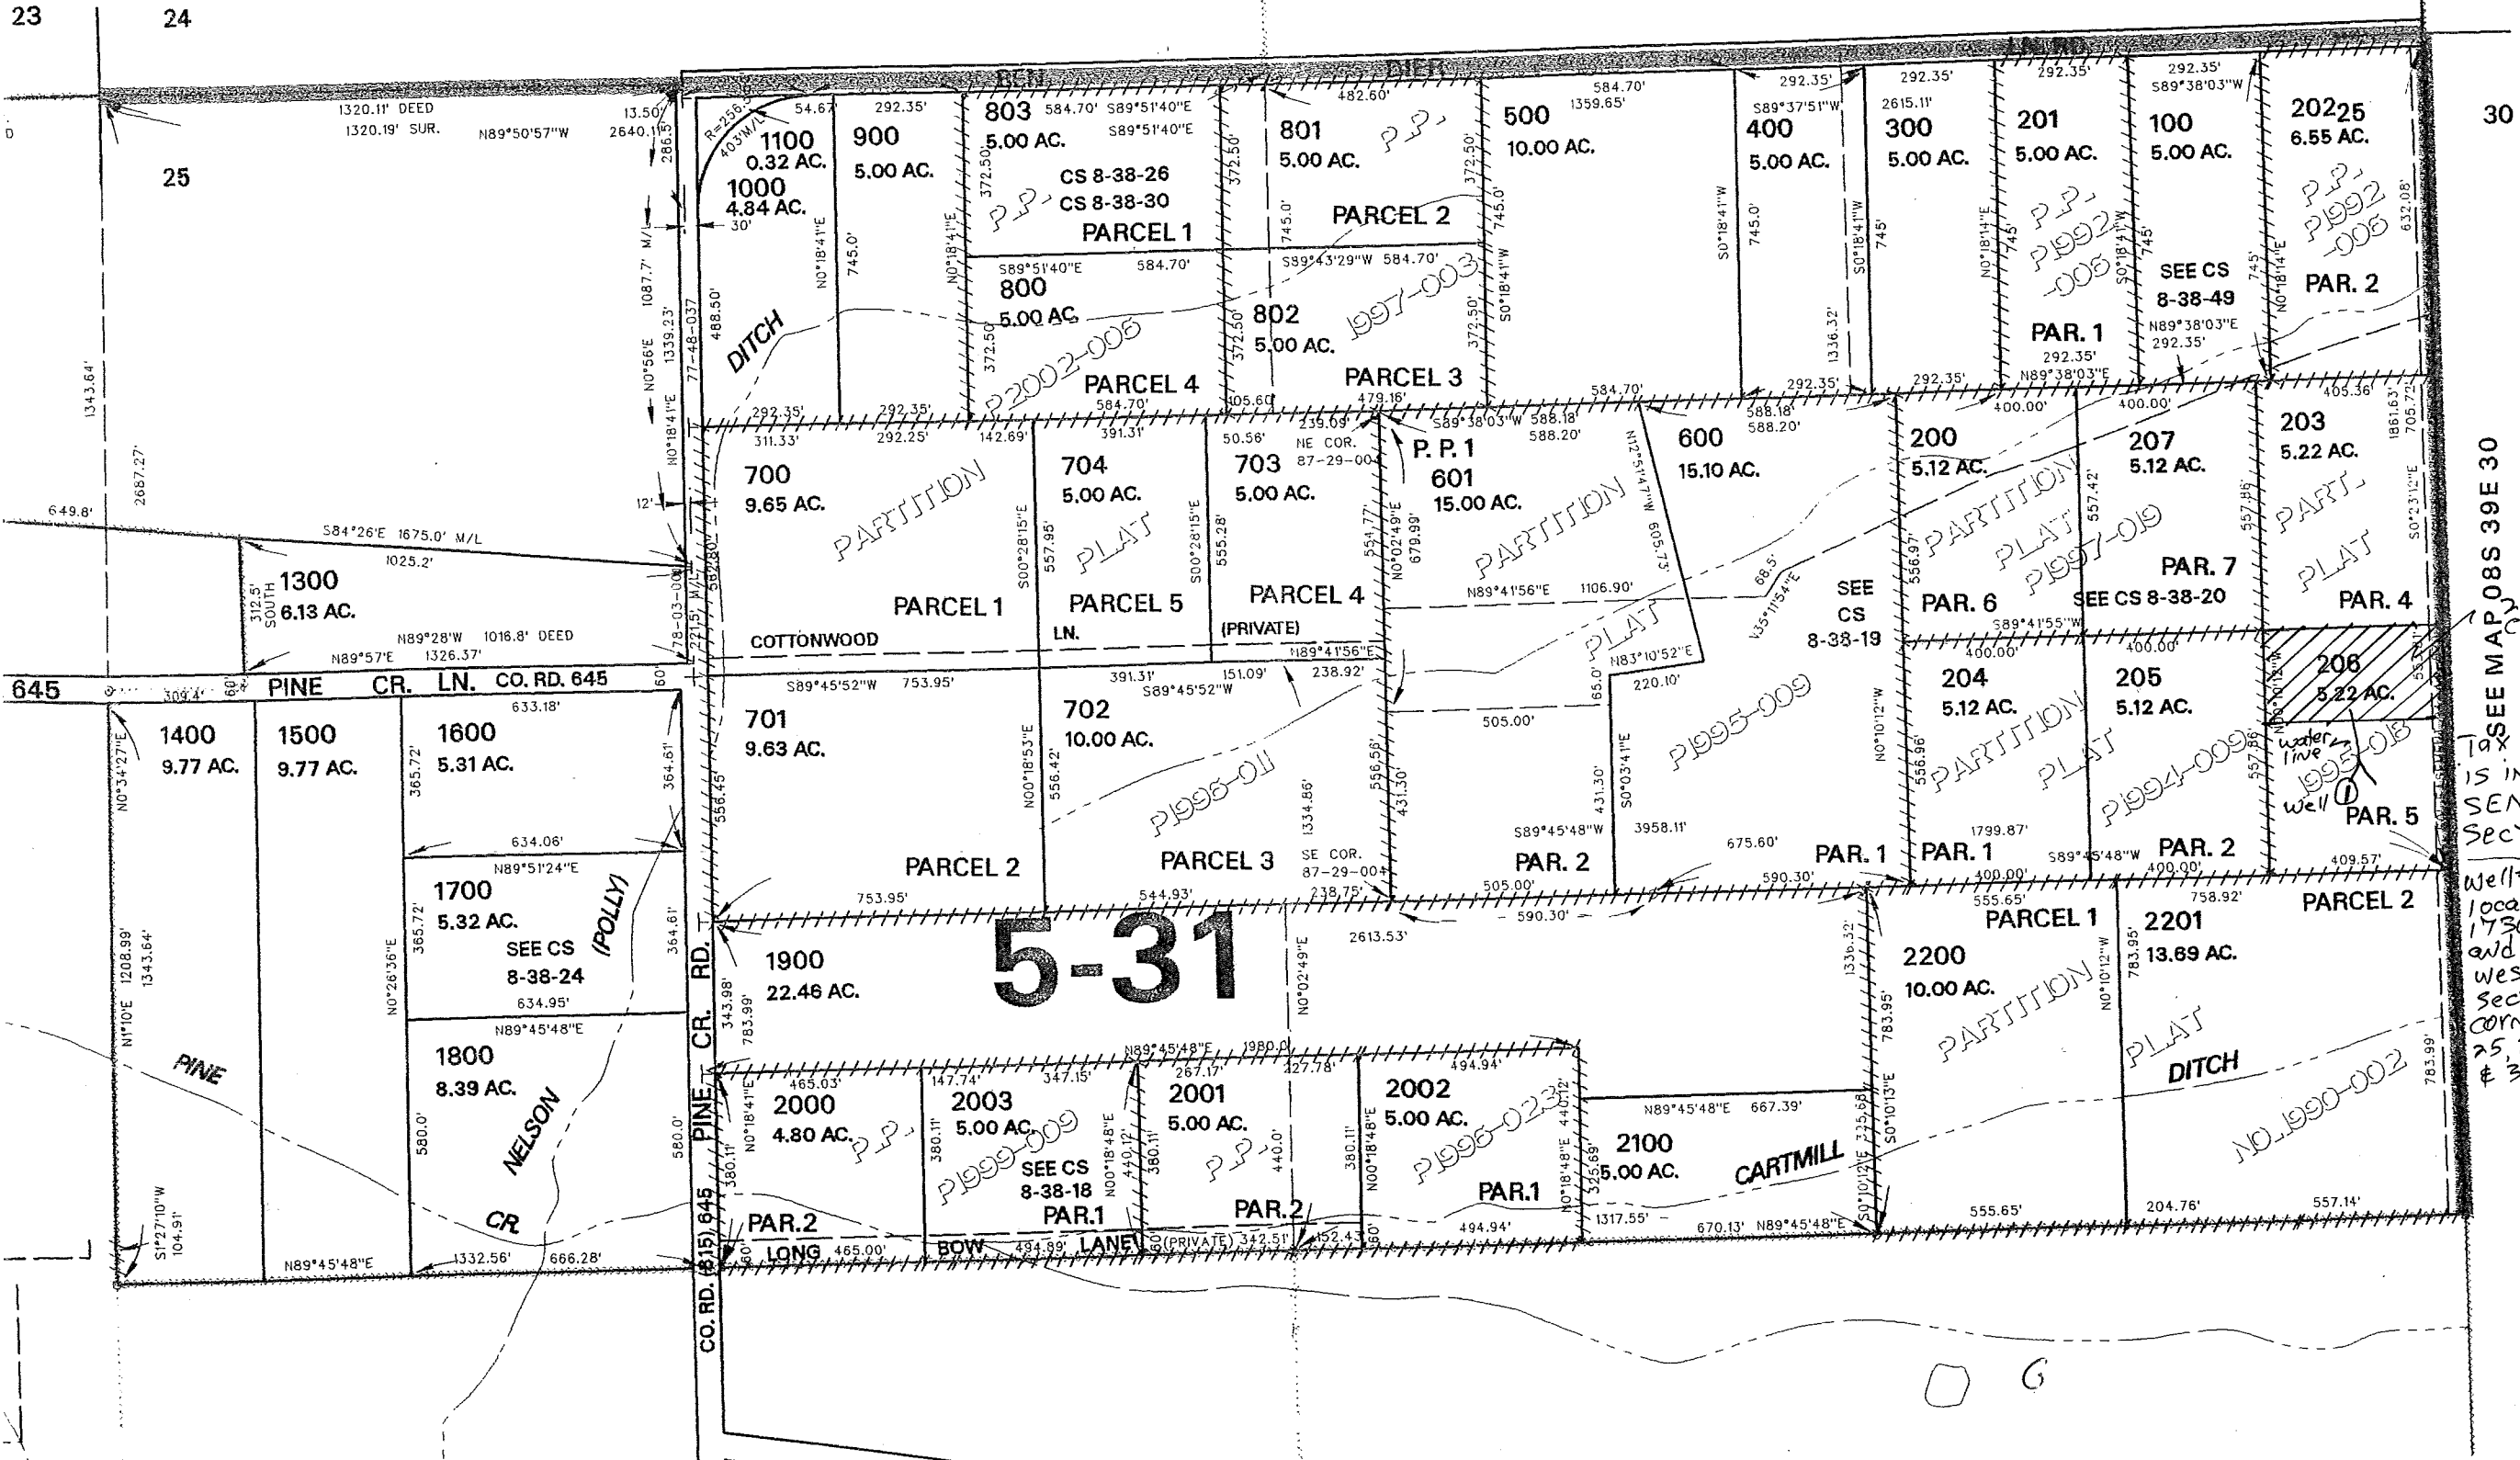

SEE MAP 08S 39E 30
Tax Lot 206
is in the
SENE of
Section 25
Well #1 is
located
1730' south
and 225'
west of
section
corner
25.2419
& 30.

RECEIVED

APR 09 2012

WATER RESOURCES DEPT
SALEM, OREGON

RECEIVED

MAR 19 2012

WATER RESOURCES DEPT
SALEM, OREGON